

CONTRACTOR'S SUBMITTAL TRANSMITTAL

5ND LANTDIV 4-4355/3 (Rev. 6/76)

40/2
02

Full

FROM CONTRACTOR	CONTRACT NO. 81-C-1766	TRANSMITTAL NO. 86	DATE May 22, 1984
TO Trader Construction Company	PROJECT TITLE AND LOCATION Public Works MCB Camp Lejeune, N.C.		
Lockwood Greene/Six Associates			

CONTRACTOR USE ONLY

*List only one specification division per form.

List only one of the following categories on each transmittal form, and indicate which is being submitted

- Contractor Approved
 OICC Approval
 Deviation/Substitution For OICC Approval

REVIEWER USE ONLY

**ACTION CODES

- A-Approved
- D-Disapproved
- AN-Approved as noted
- RA-Receipt acknowledged.
- C-Comments
- R-Resubmit

ITEM NO.	PROJ. SPEC. SECT. & PARA. and/or PROJ. DWG. NO. *	ITEM IDENTIFICATION (Type, size, model no., Mfg. name, dwg. or brochure number)	NO. OF COPIES	ACTION CODES **	REVIEWER'S INITIALS CODE AND DATE
152	10801	Metal Toilet & Bath Accessories			
		Catalog Data: Stainless Steel Frame Mirror	7	AN/C	A.B. 1 June 84
		Surface Mtd. S.S. Paper towel dispenser	7	A	
		Grab Bar	7	A	
		Stainless Steel Shelf	7	A	
		Surface Mounted Toilet Tissue Holder	7	A	

CONTRACTOR'S COMMENTS

Copy Filed 6-12-84


COPY OF TRANSMITTAL AND SUBMITTALS TO ROICC		CONTRACTOR REPRESENTATIVE (Signature)	
ROICC, Camp Lejeune, N.C.		Dale Stallings	
DATE RECEIVED BY REVIEWER	FROM (Reviewer)	TO	
5/24/84	Six Associates, Inc.	Trader Construction Co.	

- Submittals are returned with action indicated. Approval of an item does not include approval of any deviation from the contract requirements unless the contractor calls attention to and supports the deviation.
- Submittals are forwarded to LANTDIV with A-E recommendations indicated in REVIEWER USE ONLY Section and in comments below on ONE COPY of the transmittal form.

REVIEWER'S COMMENTS

- 1) Shelf does not comply with specifications regarding coved bottom.
- 2) Shelf thickness shall be .050 inch (18 ga.).

COPIES TO: ROICC (2) LANTDIV (1) A-E (1)	DATE 6/4/84	SIGNATURE A.B. Goh
---	----------------	-----------------------

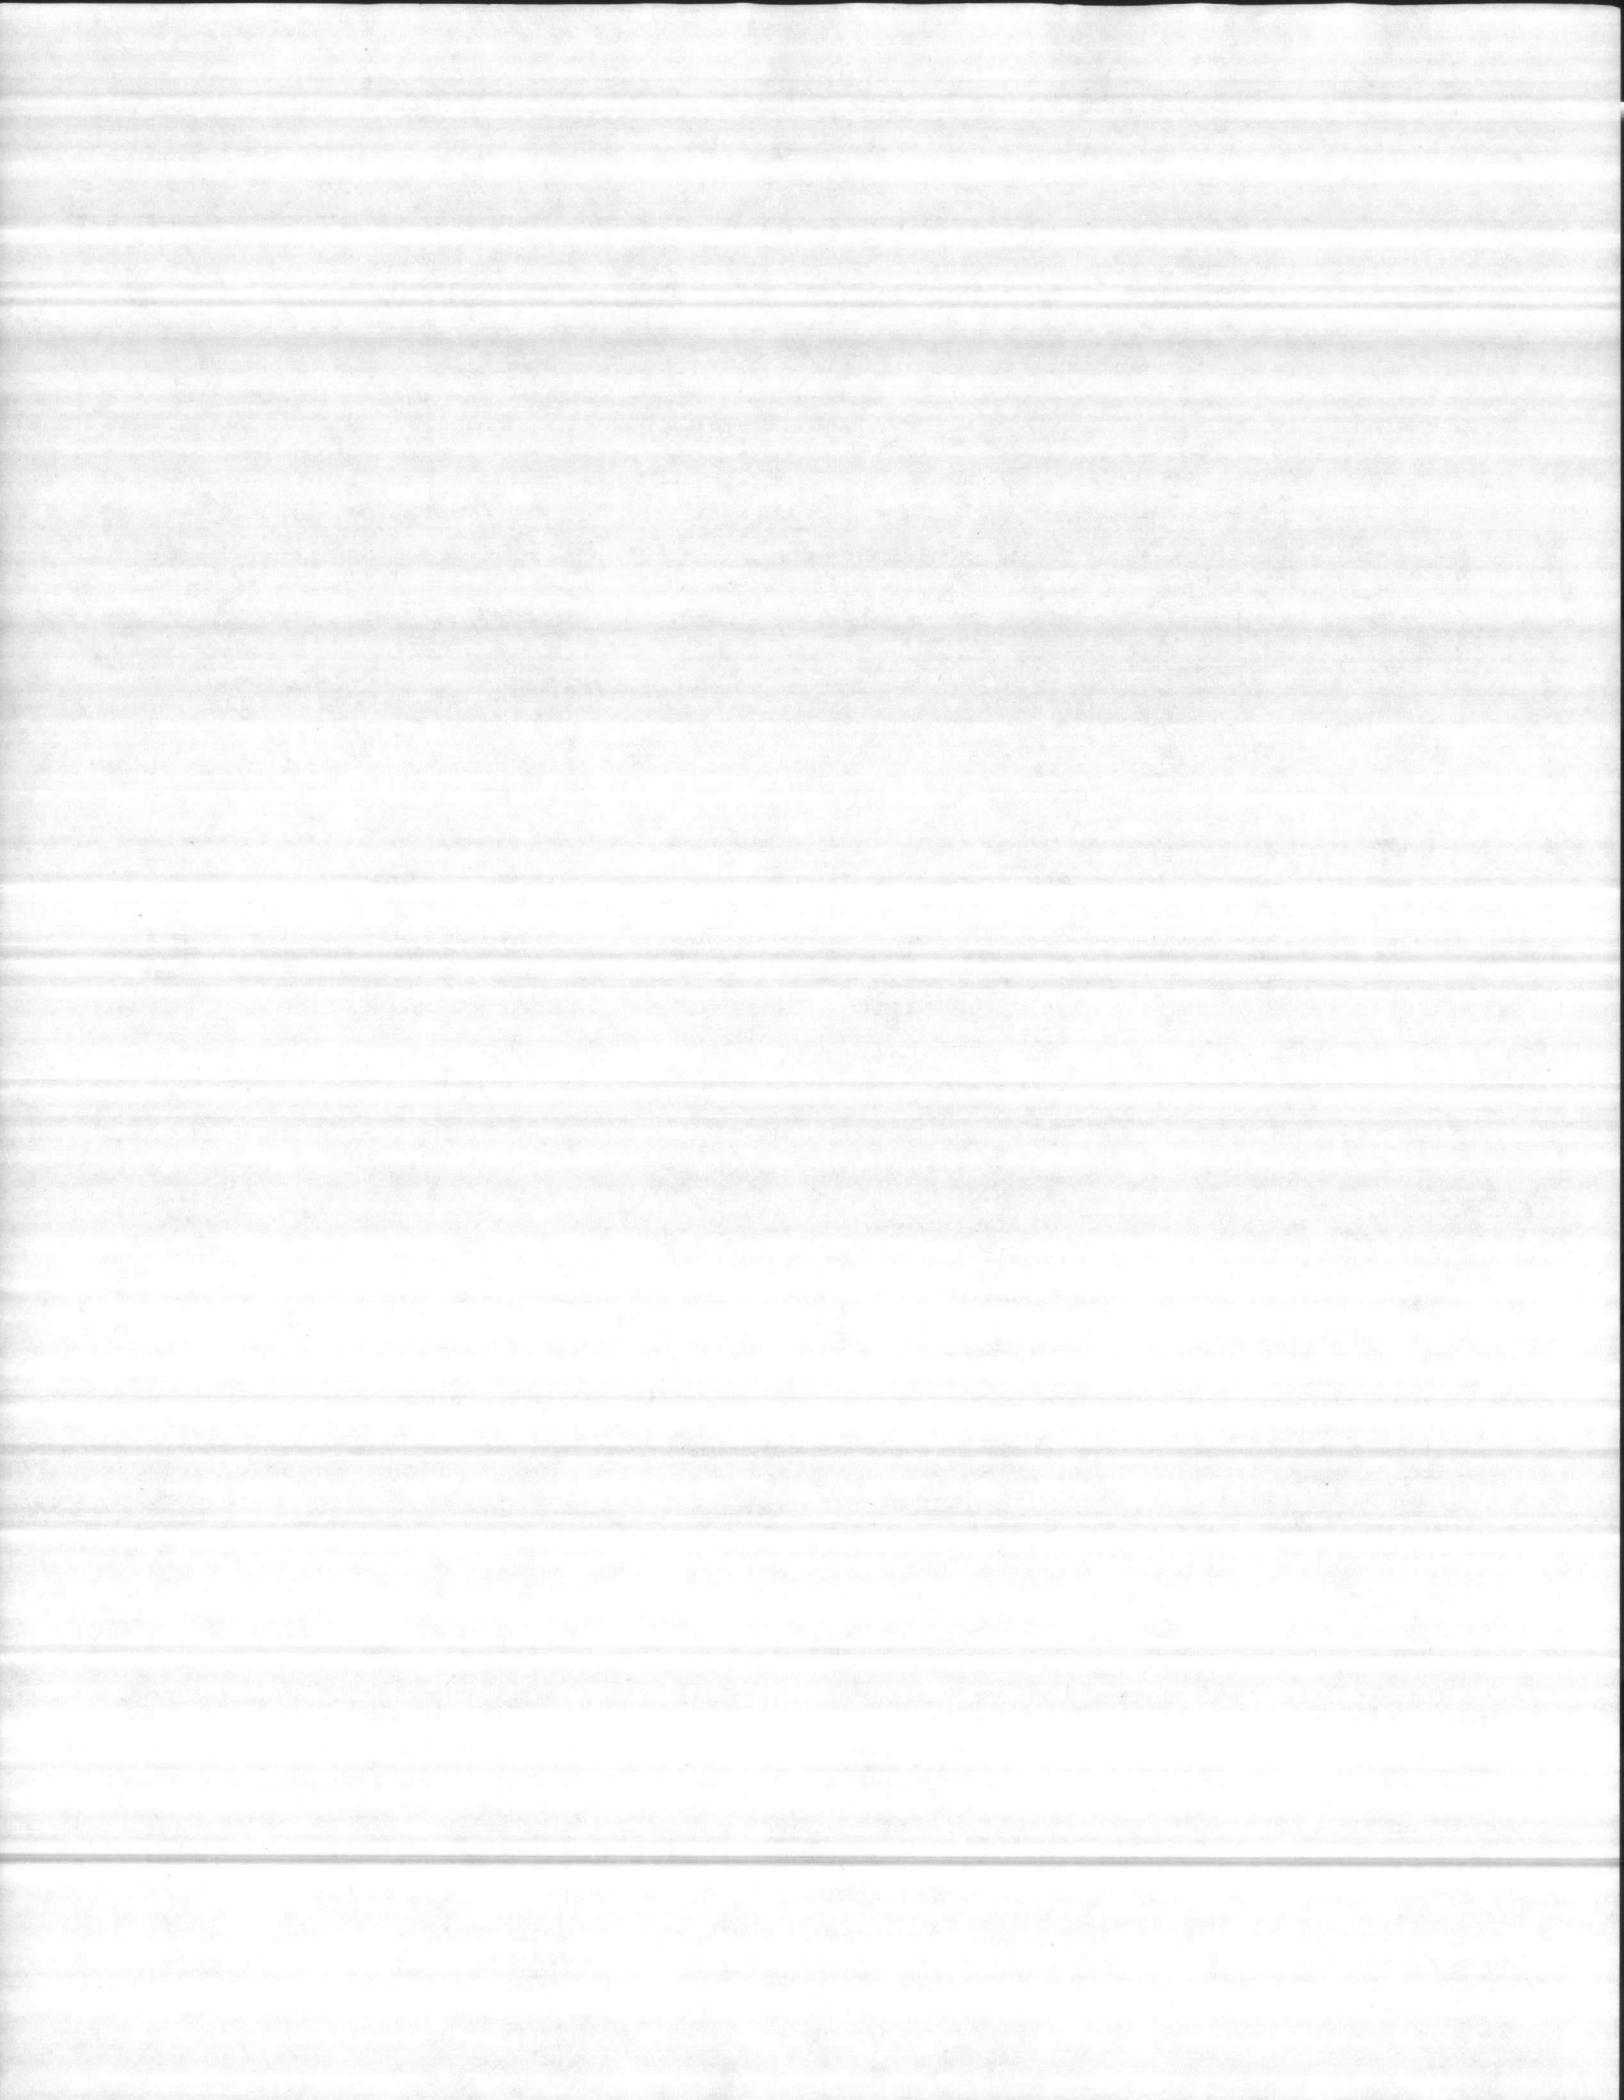

CONTRACTOR'S SUBMITTAL TRANSMITTAL

5ND LANTDIV 4-4355/3 (Rev. 6/76)

CONTRACT NO. 81-C-1766		TRANSMITTAL NO. 86	DATE May 22, 1984
FROM CONTRACTOR Trader Construction Company		PROJECT TITLE AND LOCATION Public Works MCB Camp Lejeune N. C.	
TO Lockwood Greene/Six Associates			

CONTRACTOR USE ONLY

*List only one specification division per form.

List only one of the following categories on each transmittal form, and indicate which is being submitted

- Contractor Approved
 OICC Approval
 Deviation/Substitution For OICC Approval

REVIEWER USE ONLY

****ACTION CODES**

- A-Approved
- D-Disapproved
- AN-Approved as noted
- RA-Receipt acknowledged.
- C-Comments
- R-Resubmit

ITEM NO	PROJ. SPEC. SECT. & PARA. and/or PROJ. DWG. NO. *	ITEM IDENTIFICATION (Type, size, model no., Mfg. name, dwg. or brochure number)	NO. OF COPIES	ACTION CODES **	REVIEWER'S INITIALS CODE AND DATE
152	10801	(continued)			
		Catalog Data: Recessed paper towel dispenser	7	A	A.B. (Quincy)
		Napkin Tampon Dispenser	7	A	
		Sanitary napkin disposal and shelf	7	A	
		Double Robe hook	7	A	
		Powder soap dispenser	7	A	

CONTRACTOR'S COMMENTS

Copy Filed 6-12-84

COPY OF TRANSMITTAL AND SUBMITTALS TO ROICC ROICC, Camp Lejeune, N.C.		CONTRACTOR REPRESENTATIVE (Signature) Dale Stallings	
DATE RECEIVED BY REVIEWER 5/24/84	FROM (Reviewer) Six Associates, Inc.	TO Trader Construction Co.	


- Submittals are returned with action indicated. Approval of an item does not include approval of any deviation from the contract requirements unless the contractor calls attention to and supports the deviation.
- Submittals are forwarded to LANTDIV with A-E recommendations indicated in REVIEWER USE ONLY Section and in comments below on ONE COPY of the transmittal form.

REVIEWER'S COMMENTS

See Reviewer's Comments on Page 1 of 3

RECEIVED
MAY 25 1984
LANTDIV

COPIES TO: ROICC (2) LANTDIV (1) A-E (1)	DATE 6/4/84	SIGNATURE
---	----------------	-----------

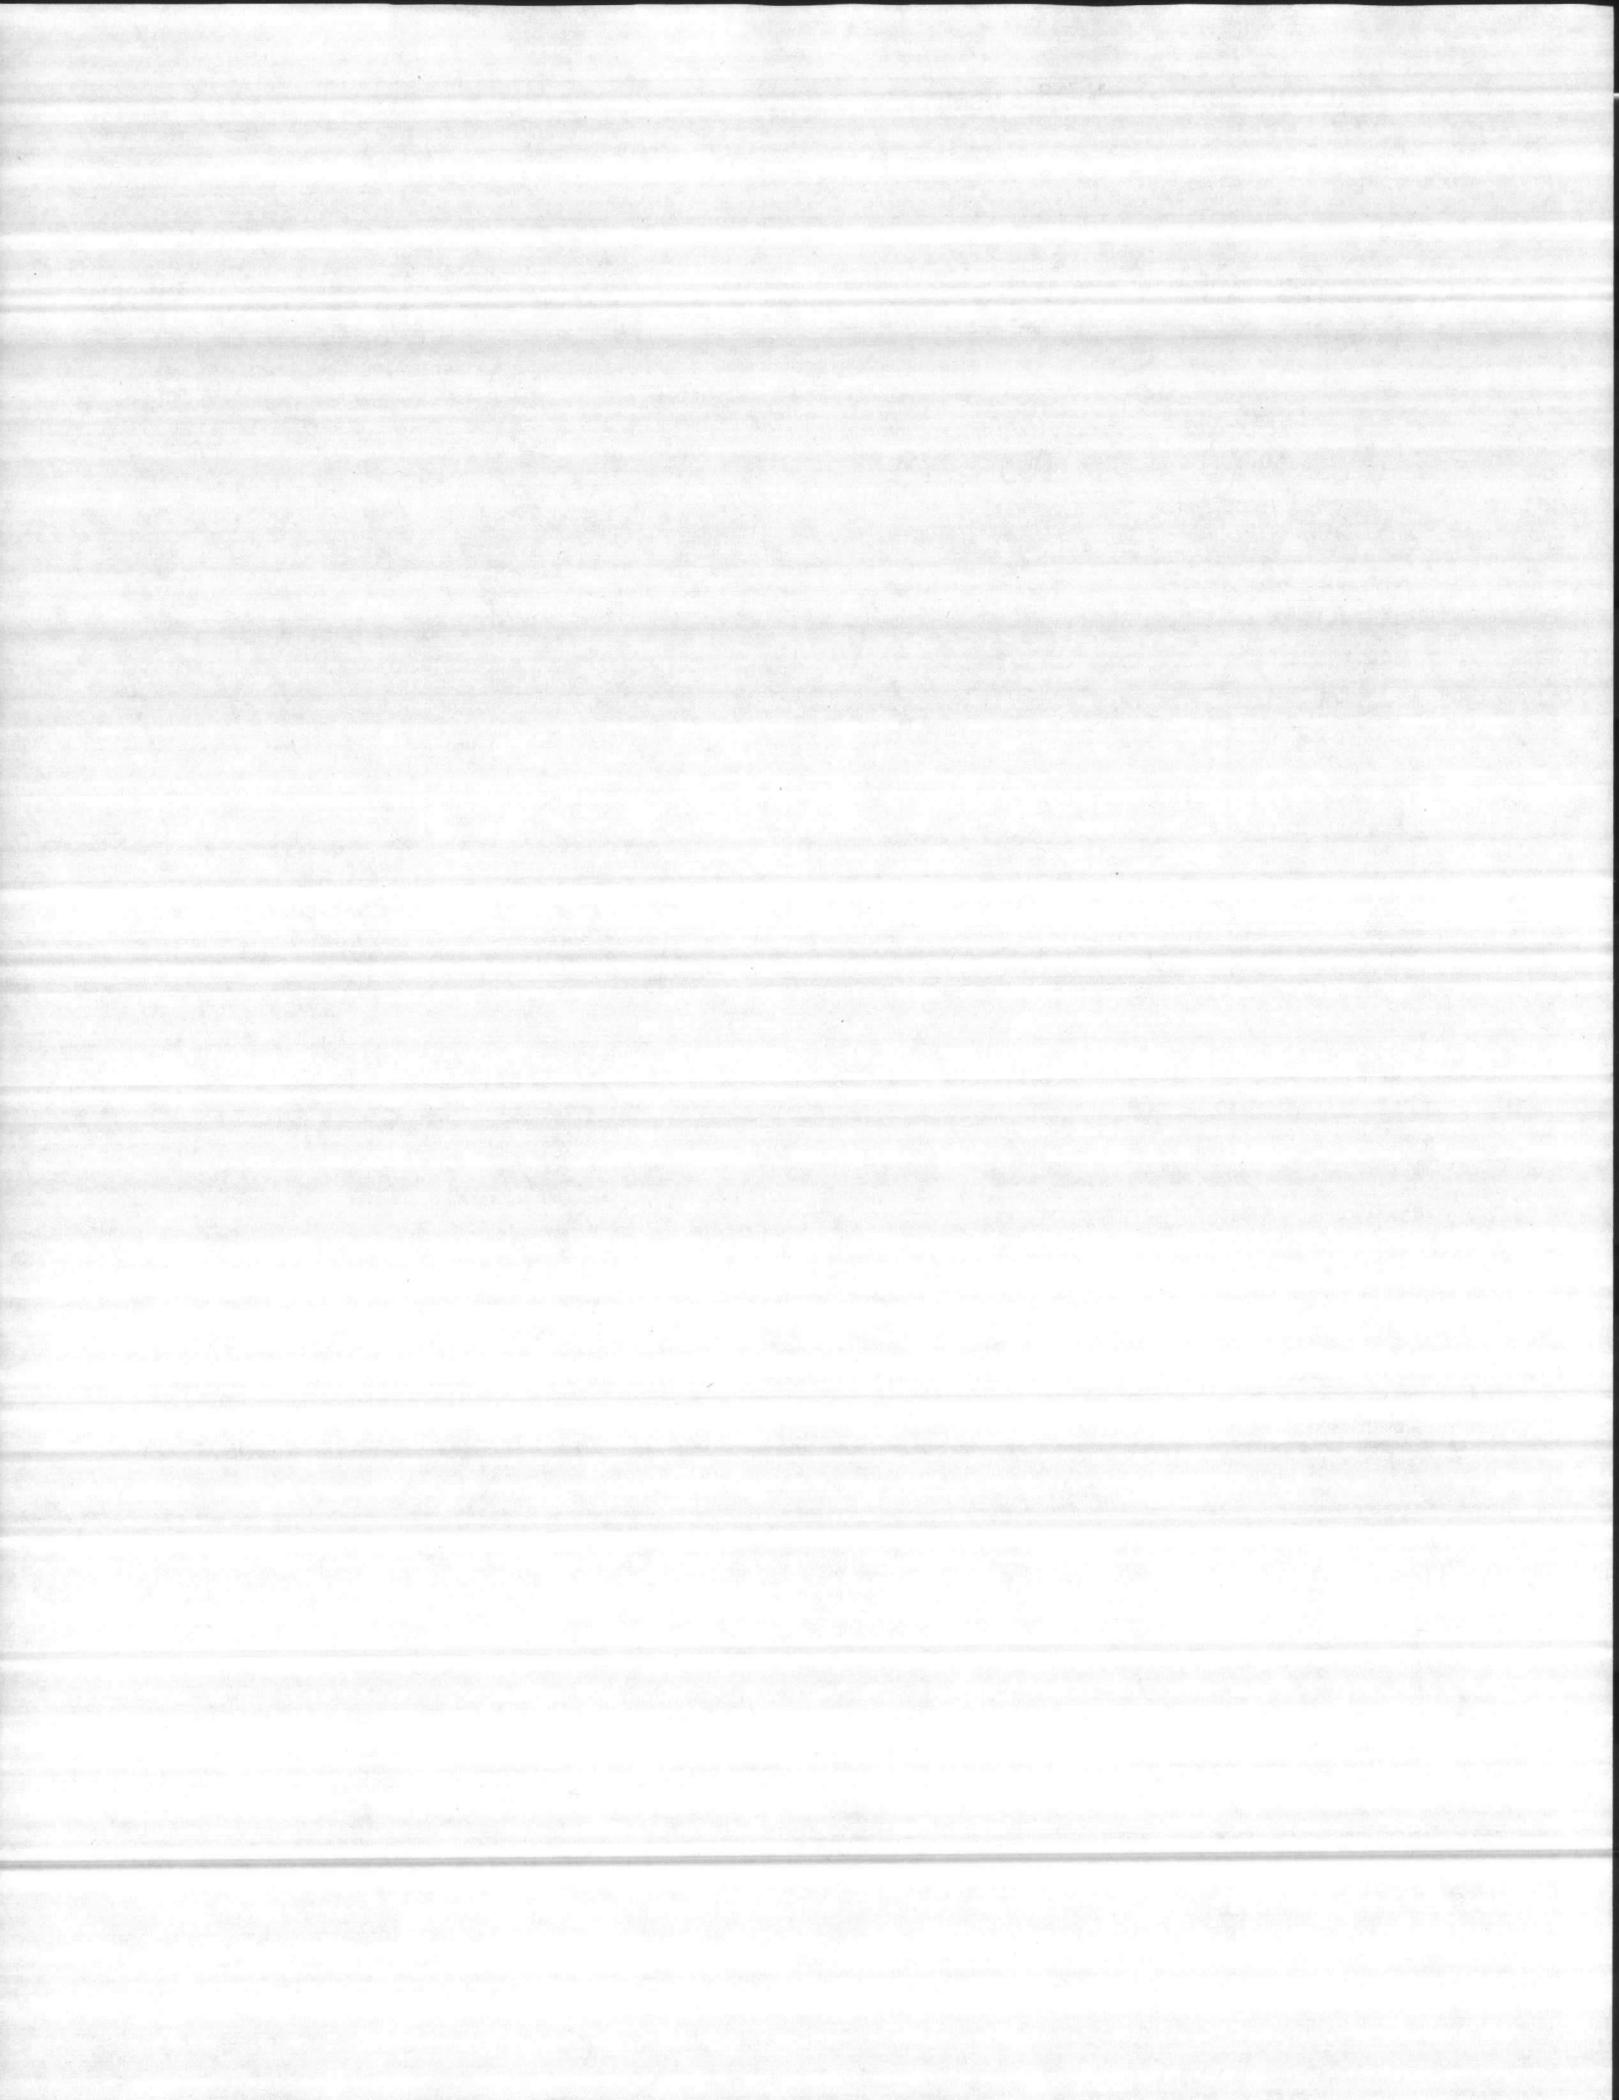

CONTRACTOR'S SUBMITTAL TRANSMITTAL

5ND LANTDIV 4-4355/3 (Rev. 6/76)

FROM CONTRACTOR		CONTRACT NO. 01-C-1766	TRANSMITTAL NO. 86	DATE May 22, 1984
Trader Construction Company		PROJECT TITLE AND LOCATION Public Works		
TO Lockwood Greene/Six Associates		MGB Camp Lejeune, N.C.		

CONTRACTOR USE ONLY

*List only one specification division per form.

List only one of the following categories on each transmittal form, and indicate which is being submitted

Contractor Approved
 OICC Approval
 Deviation/Substitution For OICC Approval

REVIEWER USE ONLY

****ACTION CODES**

- A-Approved
- D-Disapproved
- AN-Approved as noted
- RA-Receipt acknowledged.
- C-Comments
- R-Resubmit

ITEM NO.	PROJ. SPEC. SECT. & PARA. and/or PROJ. DWG. NO. *	ITEM IDENTIFICATION (Type, size, model no., Mfg. name, dwg. or brochure number)	NO. OF COPIES	ACTION CODES **	REVIEWER'S INITIALS CODE AND DATE
152	10801	(continued) Catalog Data			
		Shower curtain rods & flanges	7	A	A.B. Johnson June 84
		Mop Rack	7	A	
		Pail or Ladder Hook	7	A	
		Vacuum hose bracket	7	A	
		Tilted mirror for wheel chair	7	A	
		Surface mounted ash urn	7	A	

CONTRACTOR'S COMMENTS

COPY OF TRANSMITTAL AND SUBMITTALS TO ROICC		CONTRACTOR REPRESENTATIVE (Signature) <i>[Signature]</i>	
DATE RECEIVED BY REVIEWER 5/24/84	FROM (Reviewer) Six Associates, Inc.	TO Trader Construction Co.	


- Submittals are returned with action indicated. Approval of an item does not include approval of any deviation from the contract requirements unless the contractor calls attention to and supports the deviation.
- Submittals are forwarded to LANTDIV with A-E recommendations indicated in REVIEWER USE ONLY Section and in comments below on ONE COPY of the transmittal form.

REVIEWER'S COMMENTS

See Reviewer's Comments on Page 1 of 3.

COPIES TO: ROICC (2) LANTDIV (1) A-E (1)	DATE 6/4/84	SIGNATURE <i>A.B. Johnson</i>
---	----------------	----------------------------------

RECEIVED
 6/11/84
 11:30 AM
 ROICC

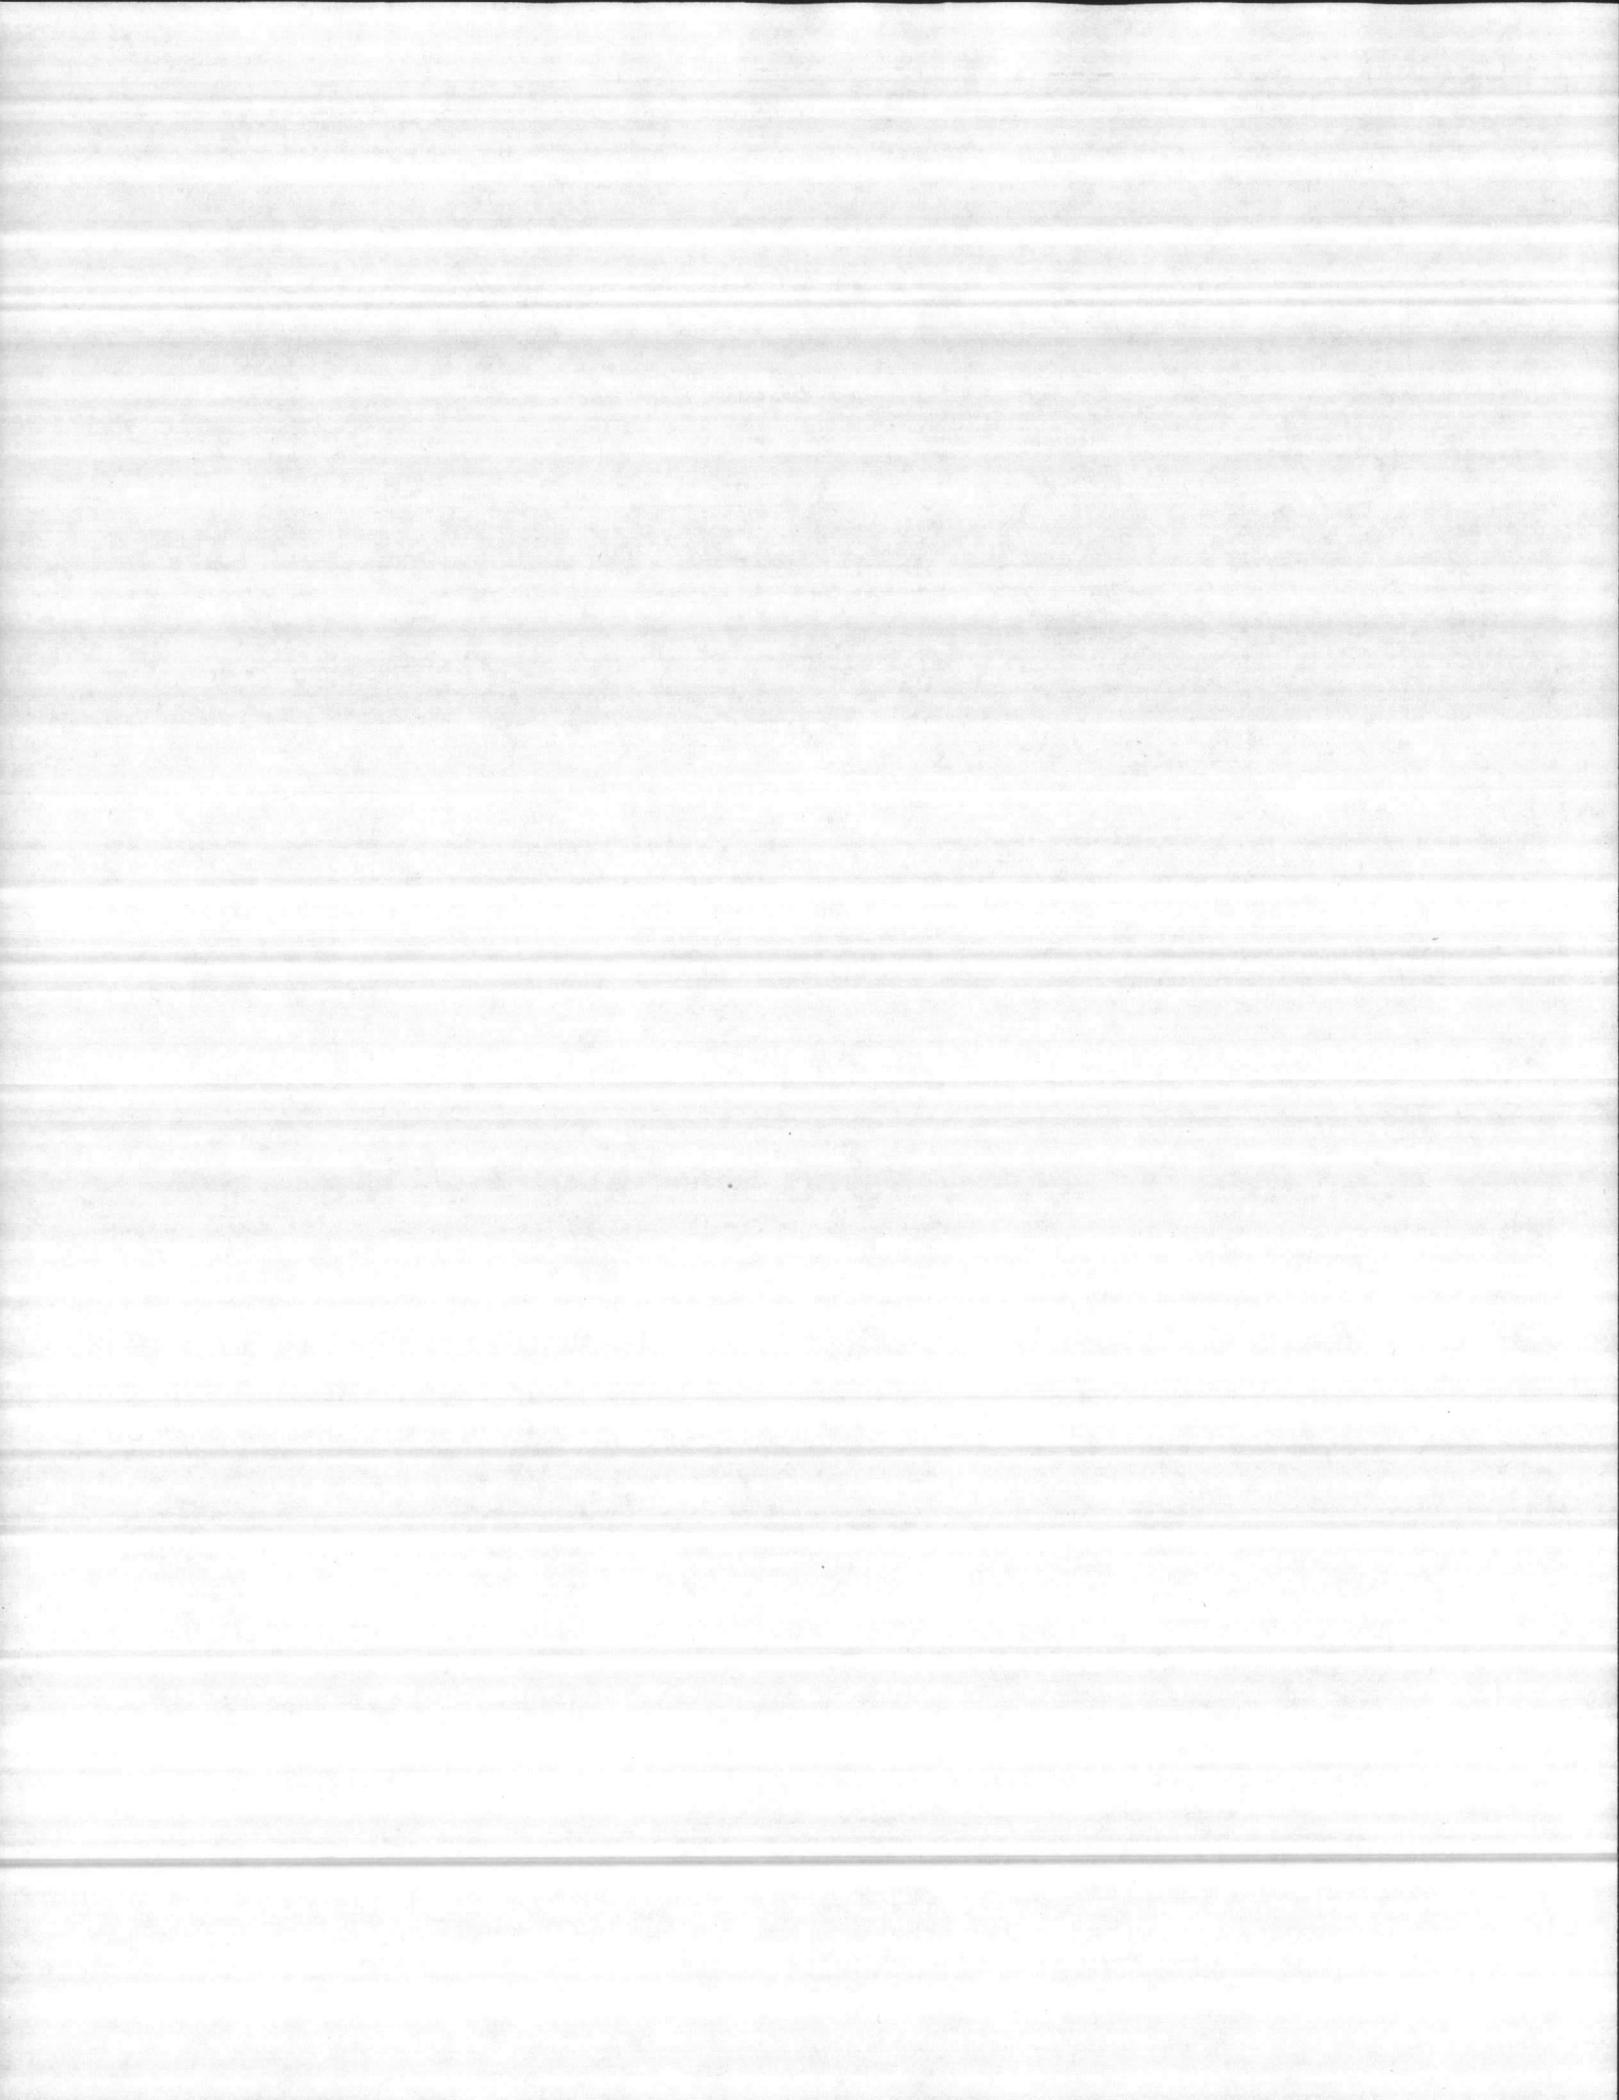




ACCESSORY SPECIALTIES, INC.

STAINLESS STEEL CHANNEL FRAME MIRROR W/SHELF

0625 A

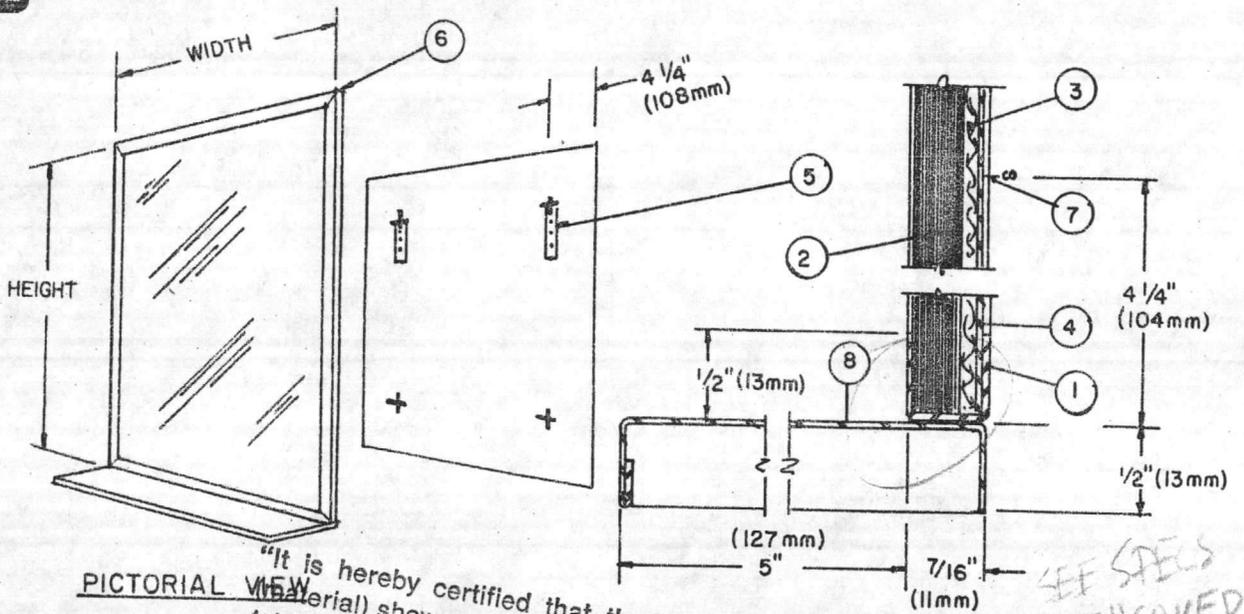

PICTORIAL VIEW "It is hereby certified that the (equipment material) shown and marked in this submittal is that proposed to be incorporated into Contract Number N62470-51-C-176 in compliance with the Contract drawings and specifications. The frame can be installed in the allocated spaces, and is submitted for Government approval. Certified by BACK D.S. 5-22-84 1050

PARTIAL VERTICAL SECTION

SEE SPECS RE "COVERED BOTTOM" A/E

DESCRIPTION

1. 20 GAUGE STAINLESS STEEL FRAME
2. 1/4" PLATE GLASS MIRROR
3. non absorbent filler
4. 22 GAUGE STEEL PAINTED BY BACK
5. SPRING TENSION LOCKING DEVICE
6. LOCKING CLIP
7. INSTALLATION SCREW
8. 18 GAUGE STAINLESS STEEL SHELF

SPECIFICATIONS -

FRAME FACE - FRAME IS FABRICATED OF 20 GAUGE TYPE 304L, 18-8 ALLOY STAINLESS STEEL WITH CORNER MITRED AND POLISHED. ENTIRE FRAME IS POLISHED TO A NO. 4 SATIN FINISH PROTECTED BY A POLYVINYL COATING (PVC) EASILY REMOVED AFTER INSTALLATION. ALL EDGES ARE ROUNDED AND POLISHED SMOOTH. BACK PLATE IS FABRICATED OF NO. 22 GAUGE CORROSION RESISTANT PAINT-LOK STEEL COATED WITH ZINC BY ELECTROLYTIC DEPOSITION, ONE PIECE AND DIE CUT TO FIT FRAME. BACK PLATE IS SUPPLIED WITH CROSS TYPE SLOTS PROVIDED FOR MOUNTING AND A MINIMUM OF TWO SPRING TENSIONED LOCKING DEVICES IN SLOTS. SHELF - 20 GA. STAINLESS STEEL.

GLAZING - THE NO. 625 FRAME IS AVAILABLE WITH THE FOLLOWING GLAZING SURFACES:

- A. PLATE GLASS - IS 1/4" (6MM) QUALITY POLISHED PLATE GLASS, SILVER COATED AND HERMETICALLY SEALED. MIRRORS MEET GOVERNMENT SPECIFICATIONS NO. DD-G-451, AND ARE GUARANTEED FOR 15 YEARS AGAINST SILVER SPOILAGE.
- B. TEMPERED GLASS - IS 1/4" (6MM) THICK POLISHED TEMPERED GLASS WITH TWO COATS OF SILVER, PROPERLY APPLIED. THE COVERING IS HERMETICALLY SEALED BY ELECTROPLATING WITH A HEAVY UNIFORM COATING OF COPPER. BACK OF MIRROR IS FINISHED AND PROTECTED WITH A THICK COAT OF HEAVY WATERPROOF PAINT. (FED. SPEC. DD-G-1403B, AMEND. 1)
- C. METAL MIRRORS - ARE STAINLESS STEEL POLISHED TO A MIRROR FINISH.


INSTALLATION -

SURFACE MOUNTED AND SECURED TO WALL BY MEANS OF THE FOUR REAR WALL CROSS SLOTS AND SCREWS FURNISHED BY MANUFACTURER. THEFT-PROOF IS AUTOMATIC UPON COMPLETION.

MOUNTING SUGGESTIONS - FOR 20" (508MM) AND 24" (610MM) HIGH MIRRORS, 48" (1220MM) FROM FINISHED LOOR TO BOTTOM OF MIRROR FRAME.

MIRRORS IN EXCESS OF 97" (2464MM) WIDE ARE FABRICATED IN TWO OR MORE SECTIONS.

THIS MANUFACTURER RESERVES THE RIGHT TO MAKE CHANGES IN DESIGN OR DIMENSIONS WITHOUT FORMAL NOTICE.

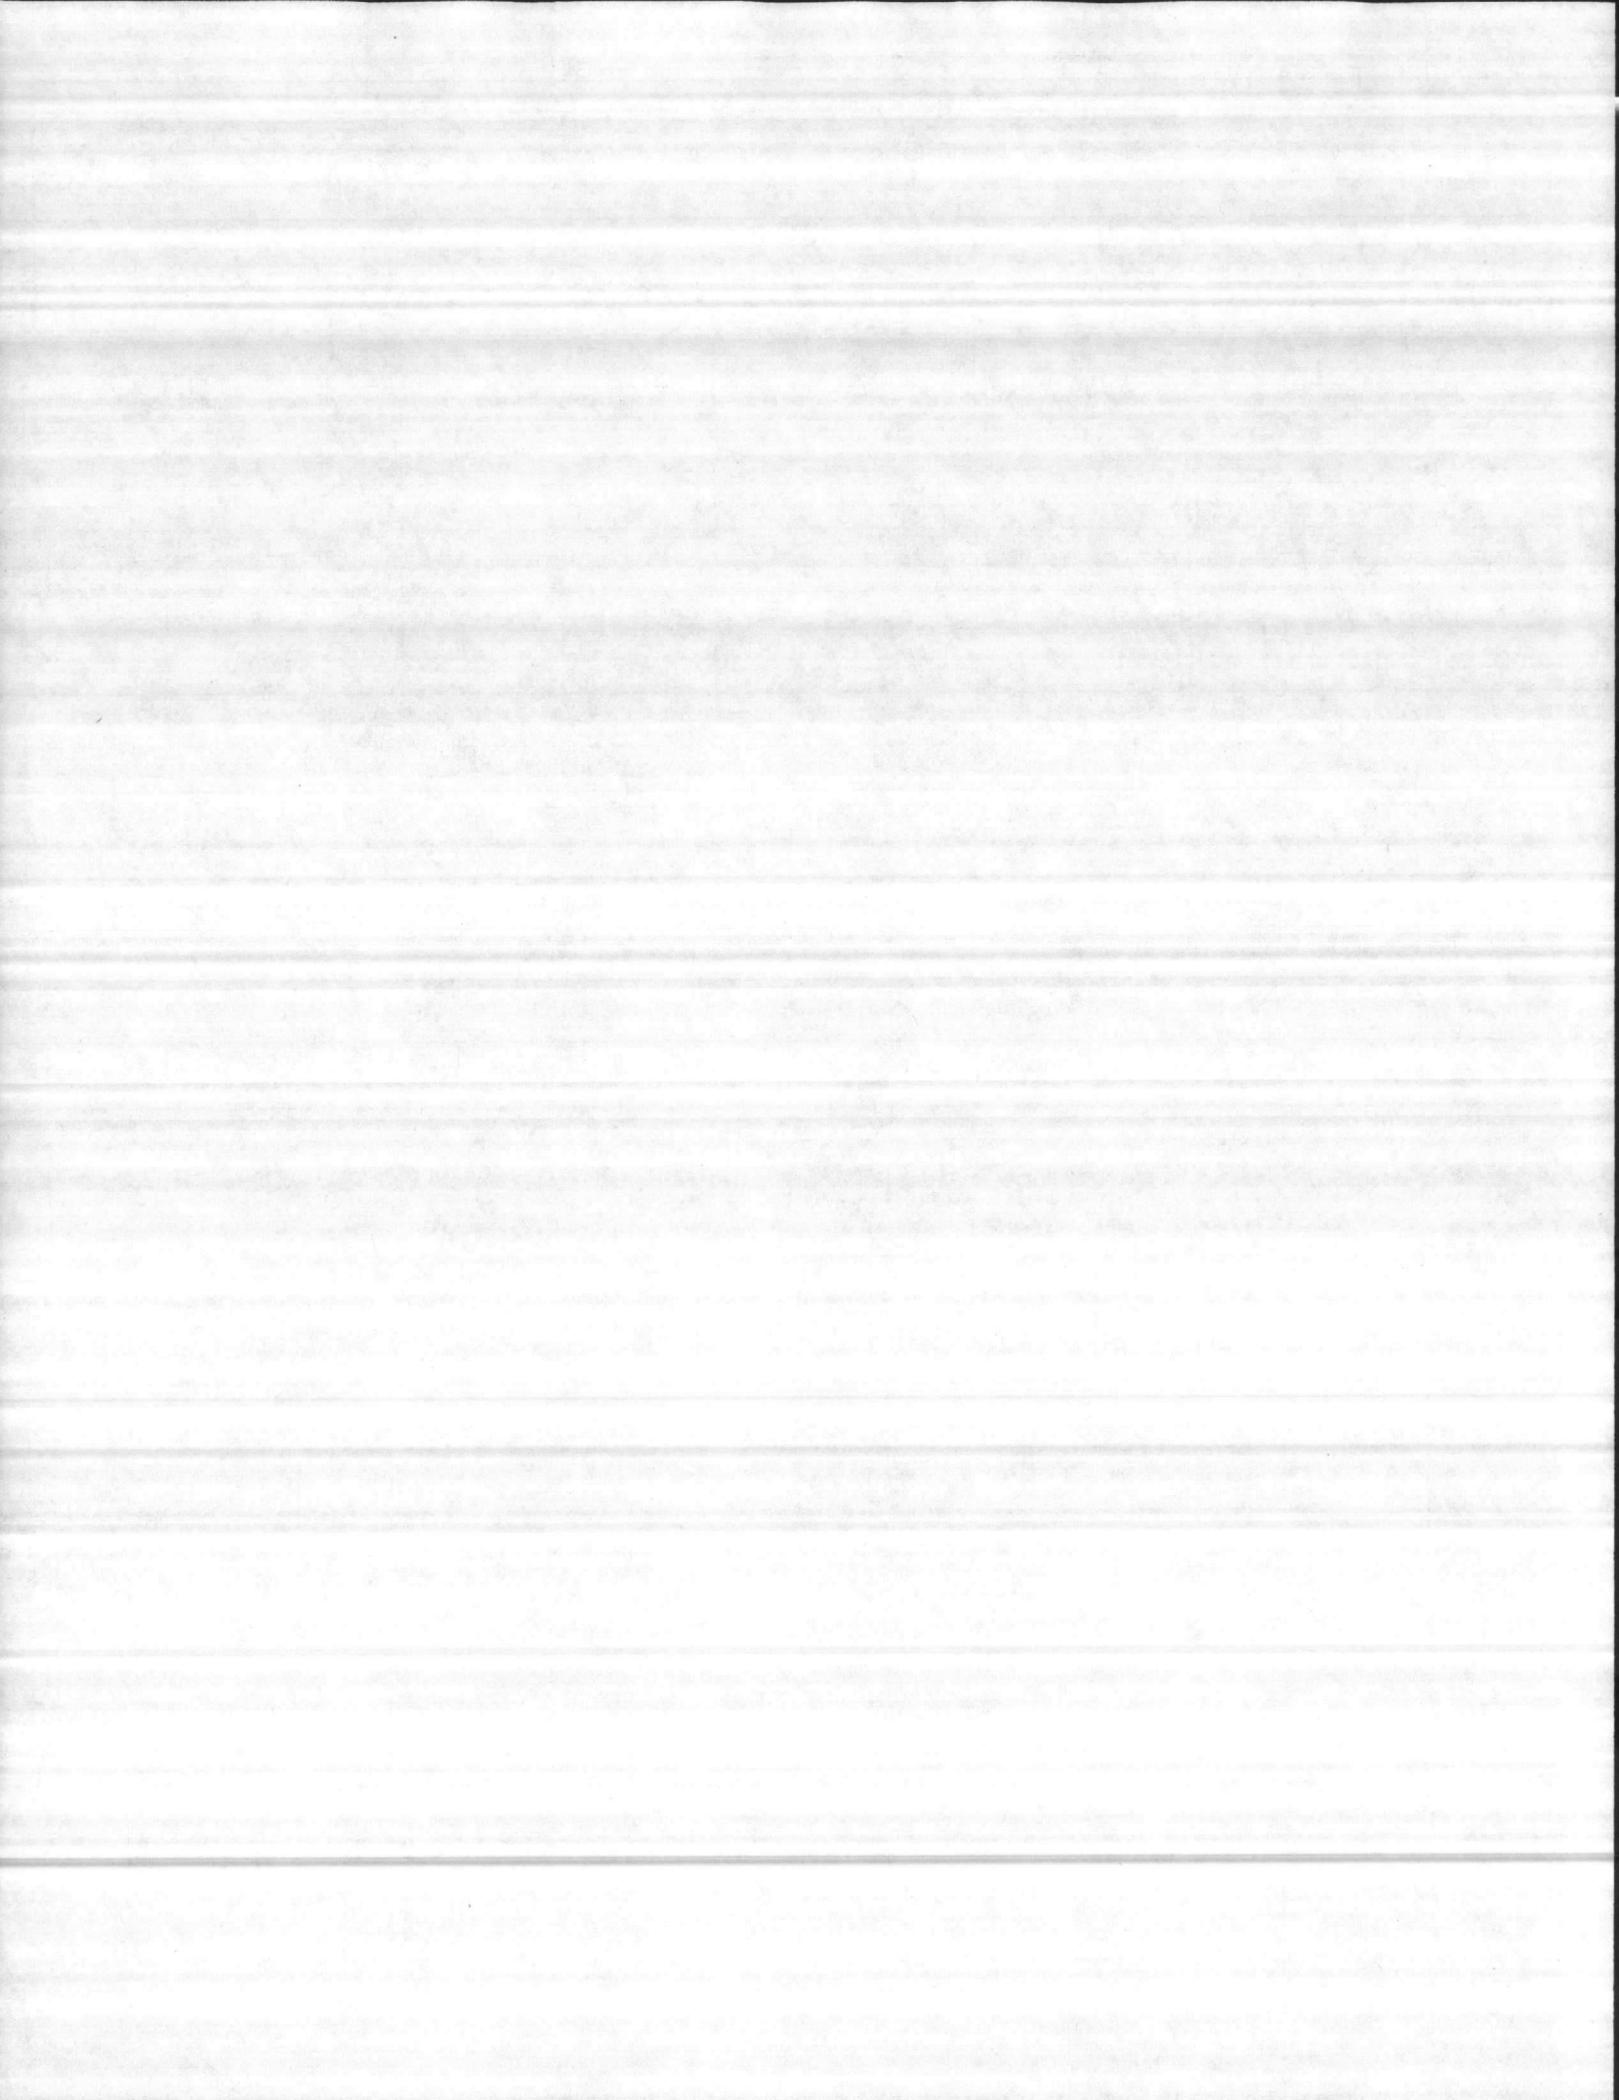




ACCESSORY SPECIALTIES, INC.

SURFACE MOUNTED STAINLESS STEEL PAPER TOWEL DISPENSER

0210/0230

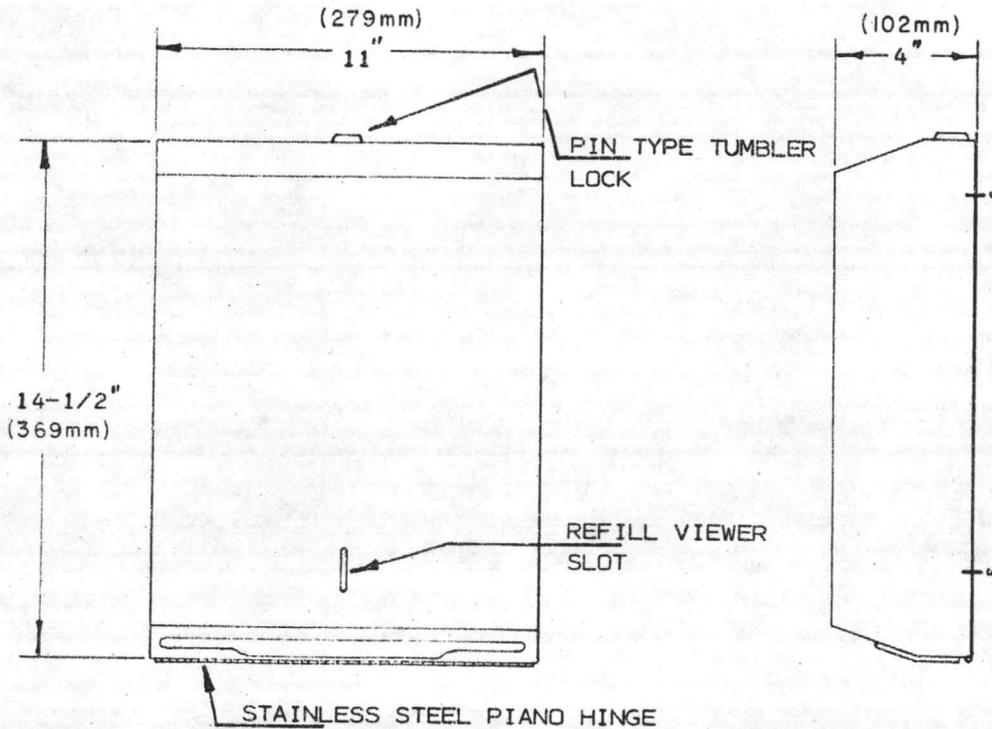

SPECIFICATION-

PAPER TOWEL DISPENSER IS FABRICATED OF NO. 20 GAUGE TYPE 304L, 18-8 ALLOY STAINLESS STEEL WITH A NO. 4 SATIN FINISH PROTECTED BY A POLYVINYL COATING (PVC) EASILY REMOVED AFTER INSTALLATION. DOOR IS PIVOTED FROM LOWER PORTION OF CABINET AND HELD CLOSED BY MEANS OF A PIN TYPE TUMBLER LOCK. DOOR IS ALSO PROVIDED WITH REFILL VIEWER SLOT.

CAPACITY - 500 MULTI FOLD OR 400 C-FOLD PAPER TOWELS

INSTALLATION - UNIT IS SUPPLIED WITH WOOD SCREWS FOR MOUNTING THROUGH SLOTS PROVIDED IN REAR OF CABINET FURNISHED BY MANUFACTURER.

MOUNTING SUGGESTION

LOCATION - 50" FROM TOP OF FINISHED FLOOR TO BOTTOM OF DISPENSER (1270mm)


"It is hereby certified that the (equipment) shown and marked in this dispenser (material) that proposed to be incorporated into Contract Number N62470-81-C-1764, is in compliance with the Contract drawings and specifications, and is submitted Government approval.

Certified by D.S.

Date 5-22-84

THIS MANUFACTURER RESERVES THE RIGHT TO MAKE CHANGES IN DESIGN OR DIMENSIONS WITHOUT FORMAL NOTICE

REV. 8-76/11-78

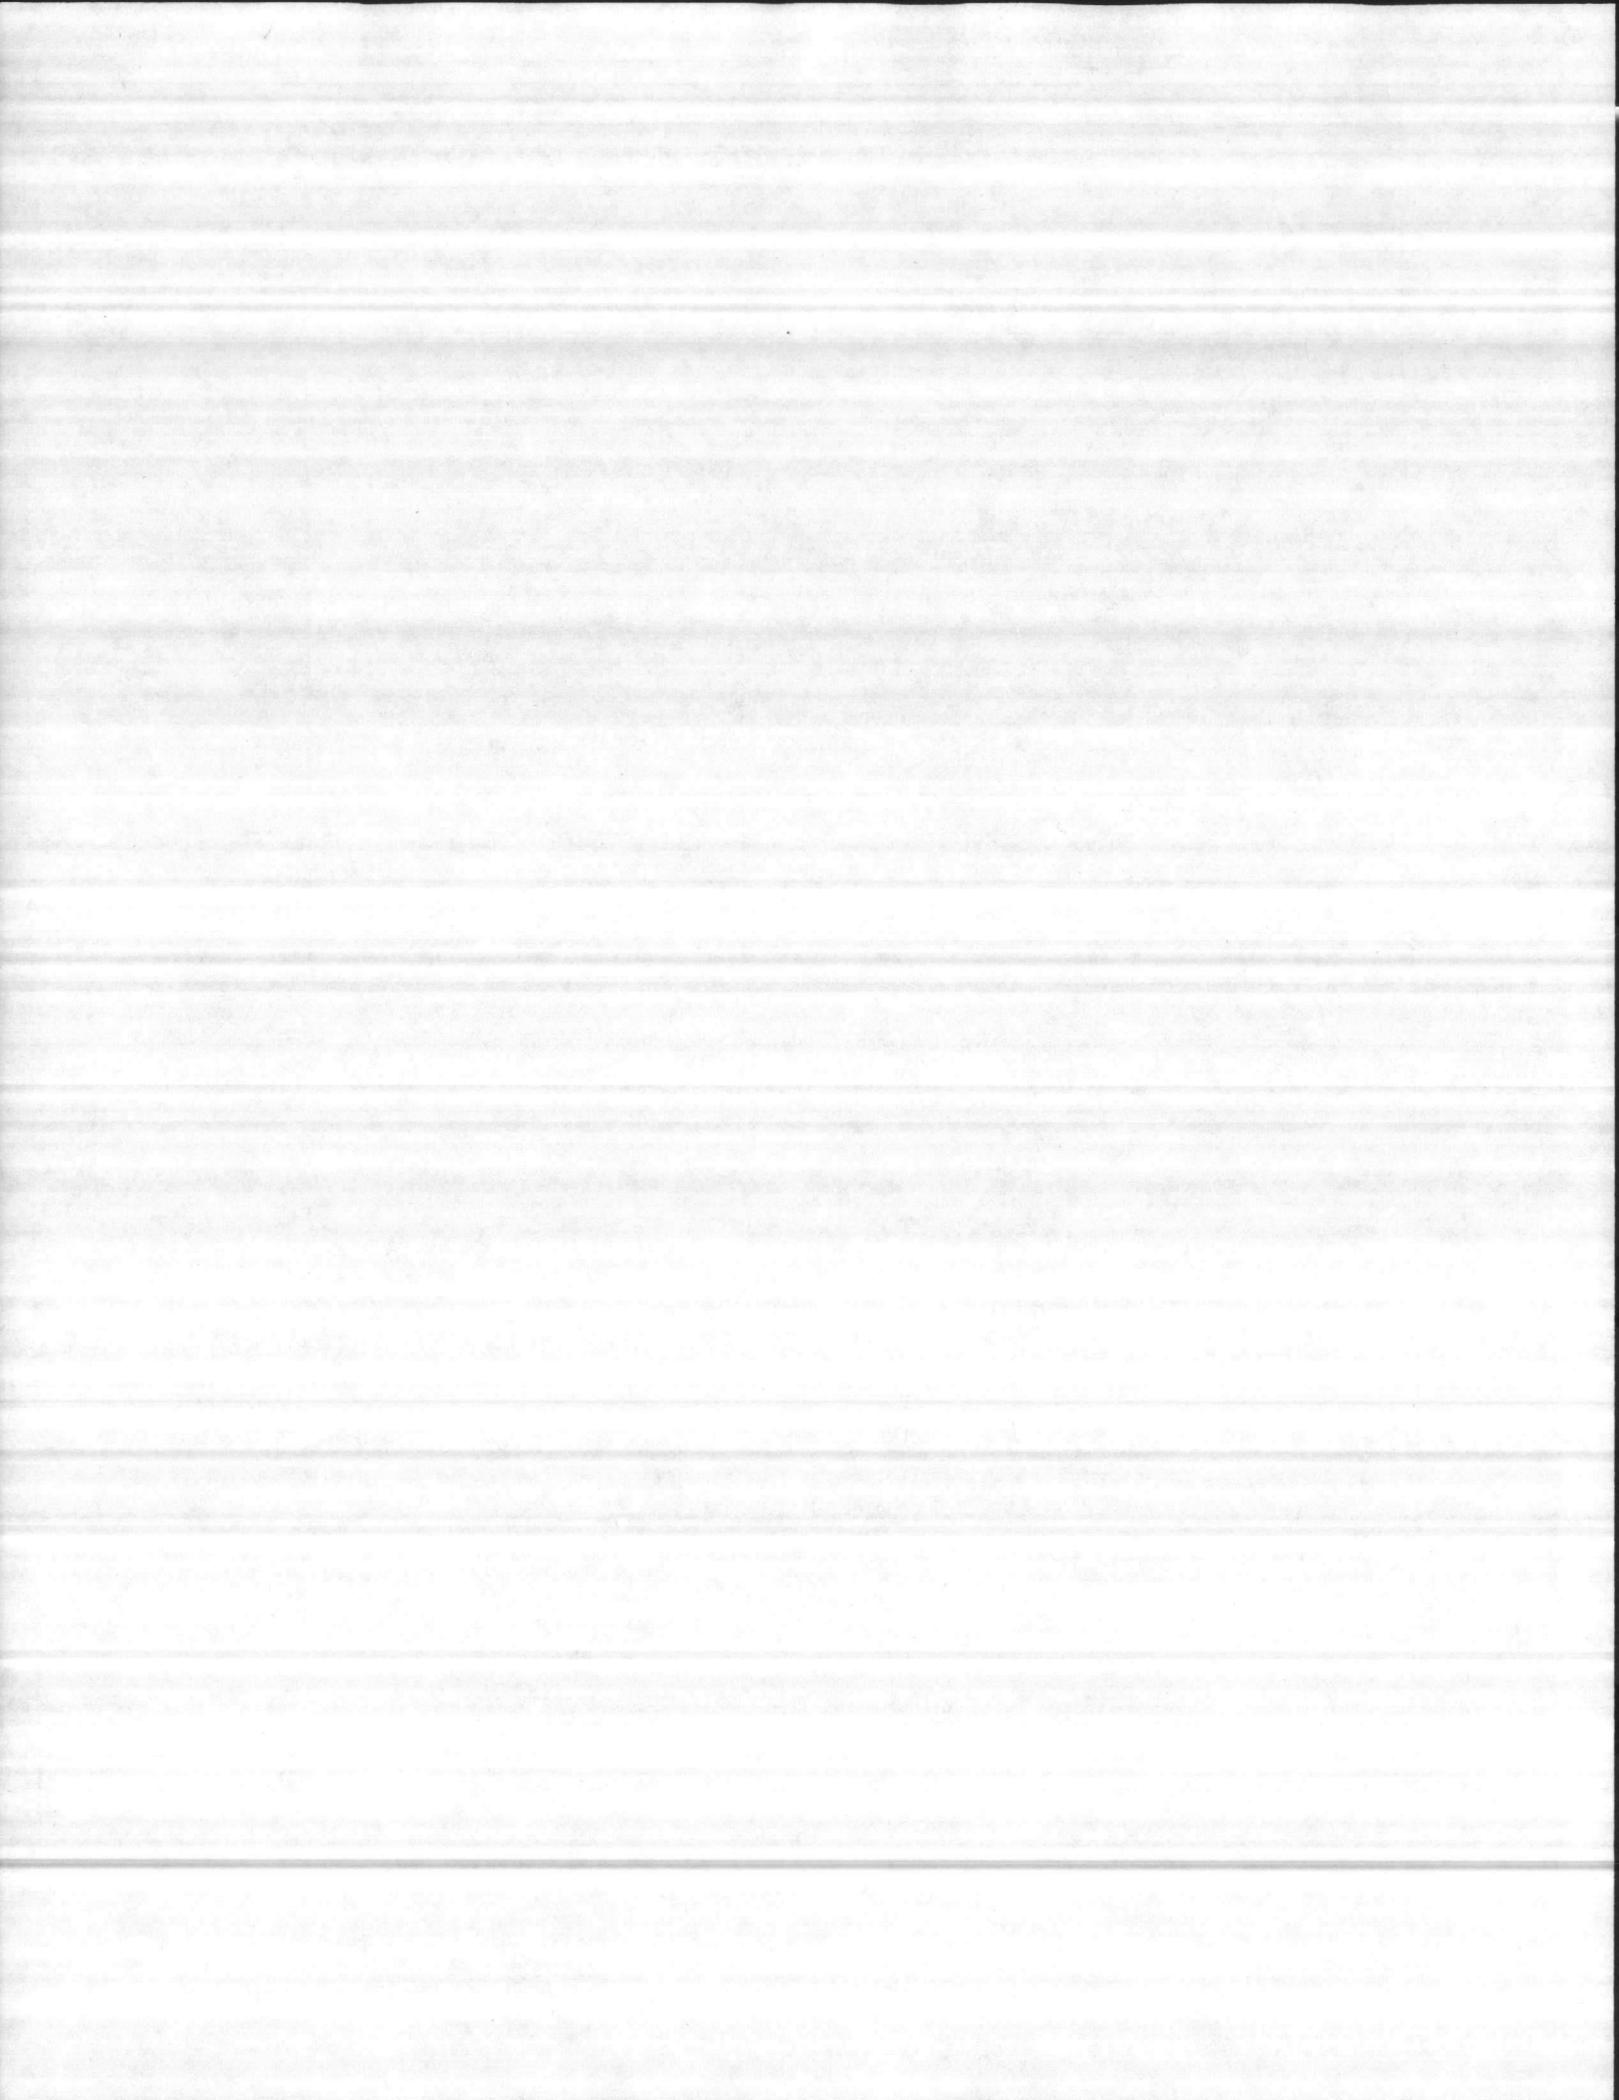



ACCESSORY SPECIALTIES, INC.

1-1/4" (32mm) DIAMETER GRAB BAR WITH CONCEALED MOUNTING 3100

ATLANTIC DIVISION
NAVAL FACILITIES ENGINEERING COMMAND
NORFOLK, VIRGINIA 23511


APPROVED _____
APPROVED AS NOTED _____
DISAPPROVED _____

SUBJECT TO THE REQUIREMENTS OF
CONTRACT NO. N62470-81-C-1766

APPROVAL OF A SUBMITTAL DOES NOT INCLUDE APPROVAL OF ANY DEVIATION FROM THE CONTRACT REQUIREMENTS UNLESS THE CONTRACTOR CALLS ATTENTION TO AND SUPPORTS THE DEVIATION... THE CONTRACTOR SHALL BE RESPONSIBLE FOR PROVIDING PROPER PHYSICAL DIMENSIONS AND WEIGHTS, UNLESS OTHERWISE SPECIFIED BY TRADES, ETC., AS REQUIRED.

OPTIONS APPROVED BY WEIGHTS, UNLESS OTHERWISE SPECIFIED BY TRADES, ETC., AS REQUIRED.

- K - KNOWN REVIEWER John DATE 1 June 84
- P - PEENED FOR OFFICER IN CHARGE OF CONSTRUCTION
- Z - 1-1/2" (38mm) CLEAR DIMENSION BETWEEN BAR AND FINISHED WALL.

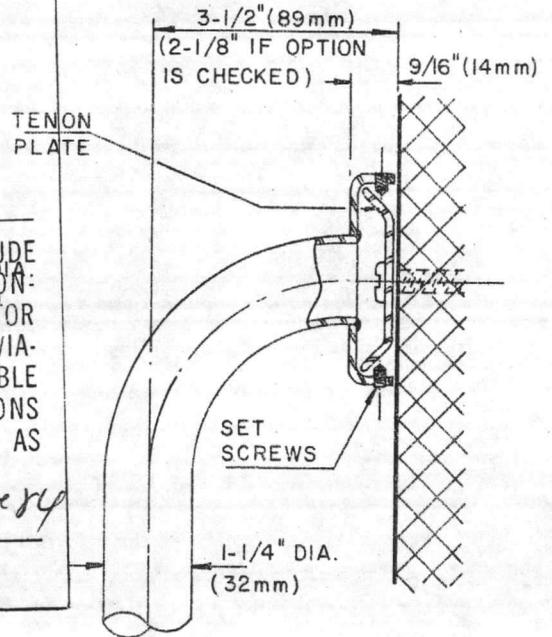

SPECIFICATIONS -

STAINLESS STEEL GRAB BAR SHALL BE FABRICATED OF NO. 16 GAUGE (.064 THICK) 1-1/4" (32MM) O.D. TYPE 304L, 18-8 ALLOY STAINLESS STEEL TUBING. END FLANGES (AND CENTER FLANGES IF REQUIRED) SHALL BE STAINLESS STEEL PRE-DRILLED AND TAPPED FOR THREE (3) TAMPER PROOF CASE HARDENED STAINLESS STEEL ALLEN HEAD SET SCREWS. FLANGES SHALL BE HELIARC WELDED TO TUBING TO FORM A SINGLE STRUCTURAL UNIT. MOUNTING TENON PLATE SHALL BE FABRICATED OF CASE HARDENED CADMIUM PLATED STEEL. ALL STAINLESS STEEL SHALL HAVE A SATIN FINISH.

INSTALLATION -

PROVIDE CONCEALED ANCHOR DEVICE OR BACKING AS SPECIFIED OR REQUIRED IN ACCORDANCE WITH LOCAL BUILDING CODES BEFORE WALL IS FINISHED. MOUNTING TENON PLATE IS PROVIDED WITH ELONGATED SLOT FOR 3/8" DIAMETER BOLT. (ANCHORS ARE PROVIDED ONLY WHEN SPECIFICALLY INDICATED BY TYPES. SEE ANCHOR SPECIFICATION SHEET FOR TYPES AVAILABLE.) SLOT IN TENON PLATE ALLOWS FOR APPROX. 1" VERTICAL OR HORIZONTAL ADJUSTMENT. AFTER TENON PLATE IS MOUNTED TO WALL, FLANGES ARE FITTED OVER TENON PLATES AND INSTALLATION IS COMPLETED BY TIGHTENING OF THE ALLEN HEAD SET SCREWS.

TECHNICAL DATA -


EACH GRAB BAR WILL WITHSTAND A FORCE (DOWNWARD) PROPOSED TO BE INCORPORATED INTO COMPLIANCE WITH THE CONTRACT DRAWINGS AND APPROVALS, AND IS SUBMITTED GOVERNMENT APPROVAL.

FLEXURAL STRENGTH - 8,000 PSI MODULUS OF ELASTICITY - 29,000,000 PSI

SHEAR & PULL OUT - 1,000 LBS. PER LINEAL FOOT

It is hereby certified that the (equipment) (material) shown and marked in this submittal is that proposed to be incorporated into Contract Number N62470-81-C-1766 in compliance with the Contract drawings and approvals, and is submitted Government approval.

Certified by DS
Date 5.22.84

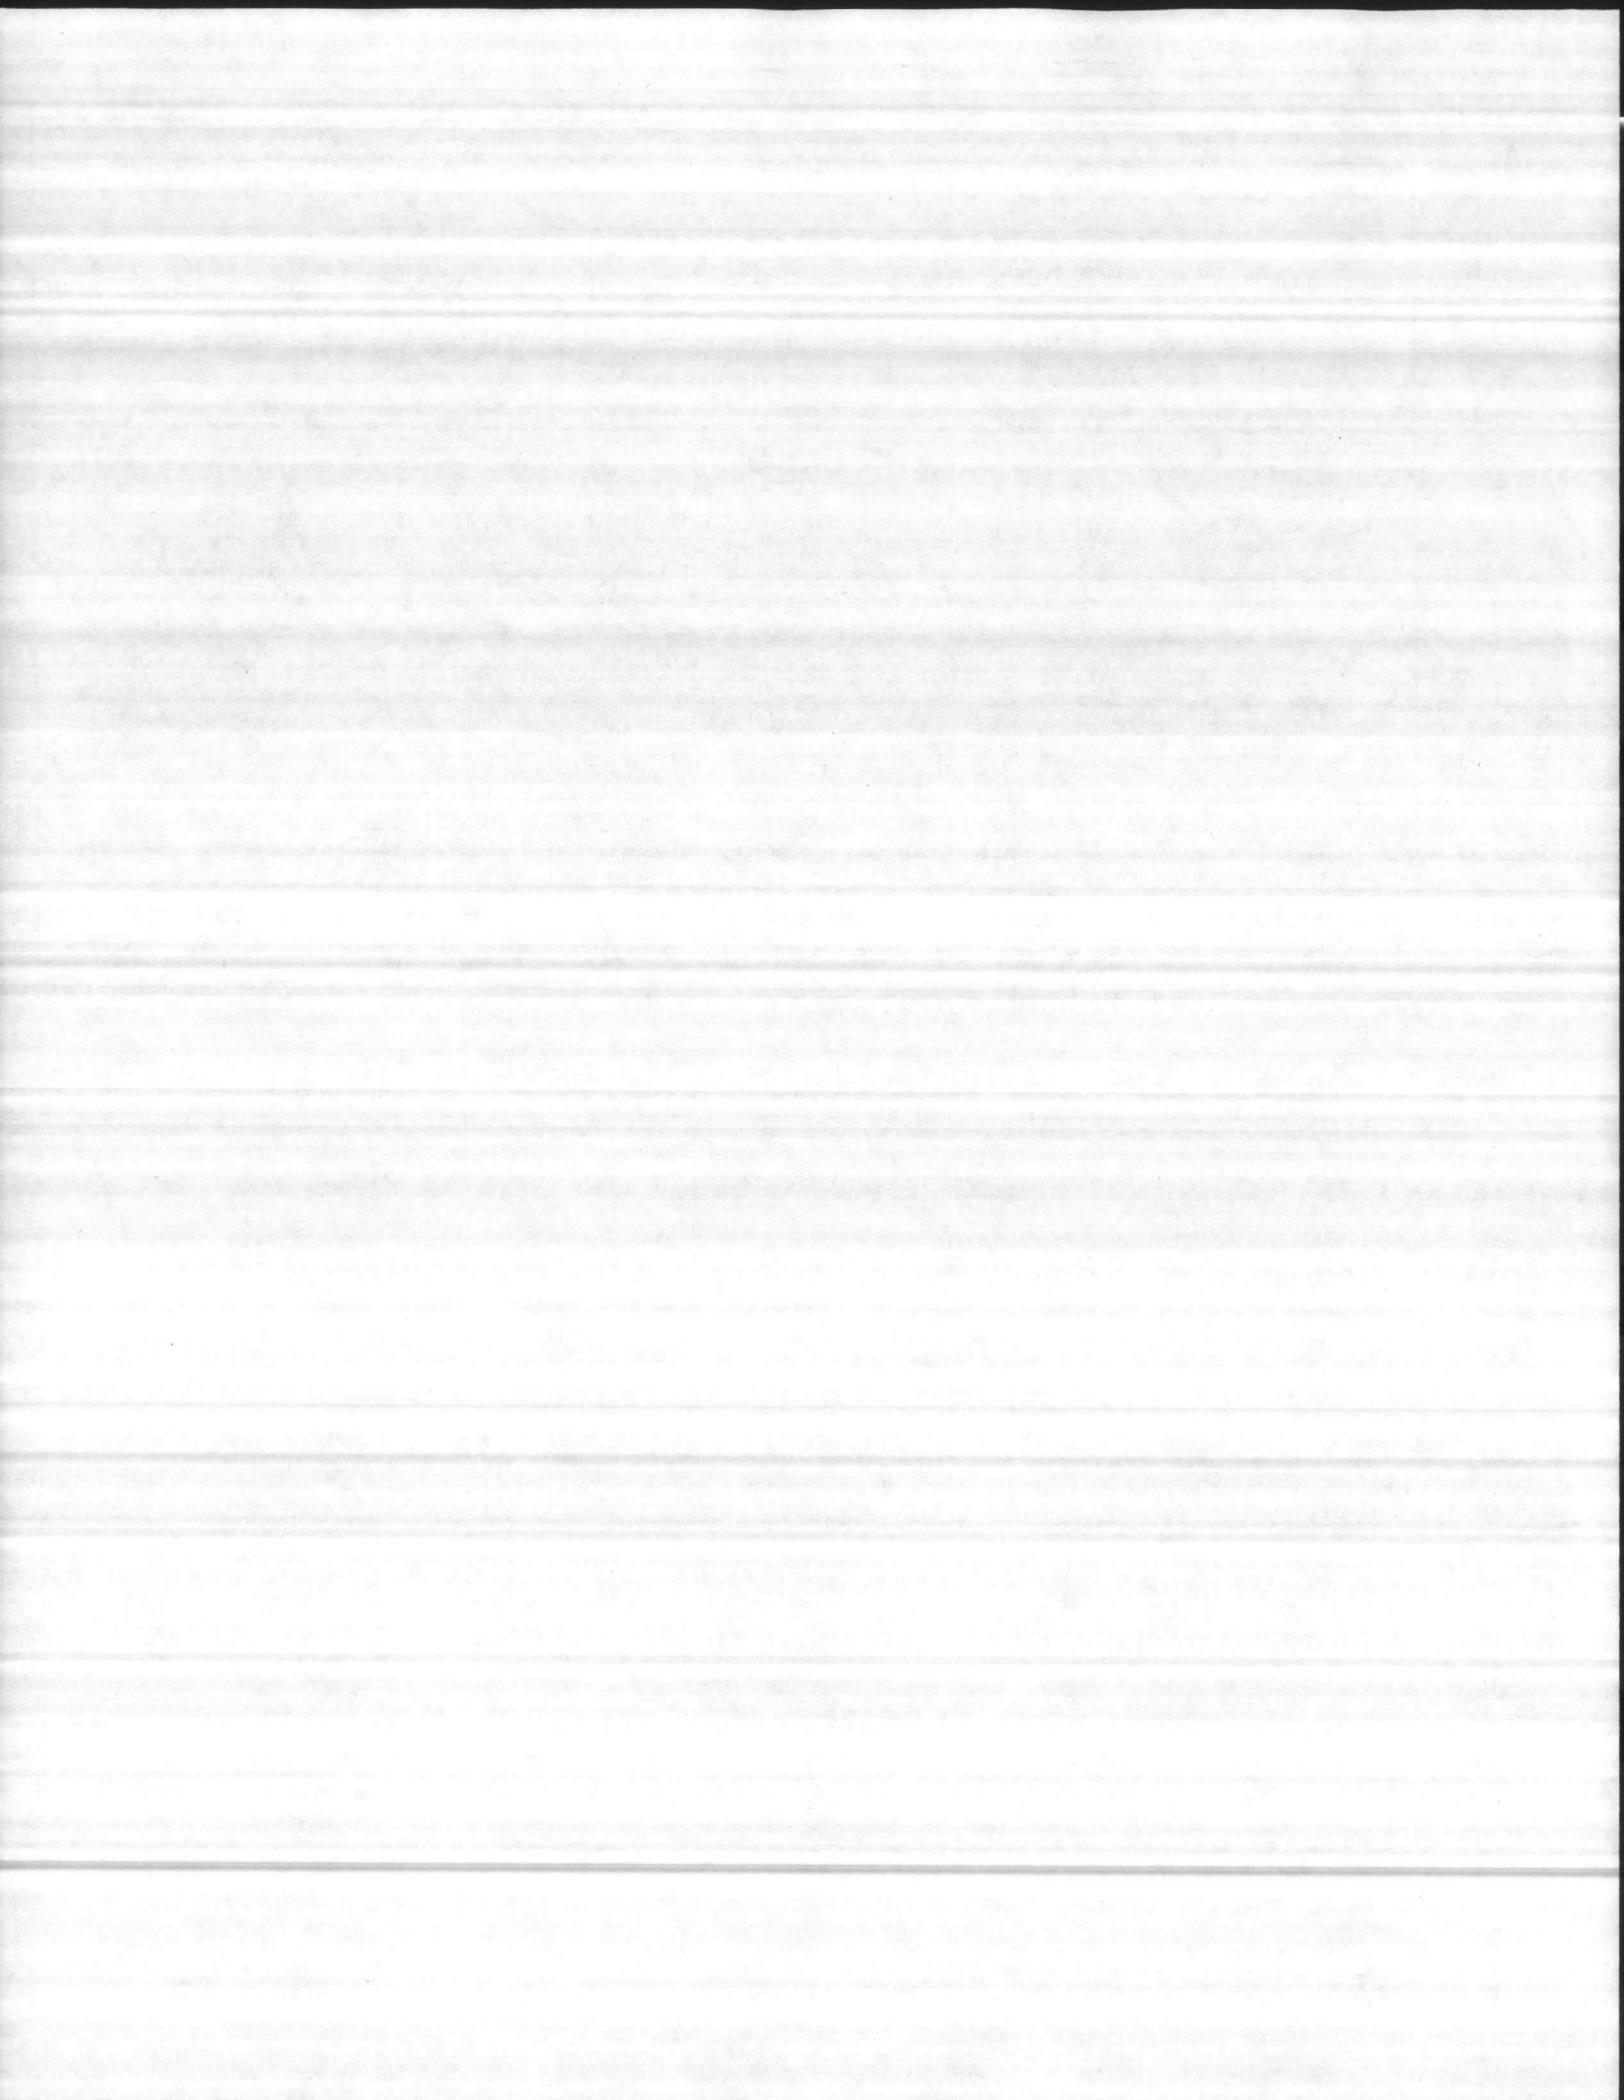




ACCESSORY SPECIALTIES, INC.

STAINLESS STEEL SHELF

0692

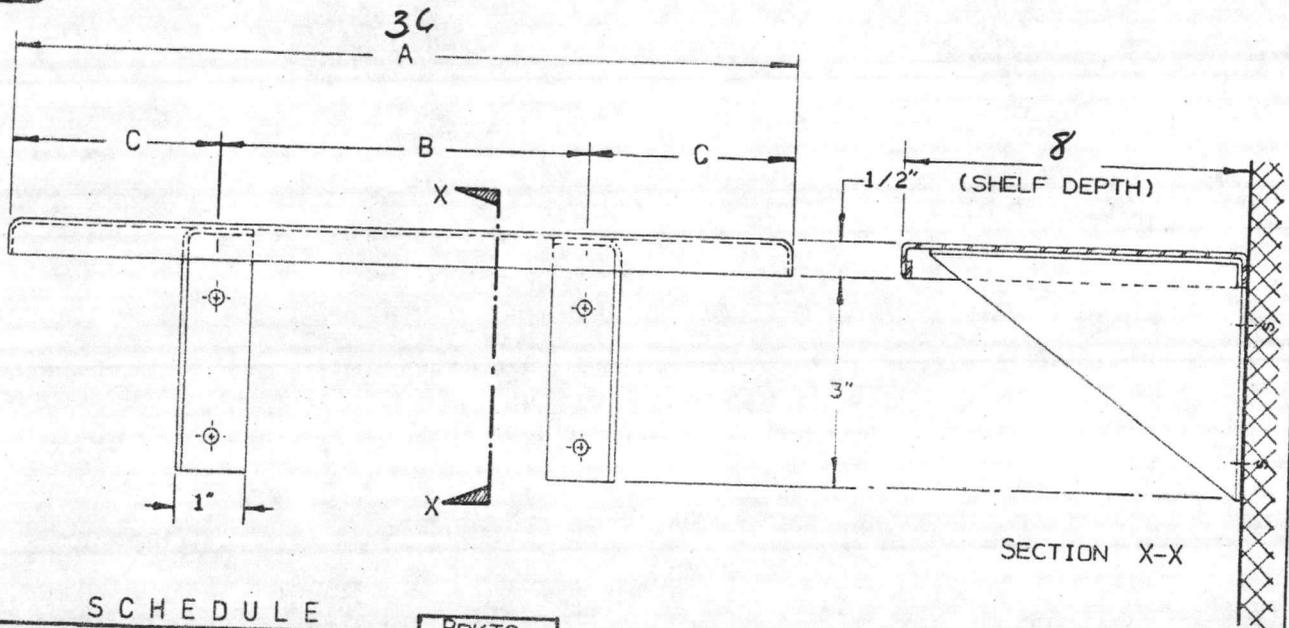

SCHEDULE

LENGTH A	DIM B	DIM C	BRKTS REQD
12"	6"	3"	2
16"	10"	3"	2
18"	12"	3"	2
24"	18"	3"	2
30"	12"	3"	3
36"	15"	3"	3
42"	18"	3"	3
48"	14"	3"	4
60"	18"	3"	4
72"	16-1/2"	3"	5

"It is hereby certified that the (equipment) (material) shown and marked in this submittal is that proposed to be incorporated into Contract Number N62470-81-C-1766, is in compliance with the Contract drawings and specifications, can be installed in the allocated spaces, and is submitted Government approval.

Certified by D.S.

Date 5-22-84

SPECIFICATIONS

SHELF IS FABRICATED OF 18-8 ALLOY TYPE 304L STAINLESS STEEL POLISHED TO A #4 SATIN FINISH. SHELF BODY IS #18 GAUGE.

SHELF IS PROVIDED WITH A 1/2" LIP ON ALL FOUR SIDES.

BRACKETS TO BE 16 GAUGE, WELDED IN PLACE AND FURNISHED AT DEFINITE INTERVALS AS INDICATED IN THE ABOVE SCHEDULE.


INSTALLATION SHELF BRACKET(S) ARE PROVIDED WITH TWO (2) HOLES PER BRACKET TO ACCOMMODATE 3/16" DIAMETER SCREWS.

NOTE - SINCE SHELVES ARE CUSTOM FABRICATED, ALMOST ALL SIZES ARE AVAILABLE. LENGTHS SCHEDULED ABOVE ARE STANDARD.

MOUNTING SUGGESTIONS

LOCATION - 42" FROM TOP OF FINISHED FLOOR TO TOP OF SHELF OR 18" ABOVE TOP OF WASH BASIN.

AVAILABLE SHELF DEPTHS - 5" , 6" , 8" , 12" , AND 18"


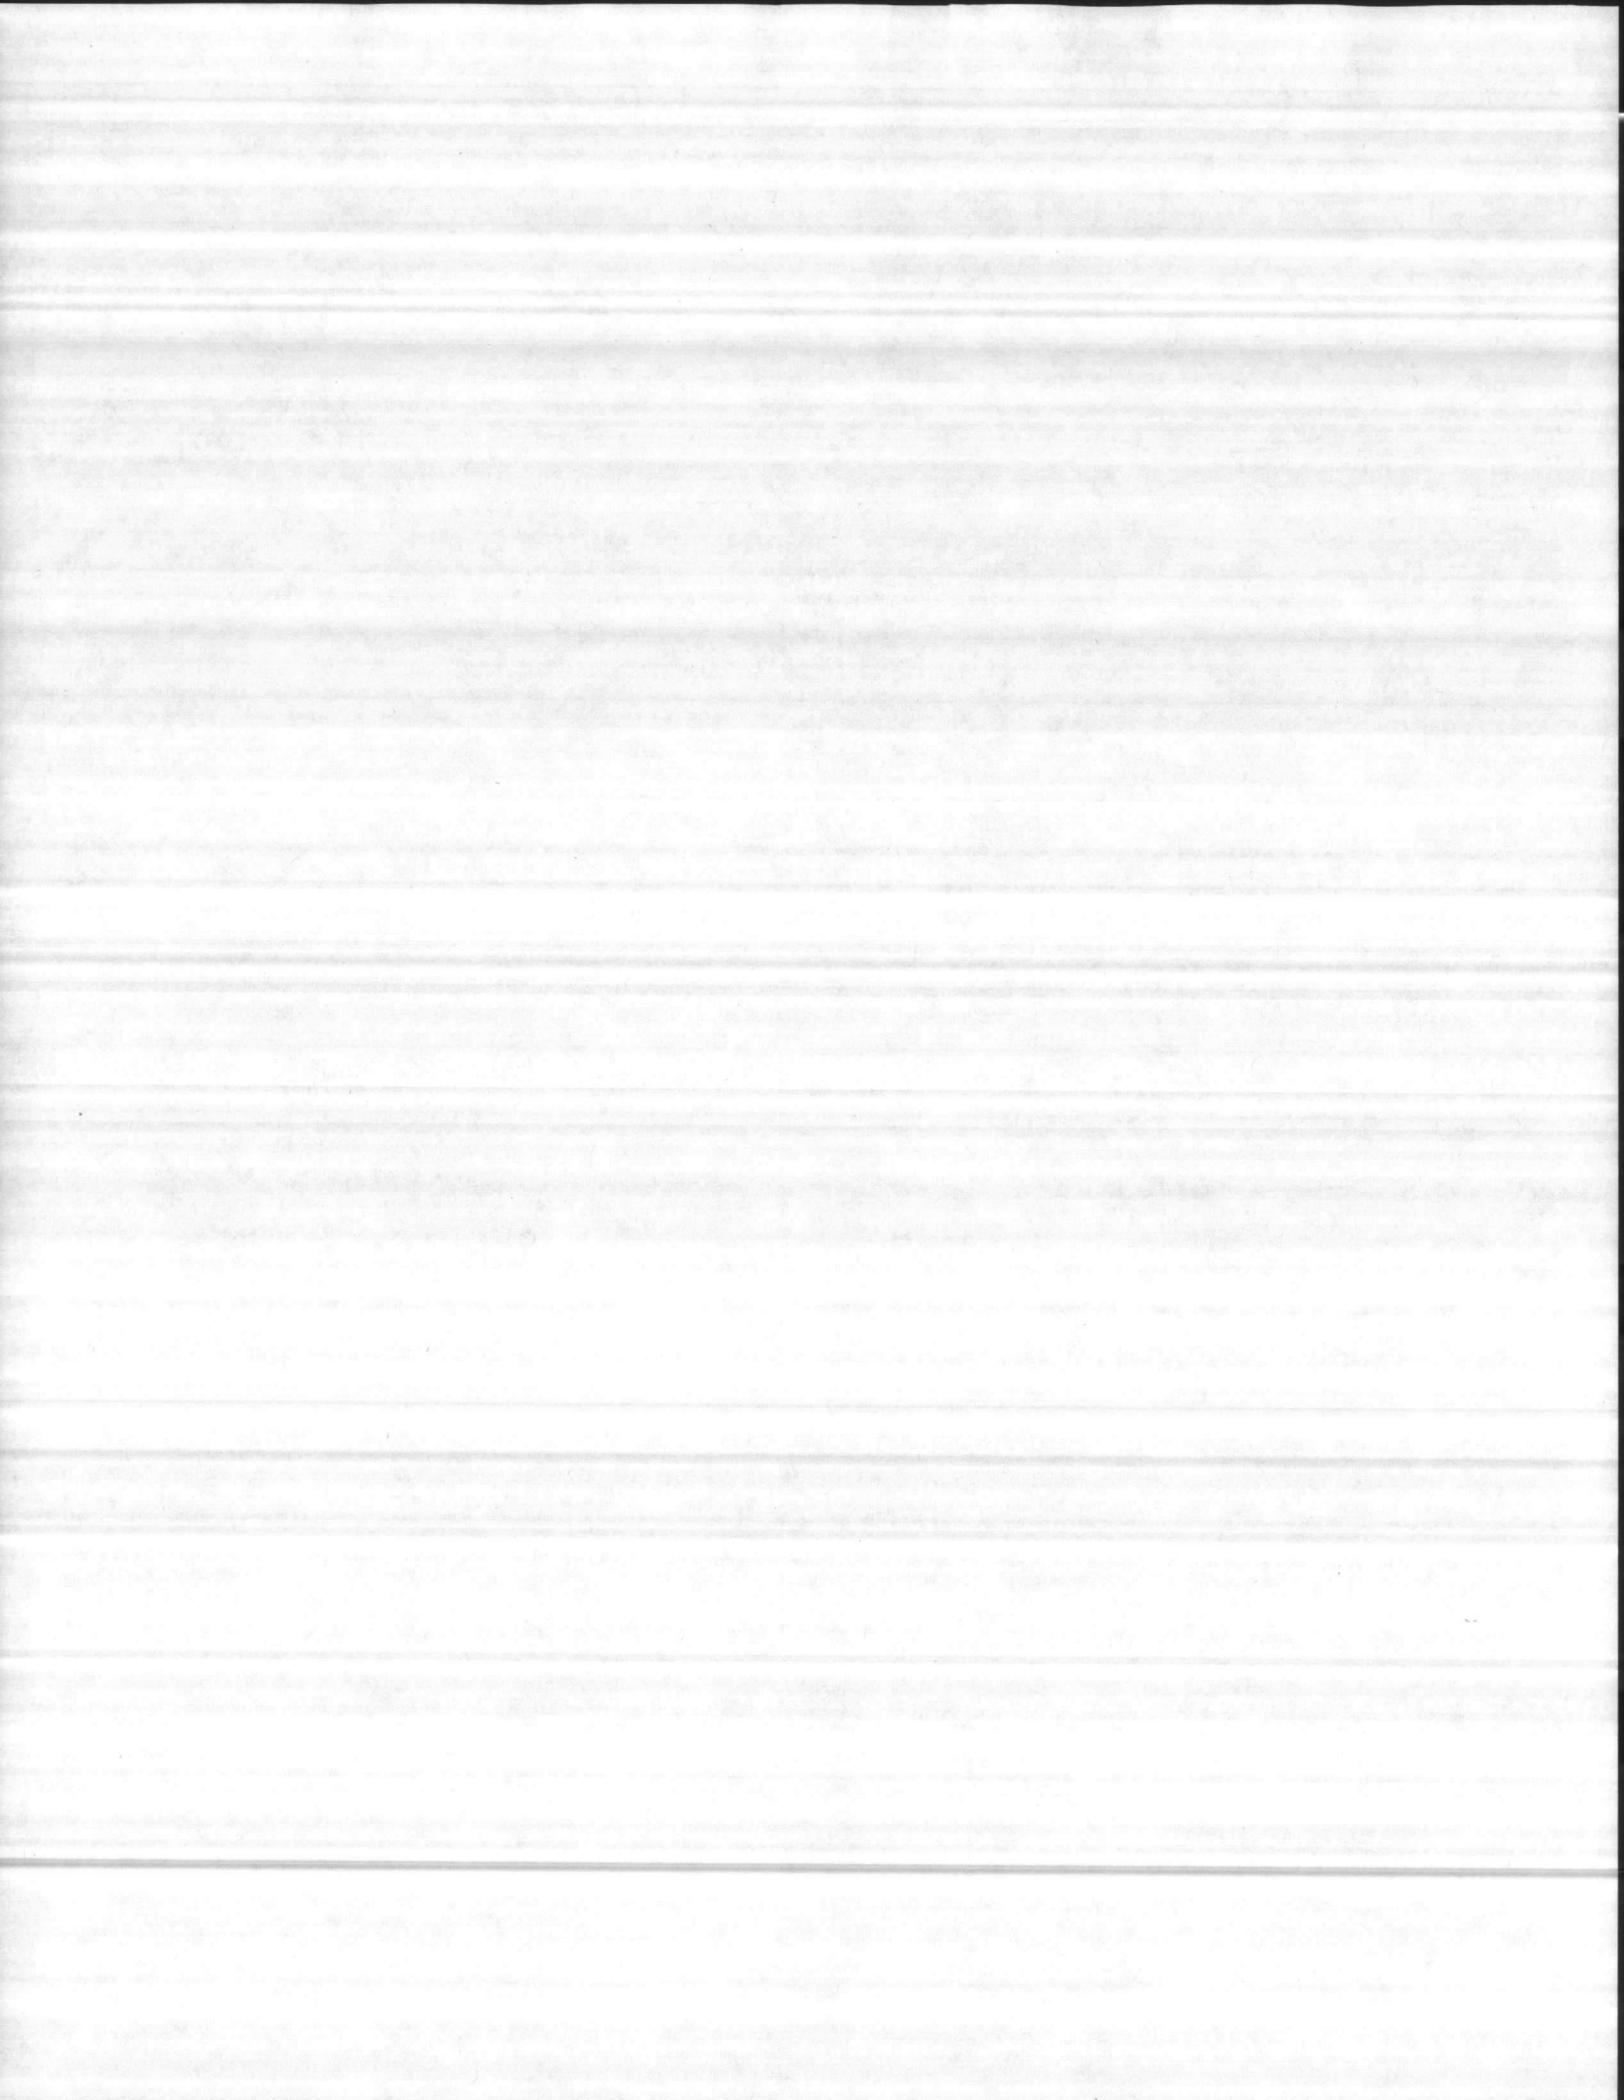




ACCESSORY SPECIALTIES, INC.

SURFACE MOUNTED SINGLE ROLL TOILET TISSUE HOLDER

0710

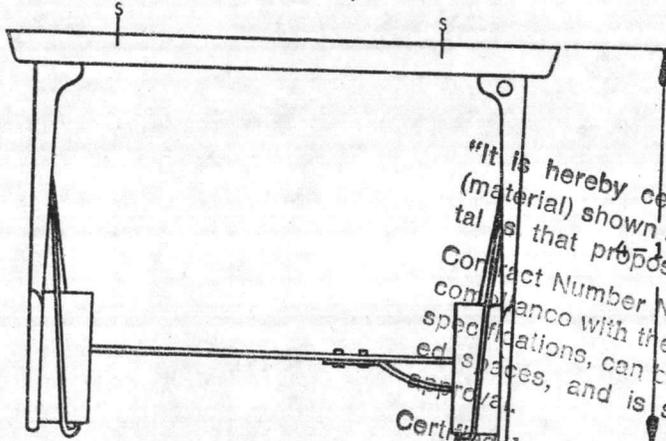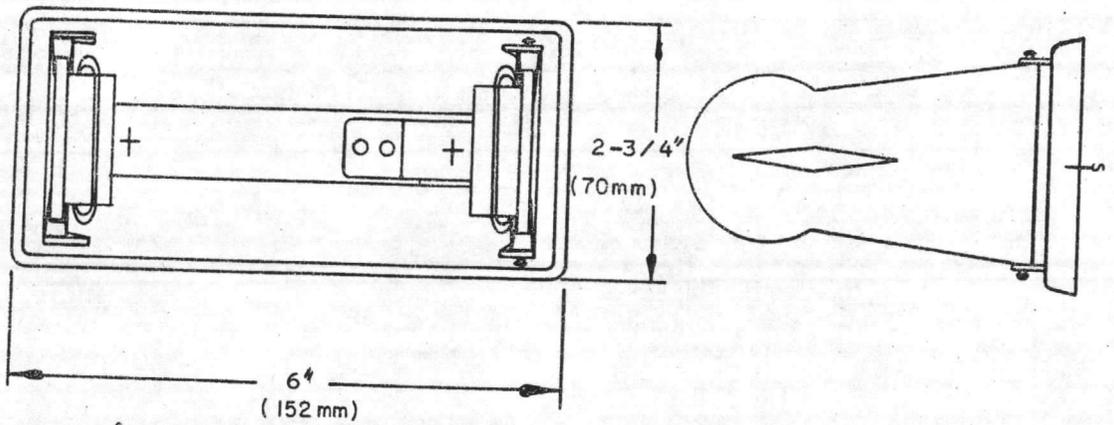

"It is hereby certified that the (equipment) (material) shown and proposed in this submission is that proposed to be incorporated into Contract Number N62470-81-C-176 in compliance with the Contract drawings and specifications, can be installed in the allocated spaces, and is submitted Government approval.
 Certified by D.S.
 Date 5-22-84

SPECIFICATIONS —

SURFACE MOUNTED SINGLE ROLL TOILET TISSUE HOLDER SHALL BE FABRICATED OF NO. 18 GAUGE STEEL, ENTIRE SURFACE SHALL BE HIGH POLISHED CHROME PLATED OVER NICKEL AND COPPER. MOUNTING SHALL BE THRU HORIZONTAL ELONGATED COUNTER SUNK SLOTS PROVIDED ON BACK WALL OF HOLDER. A BRAKE-SPRING ACTION DEVICE WILL BE PROVIDED TO PREVENT FREE ROLL OF TOILET TISSUE. A PILFER PROOF LOCKING DEVICE SHALL ALSO BE PROVIDED.

CAPACITY —

ONE (1) ROLL (STANDARD SIZE) TOILET TISSUE.

INSTALLATION —

HOLDER SHALL BE MOUNTED BY MEANS OF 3/4" (19mm) SLOTS PROVIDED IN BACK WALL TO ACCOMMODATE 3/16" (5mm) DIAMETER SCREWS FURNISHED BY MANUFACTURER.


MOUNTING SUGGESTIONS —

LOCATION - 32" (813mm) FROM TOP OF FINISHED FLOOR TO CENTER LINE OF HOLDER.

OPTIONAL —


UNIT AS SPECIFIED IS AVAILABLE WITH A SATIN CHROME FINISH. SPECIFY NO. 0710A

THIS MANUFACTURER RESERVES THE RIGHT TO MAKE CHANGES IN DESIGN OR DIMENSIONS WITHOUT FORMAL NOTICE.

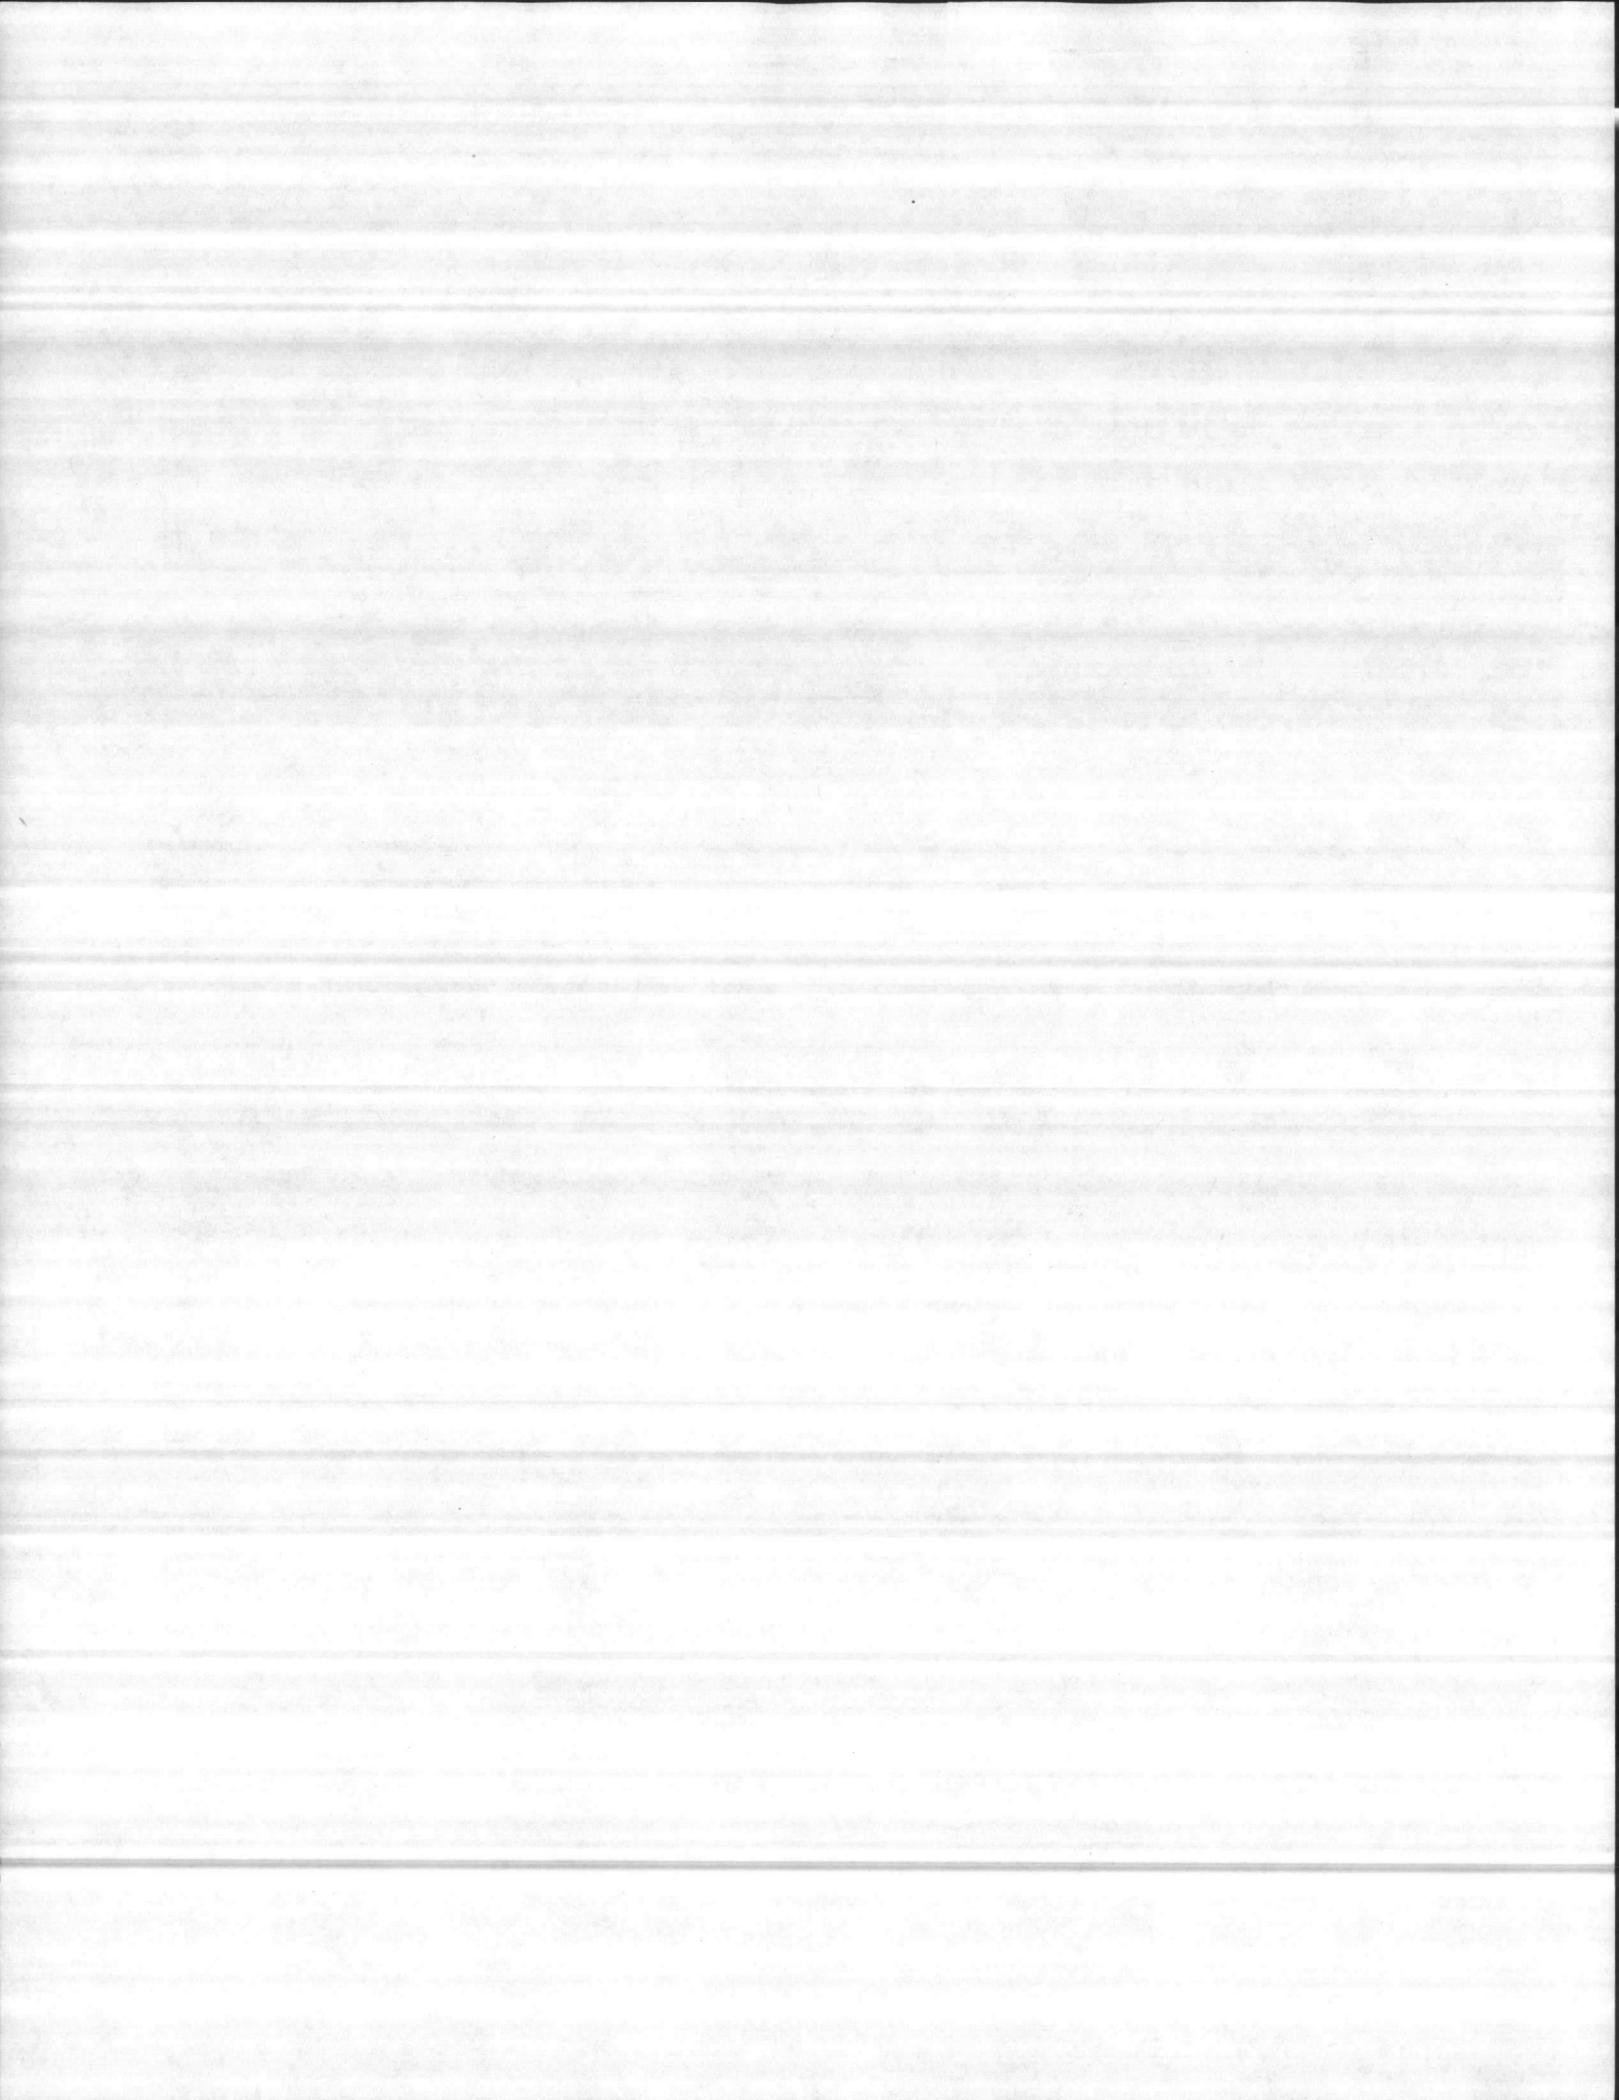



ACCESSORY SPECIALTIES, INC.
RECESSED PAPER TOWEL DISPENSER-DISPOSAL UNIT 0463

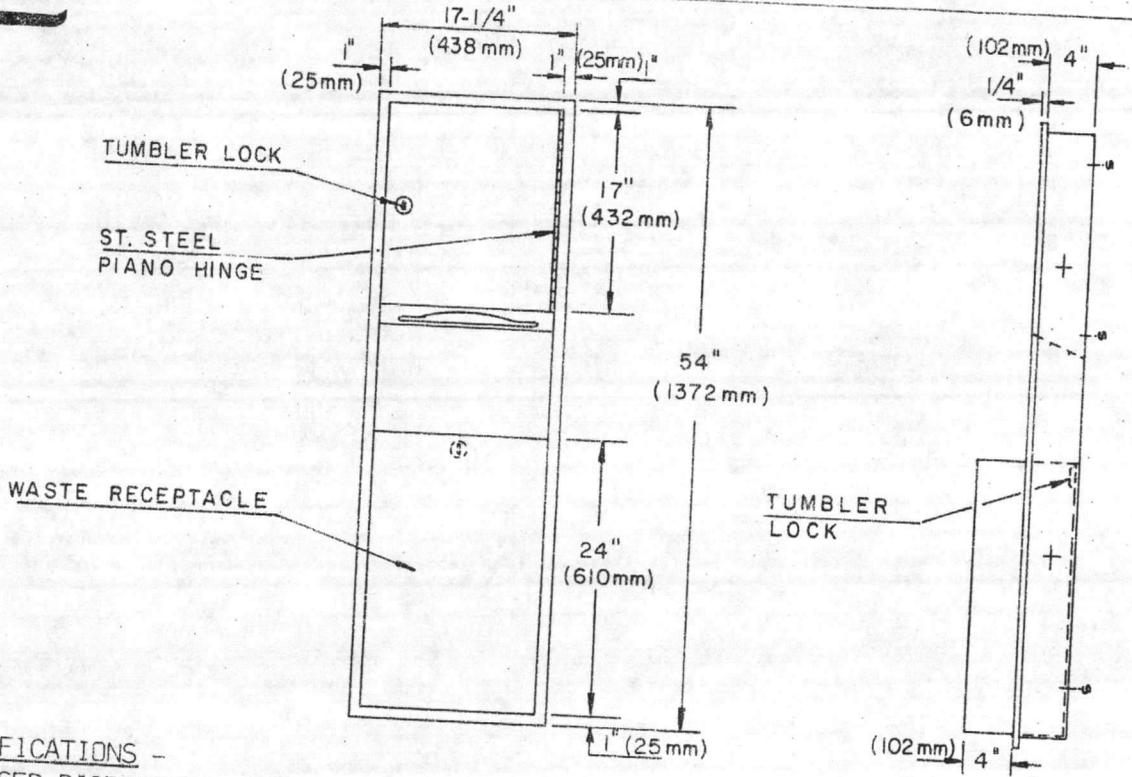

SPECIFICATIONS -

RECESSED DISPENSER AND SEMI-RECESSED DISPOSAL SHALL BE FABRICATED OF NO. 22 GAUGE, TYPE 304L, 18-8 ALLOY STAINLESS STEEL WITH A NO. 4 SATIN FINISH PROTECTED BY A POLY-VINYL COATING (PVC) EASILY REMOVED AFTER INSTALLATION. FACE TRIM SHALL BE ONE PIECE CONSTRUCTION WITH NO MITRES OR WELDING 1" WIDE AND RETURNING 1/4" TO THE WALL. CABINET SHALL HAVE NO EXPOSED FASTENING DEVICES OR SPOT WELDED SEAMS. DISPENSER DOOR SHALL BE DOUBLE PAN CONSTRUCTION, MOUNTED TO CABINET BODY ON HEAVY DUTY STAINLESS STEEL PIANO HINGE AND PROVIDED WITH PIN TUMBLER TYPE LOCK. REMOVABLE WASTE TO HAVE PIN TUMBLER LOCK KEYED ALIKE.

CAPACITY -

TOWEL DISPENSER - 600 C-FOLD OR 800 MULTIFOLD PAPER TOWELS
 DISPOSAL - 1.8 CU. FT. (13 GALS.)

WALL OPENING - WIDTH - 15-3/4" (400MM)

INSTALLATION - CABINET SHALL HAVE 3/16" SCREWS FURNISHED BY MANUFACTURER.

MOUNTING SUGGESTIONS -

LOCATION-16" (106MM) FROM TOP OF FINISHED FLOOR TO BOTTOM OF UNIT.

NOTES -

1. ASI #0463 IS PROVIDED WITH AN ADAPTER WHICH PERMITS CHANGING FROM C-FOLD TO A MULTI-FOLD TOWEL DISPENSER MECHANISM.
2. THIS UNIT IS KEYED ALIKE WITH OTHER ASI EQUIPMENT.


OPTIONAL:

- A. MIRRORED UPPER DOOR.

THIS MANUFACTURER RESERVES THE RIGHT TO MAKE CHANGES IN DESIGN OR DIMENSIONS WITHOUT FORMAL NOTICE.

"It is hereby certified that the (equipment) (material) shown and marked in this submittal is that proposed to be incorporated into Contract Number ASI-2470-St-C-176 in compliance with the Contract drawings and specifications, can be installed in the location and is submitted for Government approval."

Contracted by **D.S.**
 Date **5-22-84**


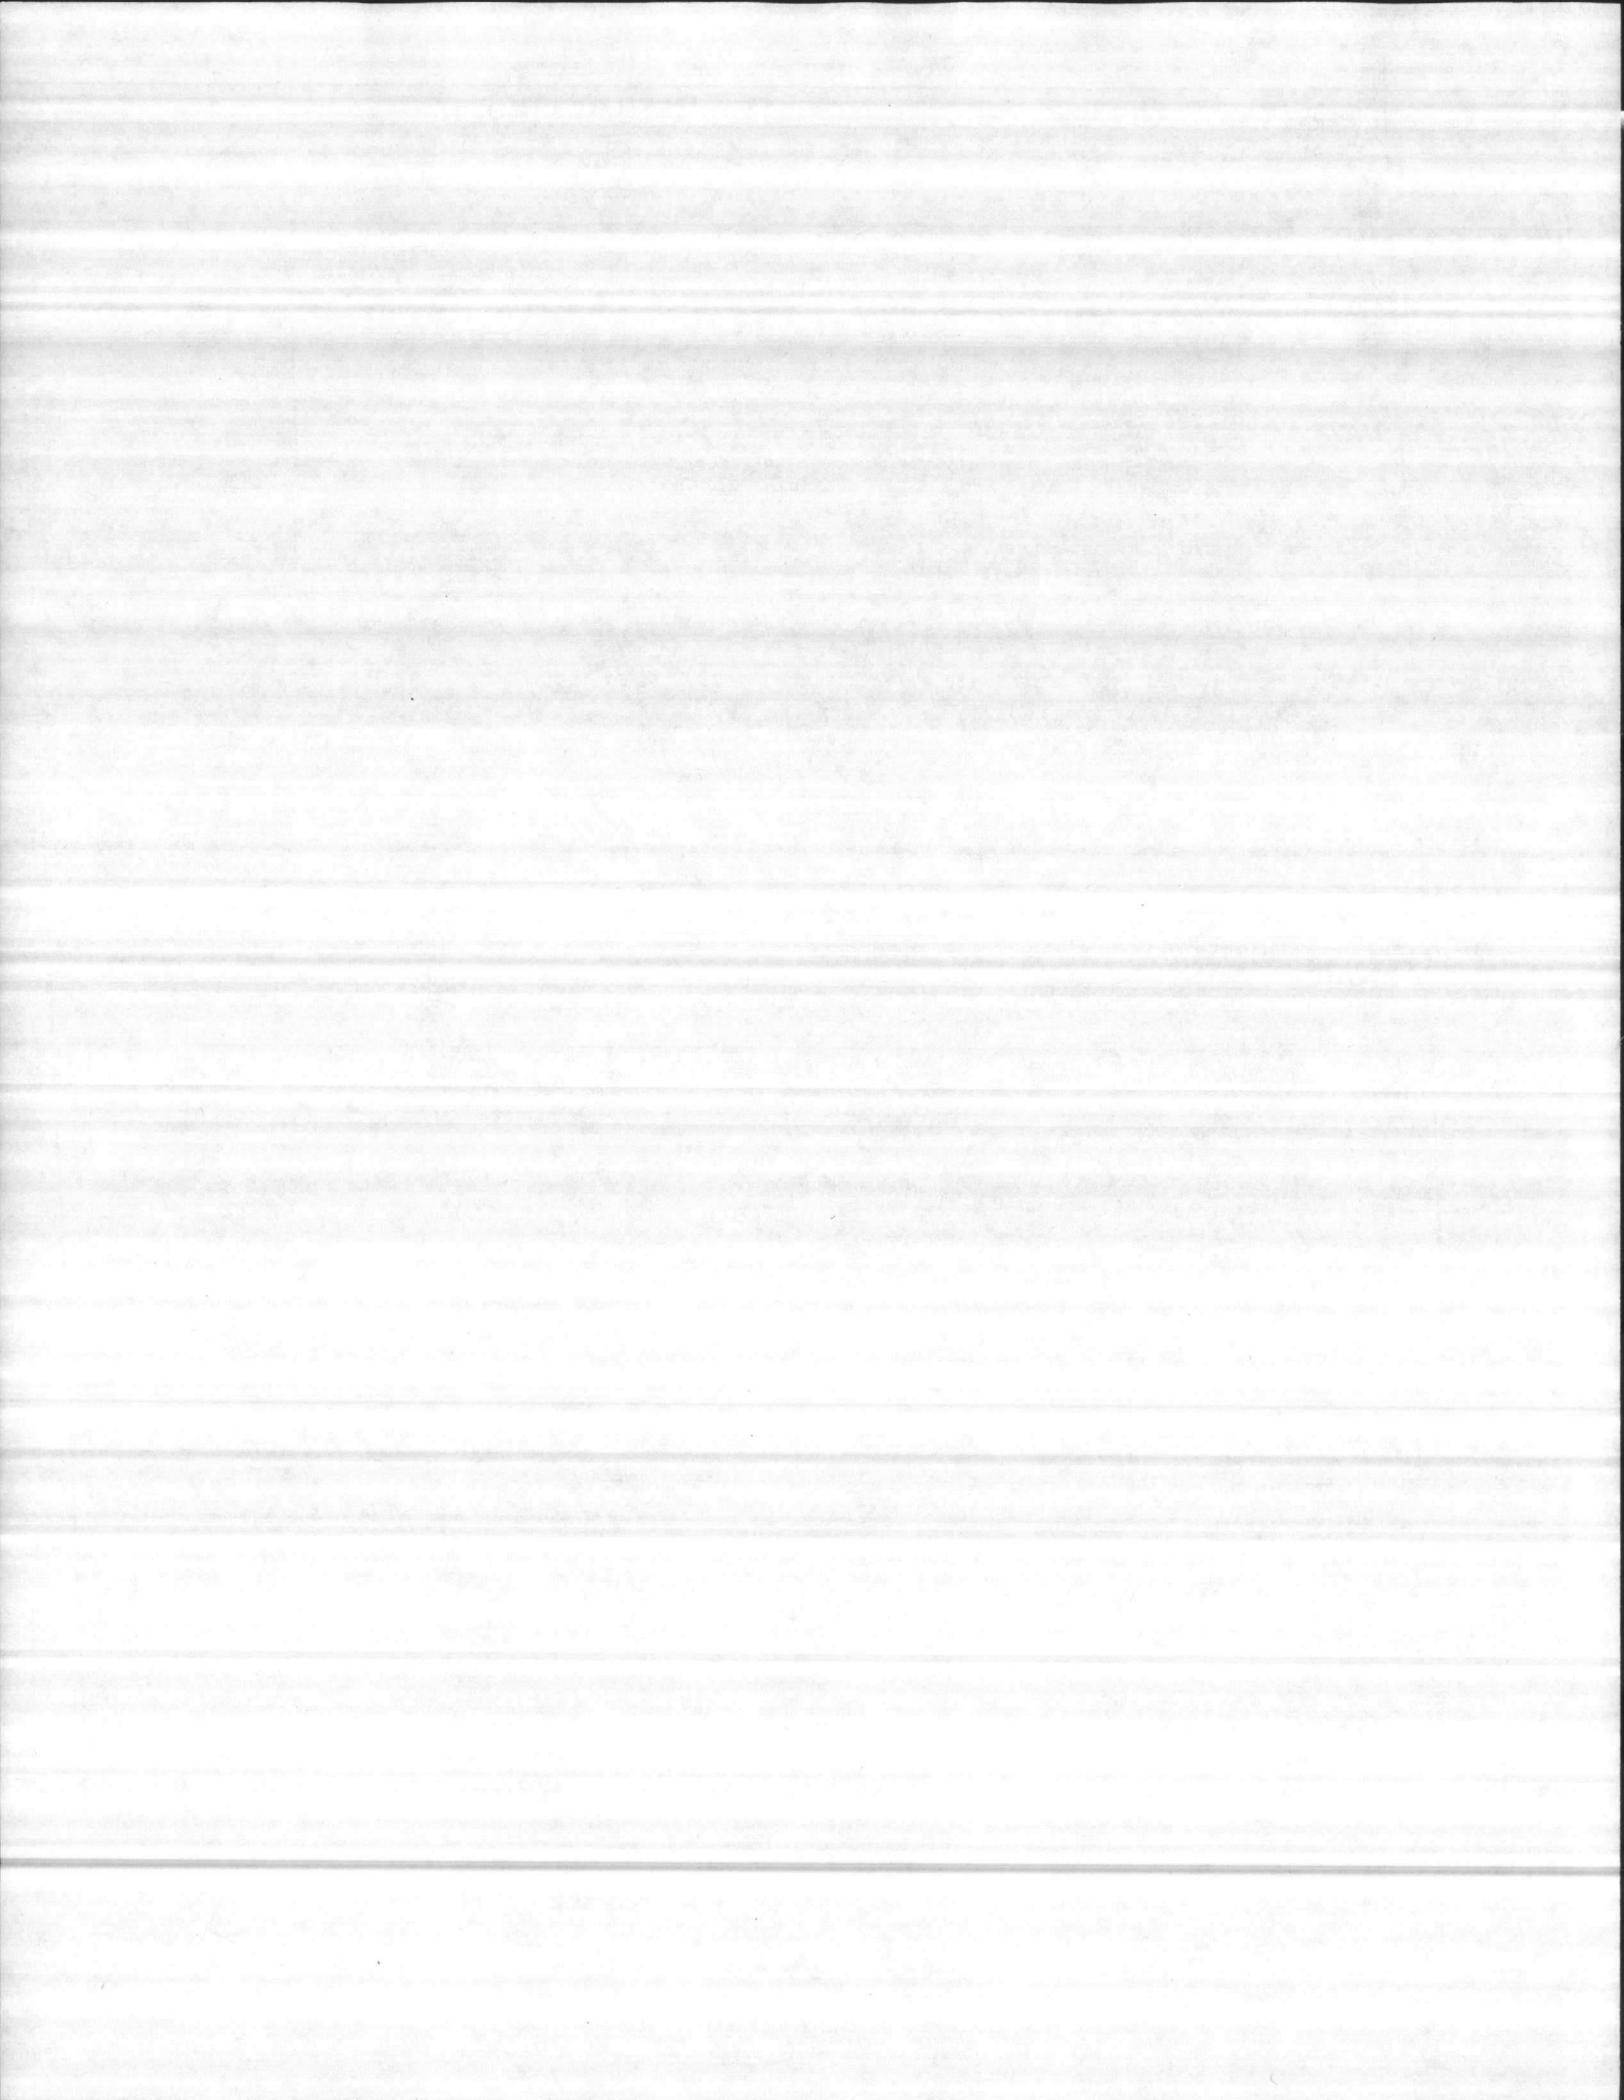




ACCESSORY SPECIALTIES, INC.

SURFACE MOUNTED DUAL NAPKIN TAMPON DISPENSER

0864

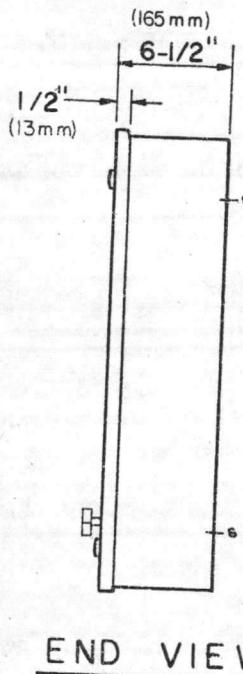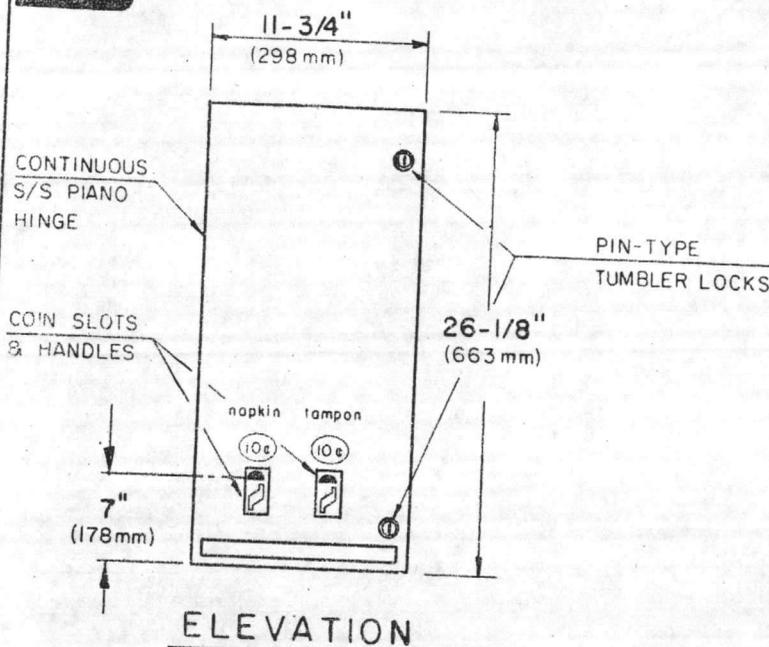

SPECIFICATION -

SURFACE MOUNTED DISPENSER SHALL BE FABRICATED OF 22 GAUGE, TYPE 304-L, 18-8 ALLOY STAINLESS STEEL WITH A #4 SATIN FINISH PROTECTED BY A POLYVINYL COATING (PVC) EASILY REMOVED AFTER INSTALLATION. CABINET SHALL HAVE NO EXPOSED FASTENING DEVICES OR SPOT WELDED SEAMS. DOOR SHALL BE FABRICATED OF HEAVY DUTY STAINLESS STEEL AND MOUNTED ON A CONTINUOUS S/S PIANO HINGE. A PAIR OF COIN BOXES SHALL BE FURNISHED AND SHALL HAVE PIN TUMBLER LOCKS. A PAIR OF DISPENSER MECHANISMS SHALL BE FURNISHED WITH APPROPRIATE COIN OPERATION. CONTRACT NUMBER N62470-81-0-176-5

CAPACITY - SIMULTANEOUSLY DISPENSES BOTH NAPKINS OR TAMPONS IN ANY OF THE FOLLOWING SIZES:

30 NAPKINS - 4-1/4" X 3" X 1-1/8"
(108MM X 76MM X 29MM)

STAYFREE #4
KOTEX #704, 707, 07010, 07040,
07045, 07300 OR 07320

It is hereby certified that the equipment shown and marked on this submittal is what has been proposed and incorporated into compliance with the Contract documents, in accordance with the specifications and is installed in the allocated spaces, and is submitted for Government approval.


Certified by D.S.
Date 5-22-81
GUARDS #247 OR 107
PURE-NAT #M-4
MODESS #4

27 TAMPONS - 5"
(127MM) CYLINDER
TAMPAX
MODESS TAMPONS

INSTALLATION - CABINET HAS (4) HOLES ACCOMMODATING 3/16" (5MM) DIA. SCREWS FOR MOUNTING TO FINISHED WALL.

MOUNTING SUGGESTION - LOCATION - 32" (813MM) TO 40" (1016MM) FROM TOP OF FINISHED FLOOR TO BOTTOM OF UNIT.

- NOTES:**
- THIS UNIT IS KEYED ALIKE WITH OTHER A.S.I. EQUIPMENT.
 - MECHANISM IS AVAILABLE FOR OPERATION BY MEANS OF THE FOLLOWING:
5¢ _____ 10¢ X 25¢ _____ GRATIS _____ PLEASE SPECIFY

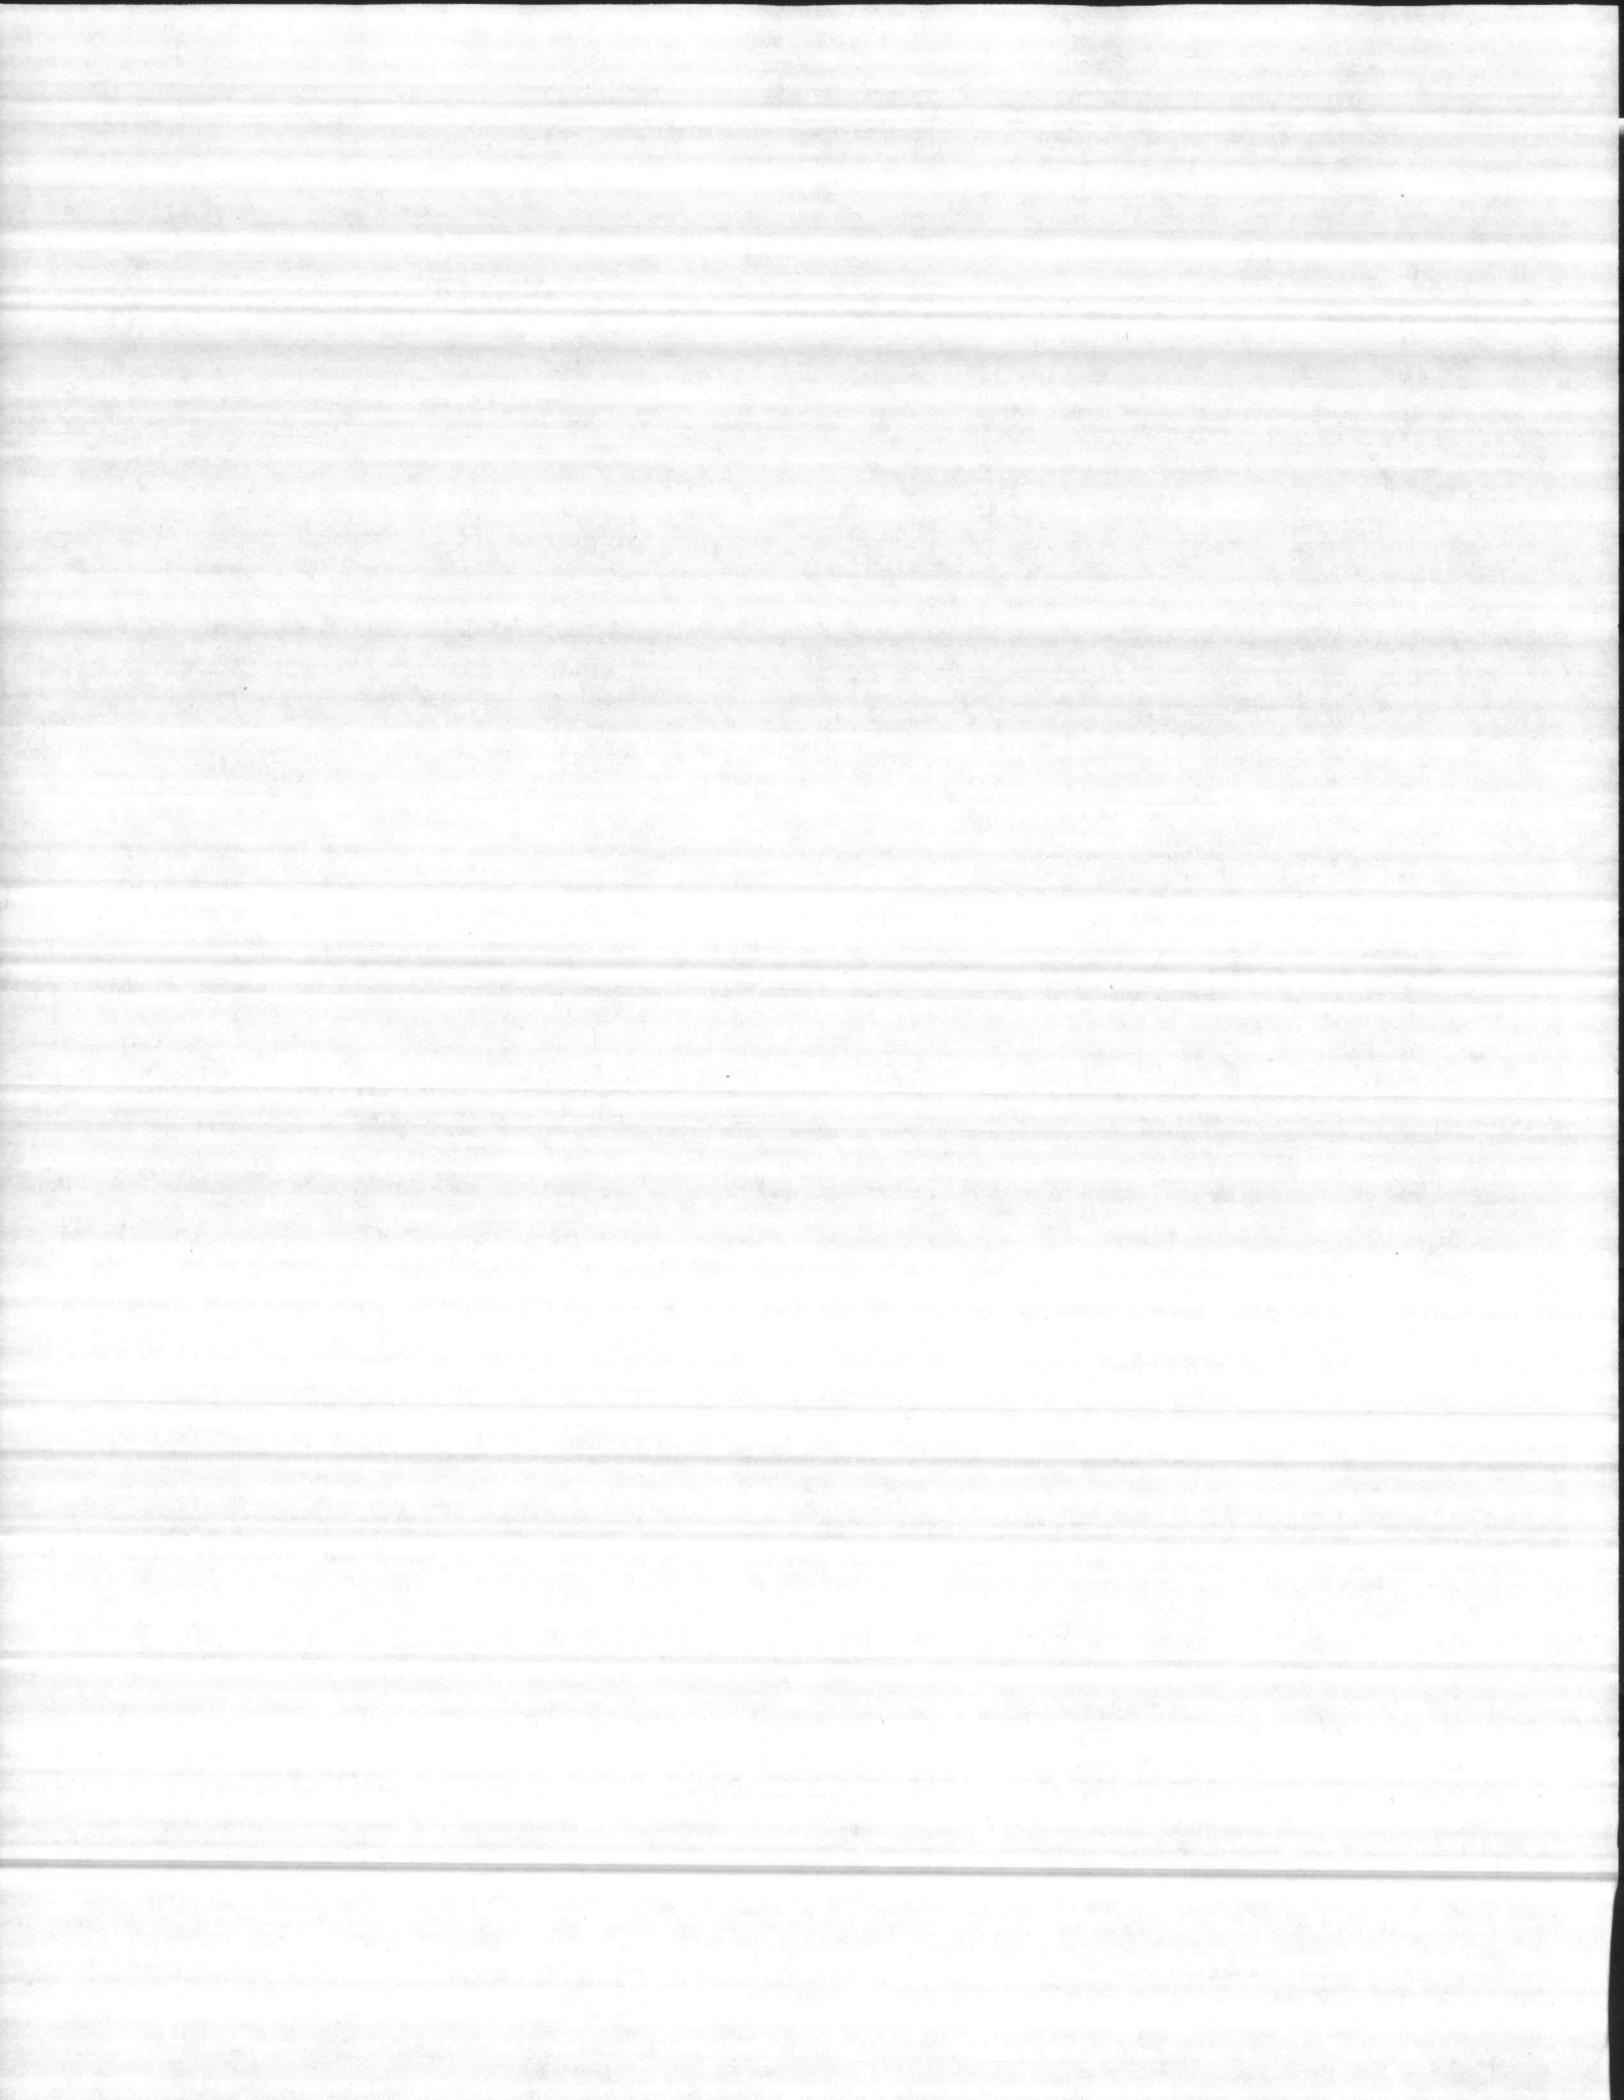




ACCESSORY SPECIALTIES, INC.

SANITARY NAPKIN DISPOSAL AND SHELF

0852 SH


With Deodorant Compartment

KEYHOLE MOUNTING SLOTS (3)

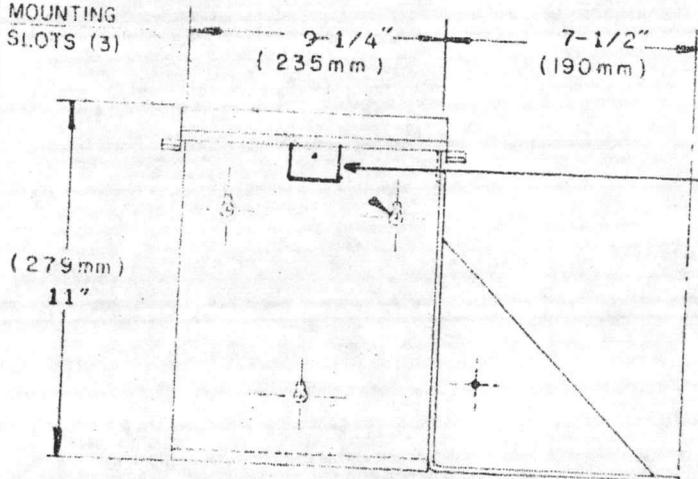


FRONT VIEW

Deodorant Compartment

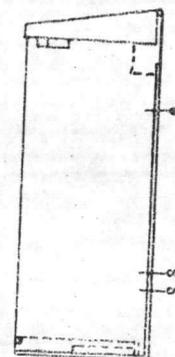

SIDE VIEW

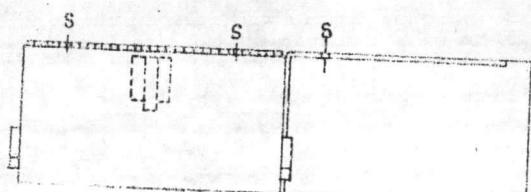

PLAN VIEW

"It is hereby certified that the (equipment) (material) shown and marked in this submission is that proposed to be incorporated into Contract NO. W-81-C-1766 in compliance with the Contract drawings and specifications, can be installed in the allocated spaces, and is submitted Government approval.

Certified by D.S.

Date 5-22-81

SPECIFICATION--

SANITARY NAPKIN DISPOSAL SHALL BE FABRICATED OF NO. 22 GAUGE, TYPE 304L-18-8 ALLOY STAINLESS STEEL WITH A NO. 4 SATIN FINISH PROTECTED BY A POLYVINYL COATING (PVC) EASILY REMOVED AFTER INSTALLATION. CABINET SHALL HAVE NO EXPOSED FASTENING DEVICES OR SPOT WELDED SEAMS. BOTH DOORS ARE TO BE HUNG ON A HEAVY DUTY STAINLESS STEEL PIANO HINGE. UPPER DOOR IS TO BE PROVIDED WITH A HEAVY GAUGE STAINLESS STEEL HANDLE ON EACH END. LOWER TRAP DOOR IS TO HAVE A HIDDEN STAINLESS STEEL SPRING TENSIONED SELF CATCHING LOCK AND SHALL BE HINGED ON FRONT FACE SO AS TO PERMIT CONVENIENT REMOVAL OF WASTE. REMOVABLE PURSE SHELF IS TO BE FABRICATED OF 22 GAUGE STAINLESS STEEL WITH FINISH TO MATCH CABINET BODY.

CAPACITY--


396 CUBIC INCHES. (10.006m³)

INSTALLATION--

THREE CONCEALED MOUNTING HOLES ARE TO BE PROVIDED IN REAR OF CABINET THAT SHALL ACCOMMODATE #10 SCREWS FURNISHED BY THE MANUFACTURER.

MOUNTING SUGGESTION--

LOCATION - 18" FROM TOP OF FINISHED FLOOR TO BOTTOM OF DISPOSAL.
(57mm)

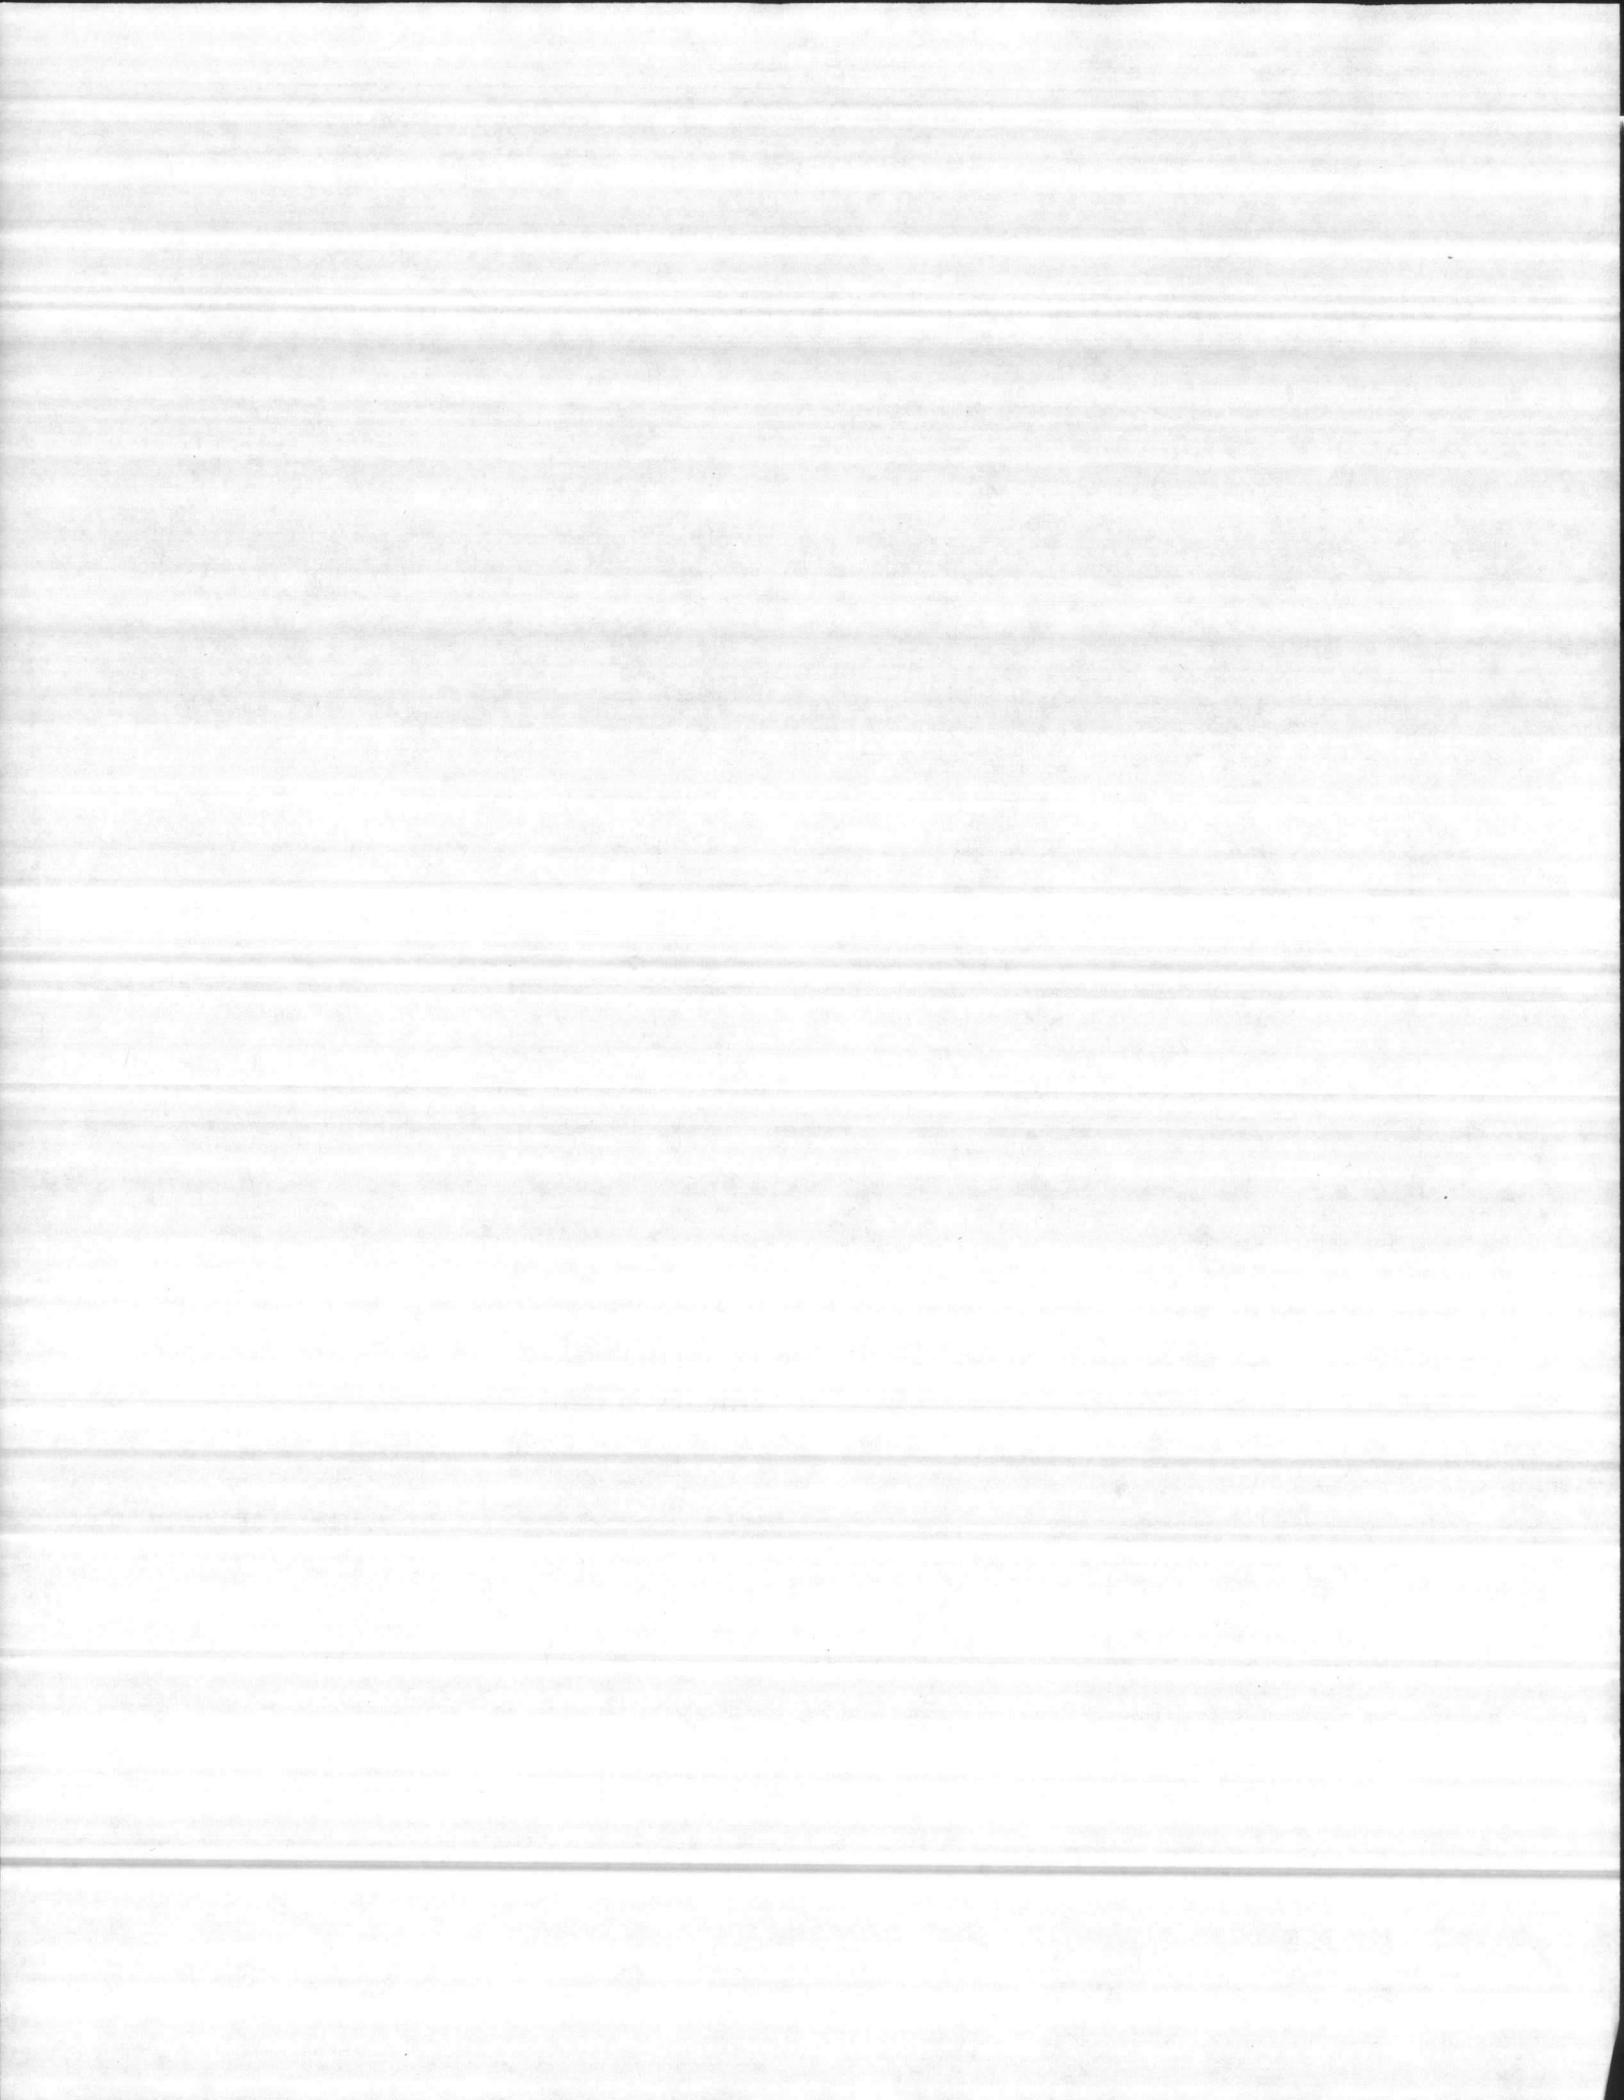




ACCESSORY SPECIALTIES, INC.

DOUBLE ROBE HOOK

0745

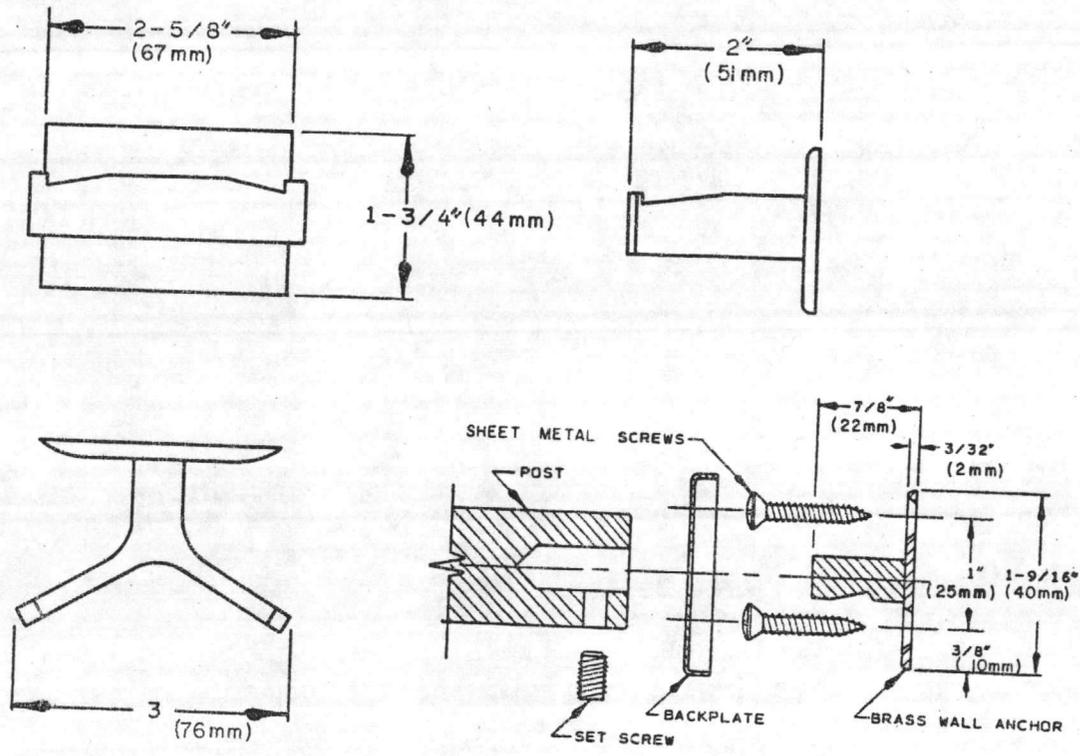

SPECIFICATIONS—

HOOK SHALL BE FABRICATED ENTIRELY OF BRASS. ALL EXPOSED SURFACES TO BE HIGH POLISHED, TRIPLE PLATED HEAVY CHROME NICKEL AND COPPER. A CHROME PLATED STAMPED BACK PLATE SHALL CONCEAL THE BRASS WALL DOWEL-ANCHOR. CHROME PLATED HOOK IS TO FIT SNUGLY OVER DOWEL. ENTIRE ASSEMBLY IS TO BE MADE THEFT PROOF BY MEANS OF A TEMPERED HARDENED STAINLESS STEEL SET SCREW FITTING THROUGH HOOK INTO NOTCH PROVIDED IN DOWEL

INSTALLATION—

WALL ANCHOR SHALL HAVE TWO COUNTER SUNK HOLES TO ACCOMMODATE S.M. SCREWS FURNISHED BY MANUFACTURER.


MOUNTING SUGGESTIONS—



LOCATION - 66" FROM TOP OF FINISHED FLOOR TO CENTER LINE OF HOOK. (1676mm)

"It is hereby certified that the (equipment) (material) shown and marked in this submittal is that proposed to be incorporated into Contract Number N62470-81-C-1766 in compliance with the Contract drawings and specifications, can be installed in the allocated spaces, and is submitted Government approval.

Certified by DS

Date 5-22-84

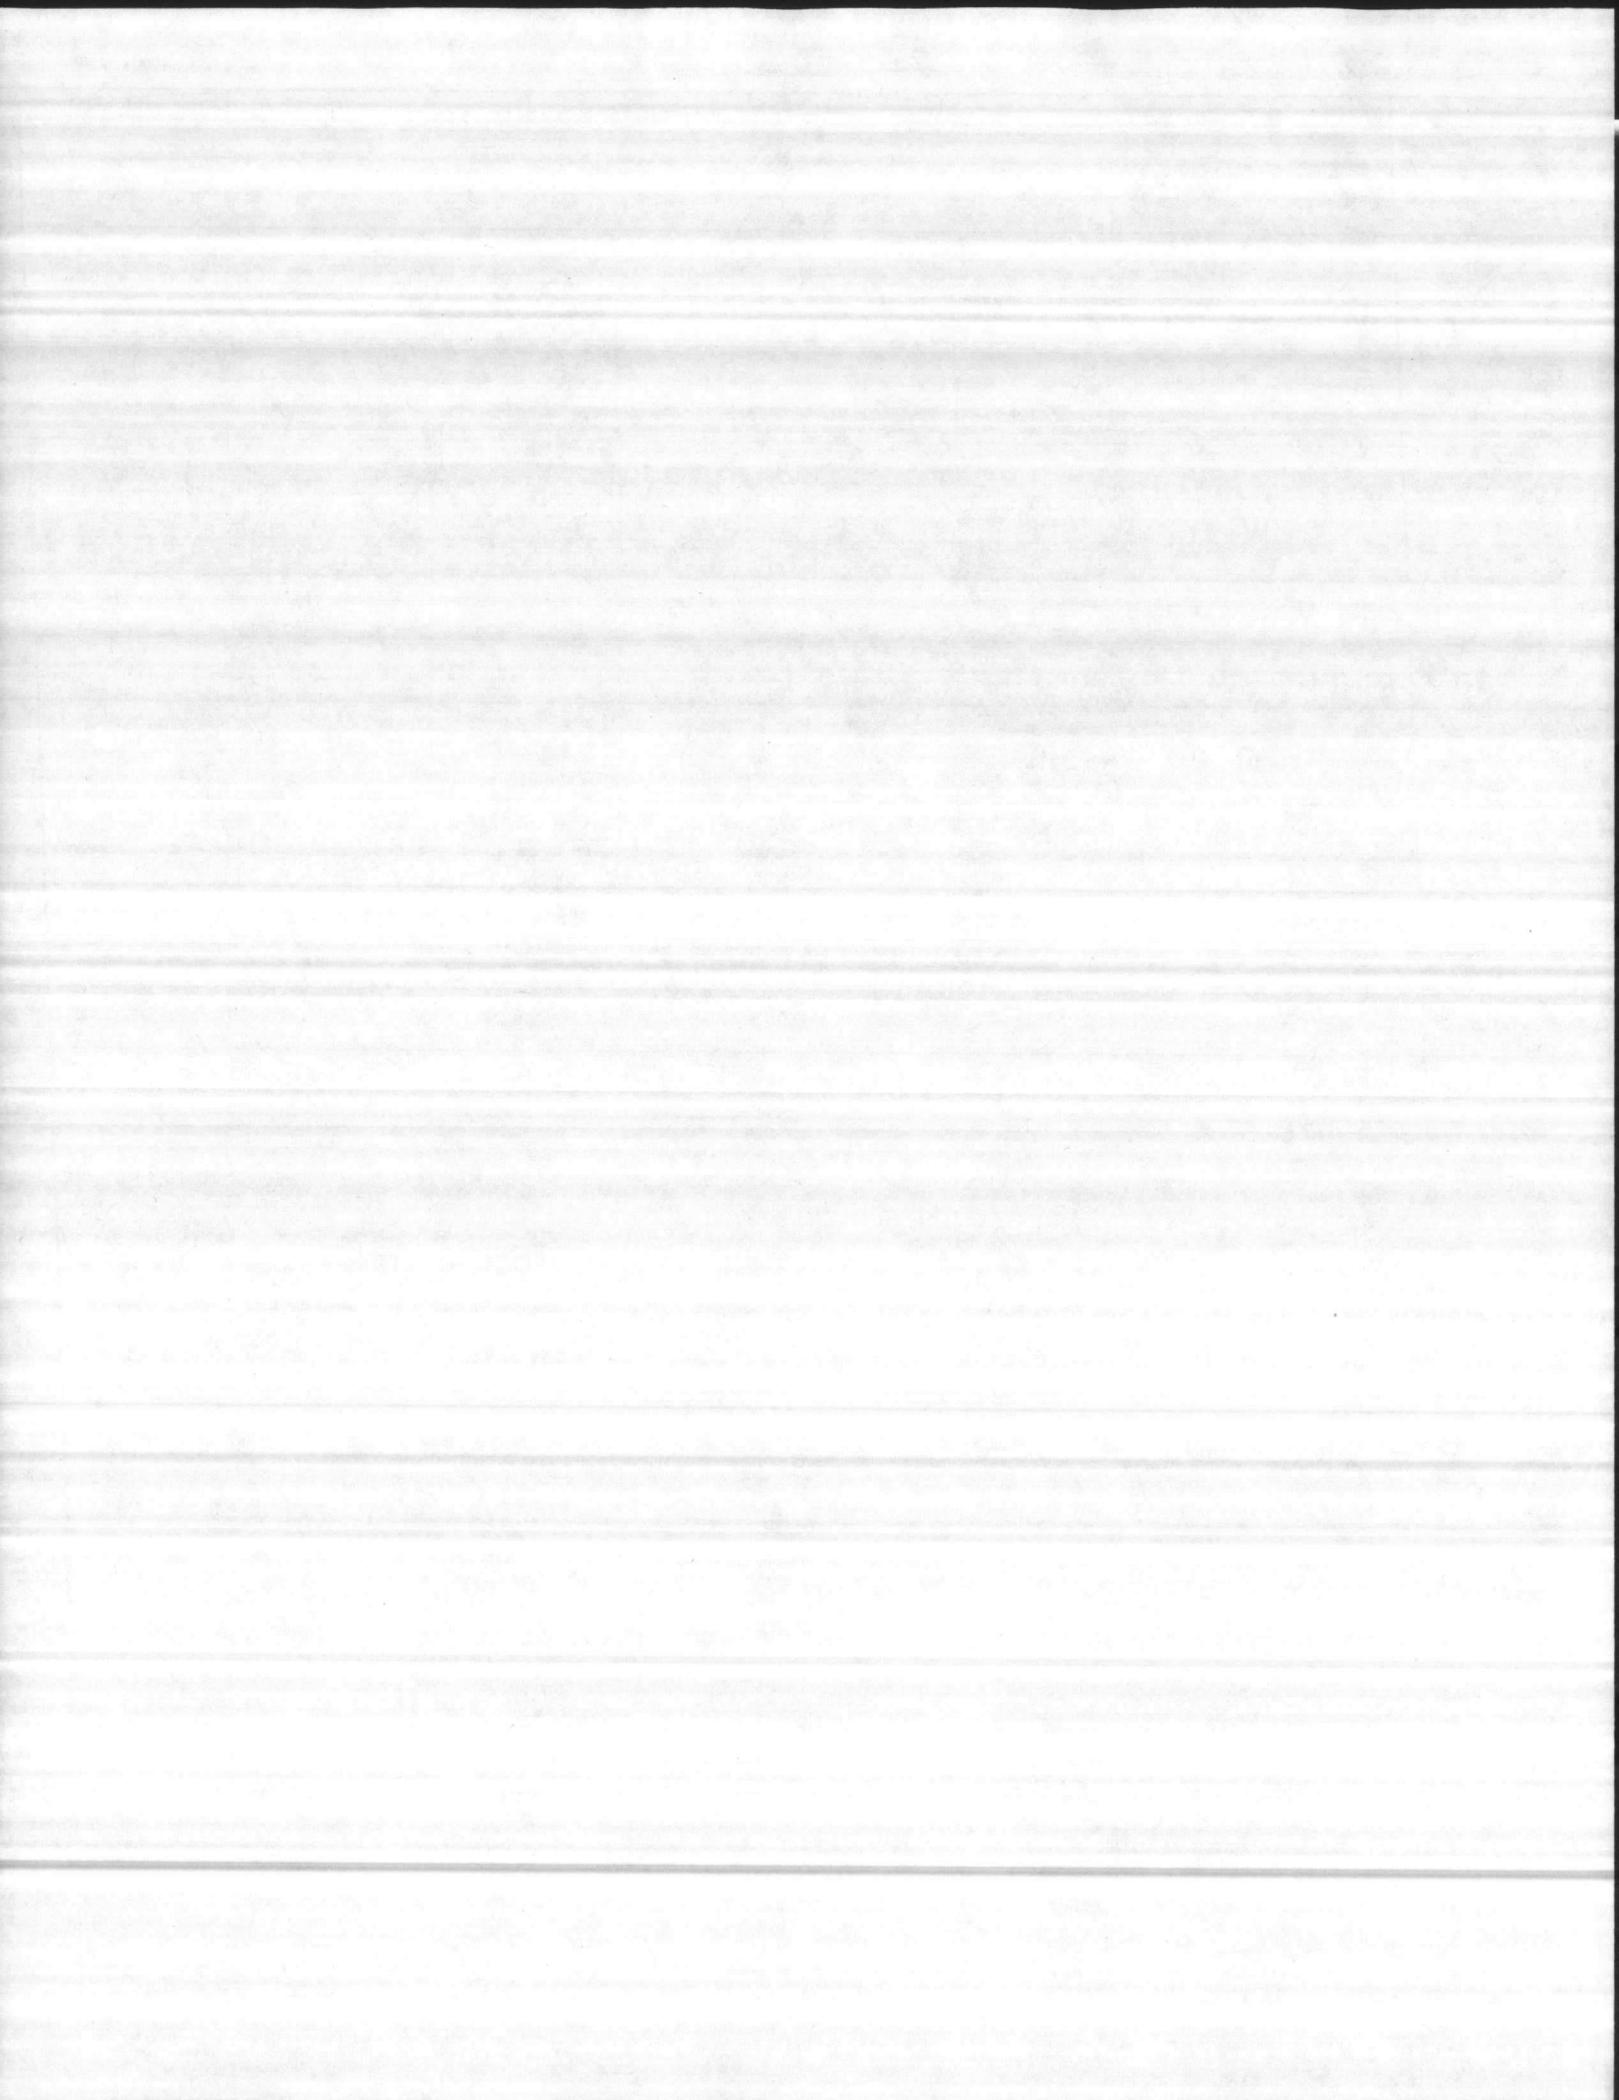

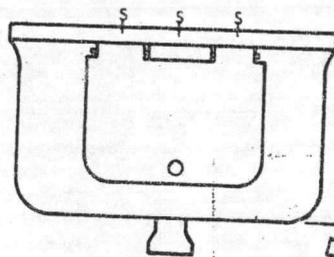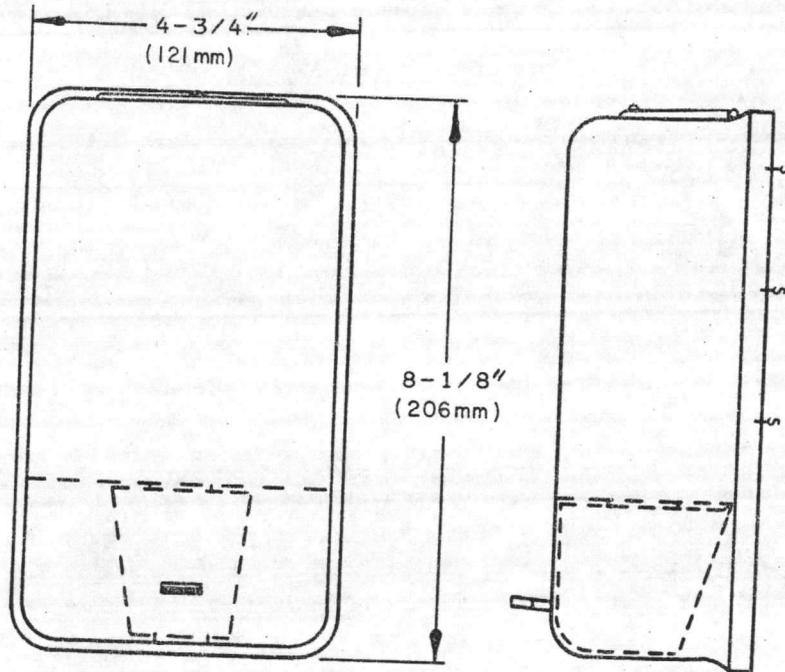

"It is hereby certified that the (equipment) (material) shown and marked in this submittal is that proposed to be incorporated into Contract Number N62470-81-C-176. It is in compliance with the Contract drawings and specifications, and is submitted for approval." *D.S.*

Certified by *D.S.*

Date *5-22-84*

SPECIFICATION—

SURFACE MOUNTED POWDER SOAP DISPENSER SHALL BE FABRICATED OF NO. 20 GAUGE STEEL WITH ALL SURFACES CHROME PLATED OVER COPPER AND NICKEL. MOUNTING SHALL BE BY MEANS OF INTERLOCKING WEDGE BRACKETS AND TO BE LOCKED IN PLACE BY MEANS OF A SCREW INSTALLED THROUGH VANDAL PROOF REFILL CAP.

CAPACITY—


32 OUNCES.

INSTALLATION —

BRACKET WILL BE PROVIDED WITH MOUNTING HOLES TO ACCOMMODATE 3/16" (5mm) SCREWS FURNISHED BY MANUFACTURER.

MOUNTING SUGGESTIONS—


LOCATION - 42" (1067mm) FROM TOP OF FINISHED FLOOR TO BOTTOM OF UNIT OR 6" ABOVE WASH BASIN.

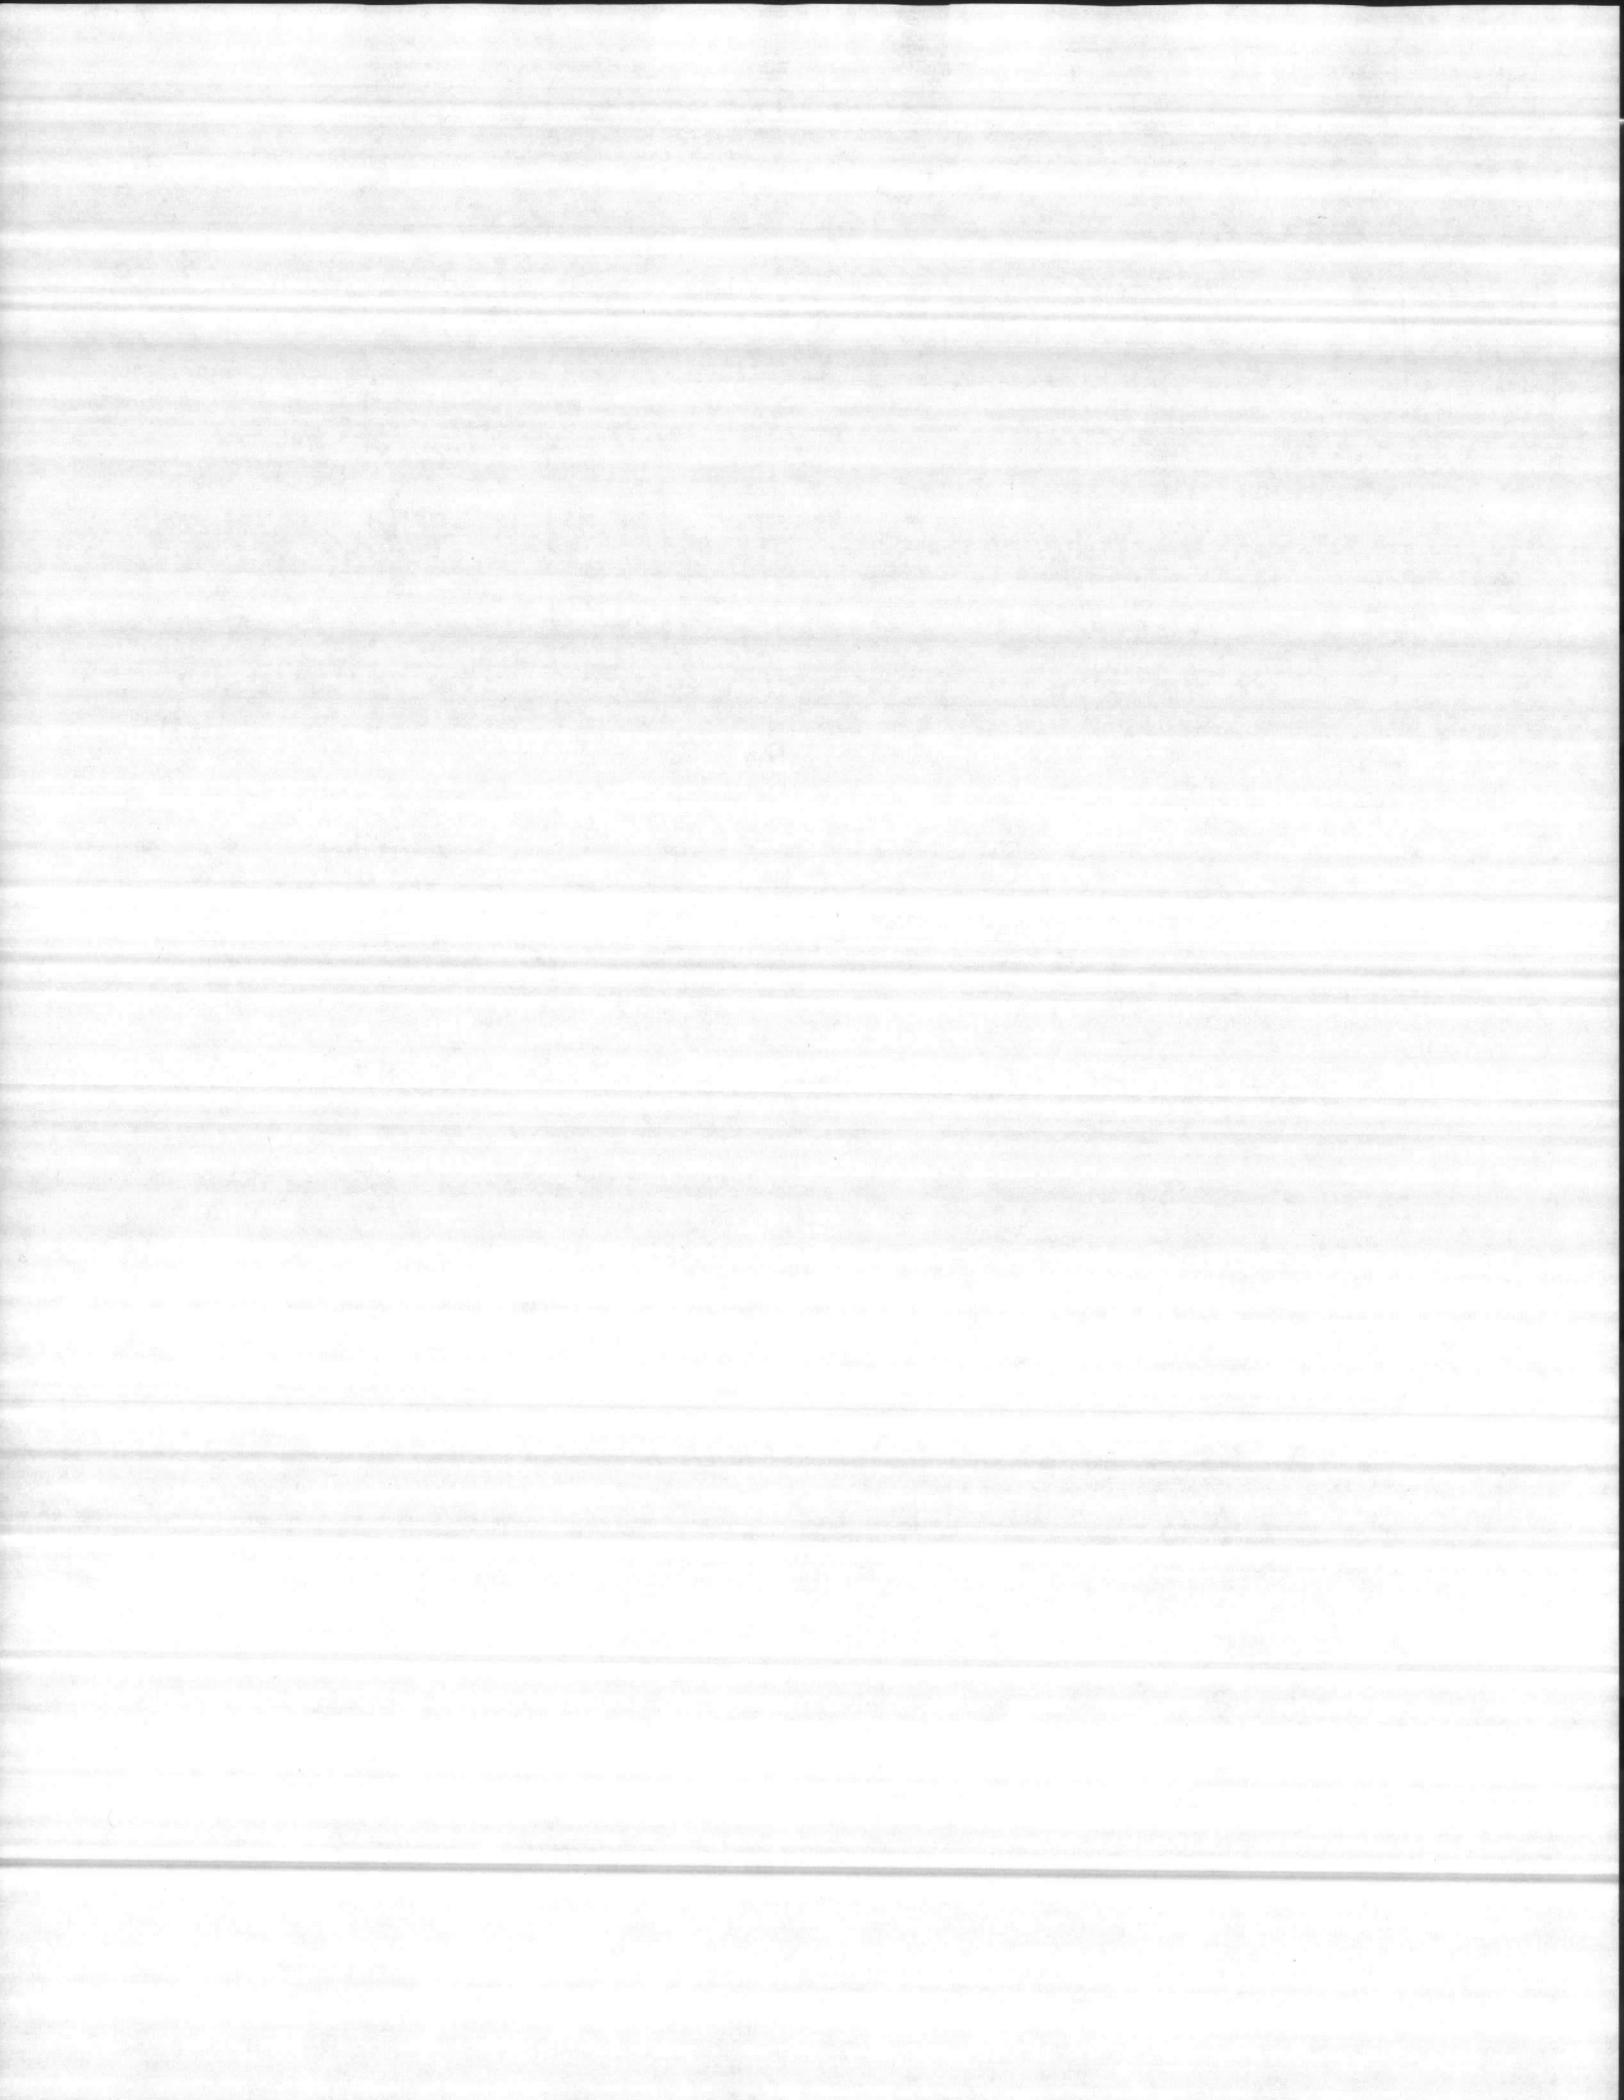



ACCESSORY SPECIALTIES, INC.


SHOWER CURTAIN RODS

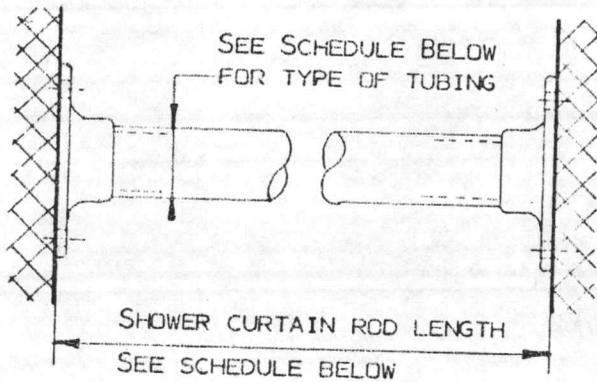

- #1204 - 1" TUBE CHROME PLATED STEEL (25mm)
- #1204A - 1-1/4" TUBE CHROME PLATED STEEL (32mm)
- #1205 - 1" TUBE CHROME PLATED BRASS (25mm)
- #1205A - 1-1/4" TUBE CHROME PLATED BRASS (32mm)
- #1206 - 1" TUBE STAINLESS STEEL (25mm)
- #1206A - 1-1/4" TUBE STAINLESS STEEL 18GA. (.049) (32mm)


ITEM #	TYPE	LENGTH	QTY.
<p>"It is hereby certified that the (equipment) (material) shown and marked in this submittal is that proposed to be incorporated into Contract Number M62470. It is in compliance with the Contract drawings and specifications, can be installed in the allocated spaces, and is submitted for Government approval.</p> <p>Certified by <u>D.S.</u></p> <p>Date <u>5-22-84</u></p>			

CURTAIN ROD FLANGES

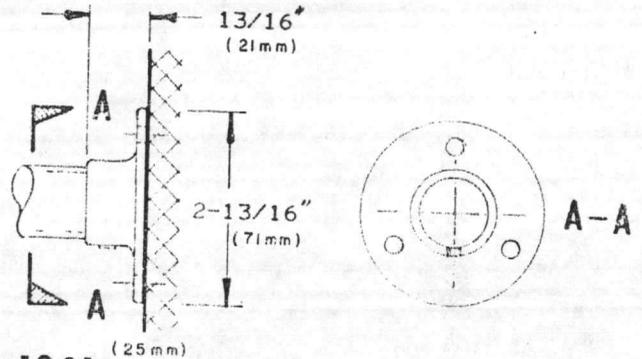


1201 1" BRACKET CHROME PLATED BRASS

1201A 1-1/4" BRACKET CHROME PLATED BRASS

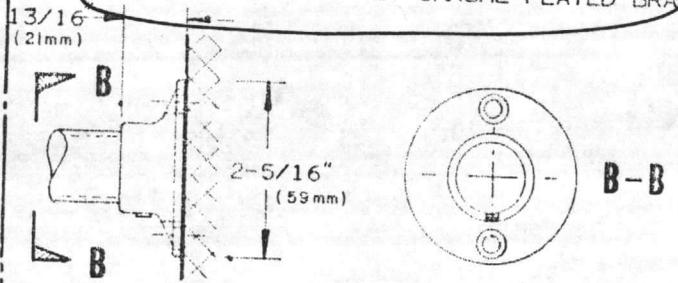


1202 1" BRACKET DIE CAST ZINC ALLOY

1202A 1-1/4" BRACKET DIE CAST ZINC ALLOY

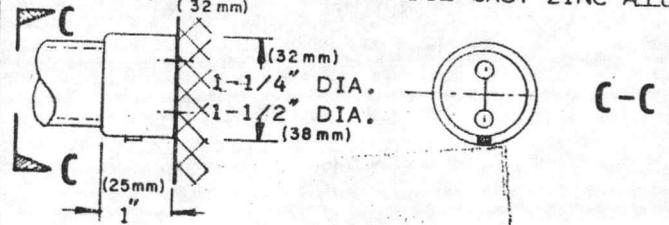

1203 1" BRACKET CHROME PLATED STEEL


1203A 1-1/4" BRACKET CHROME PLATED STEEL

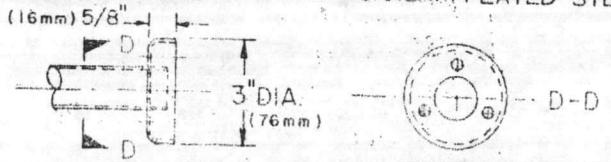

1207 ST. STL. II GA. FLANGE FOR 1" O.D. SHOWER CURTAIN ROD.

1207A ST. STL. II GA. FLANGE FOR 1-1/4" O.D. SHOWER CURTAIN ROD.

ITEM #	TYPE	NO. OF PAIRS

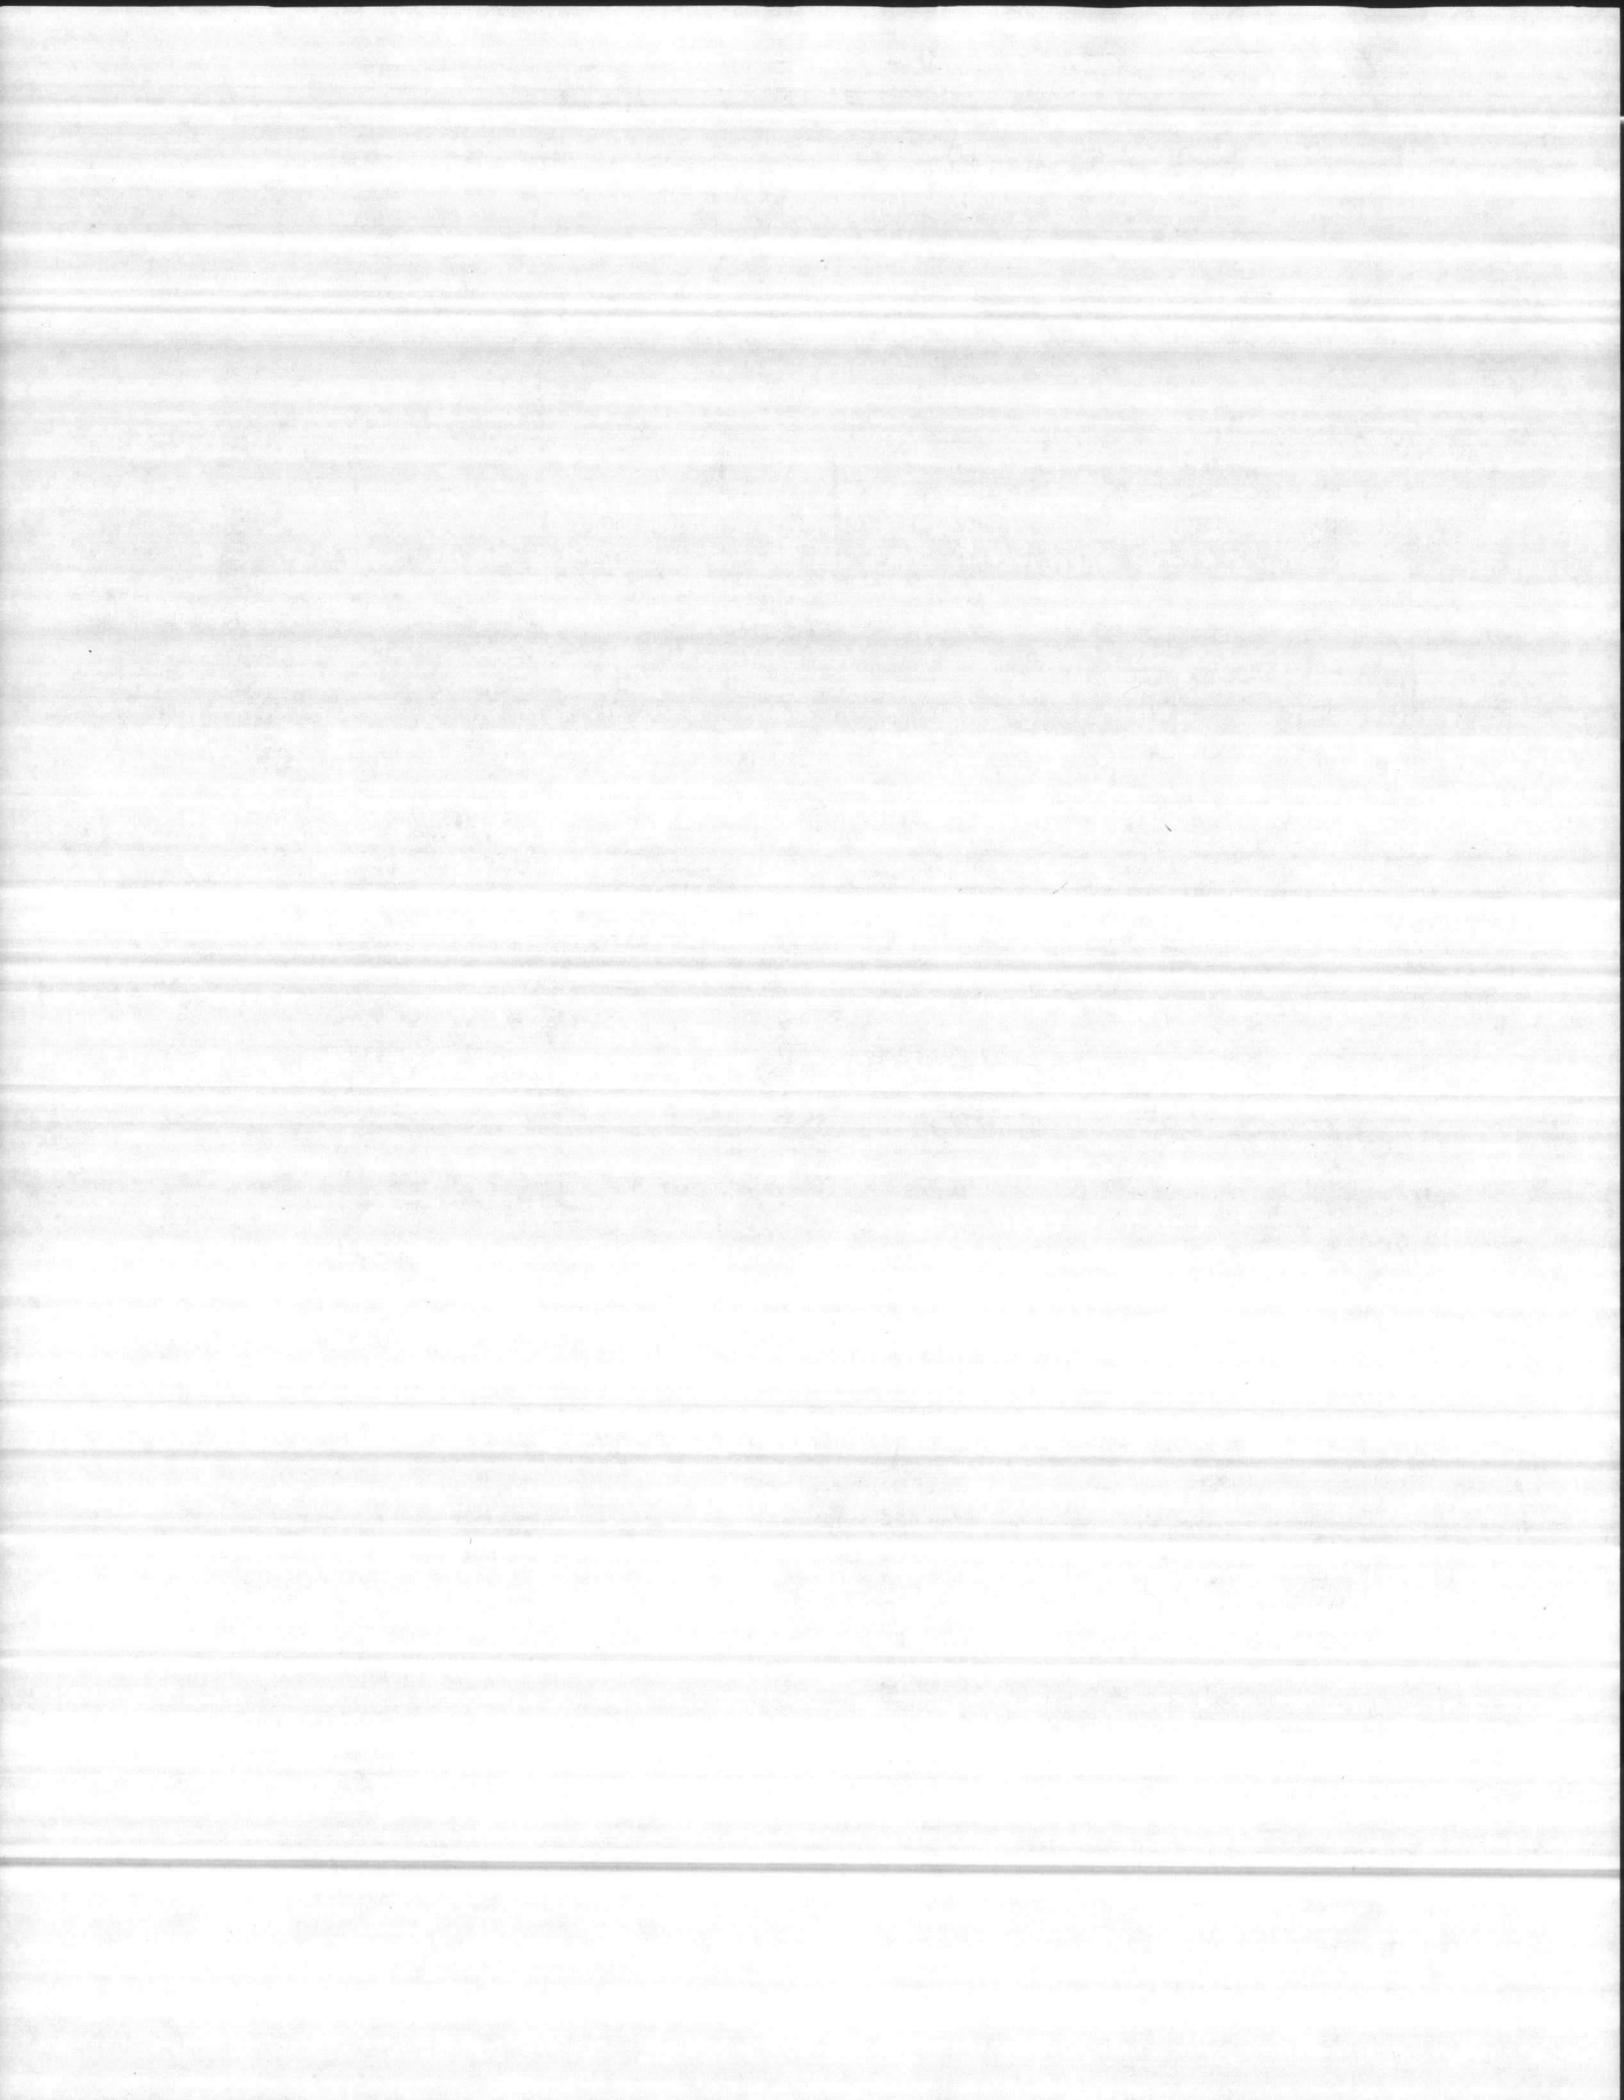




ACCESSORY SPECIALTIES, INC.

MOP RACK

0796B

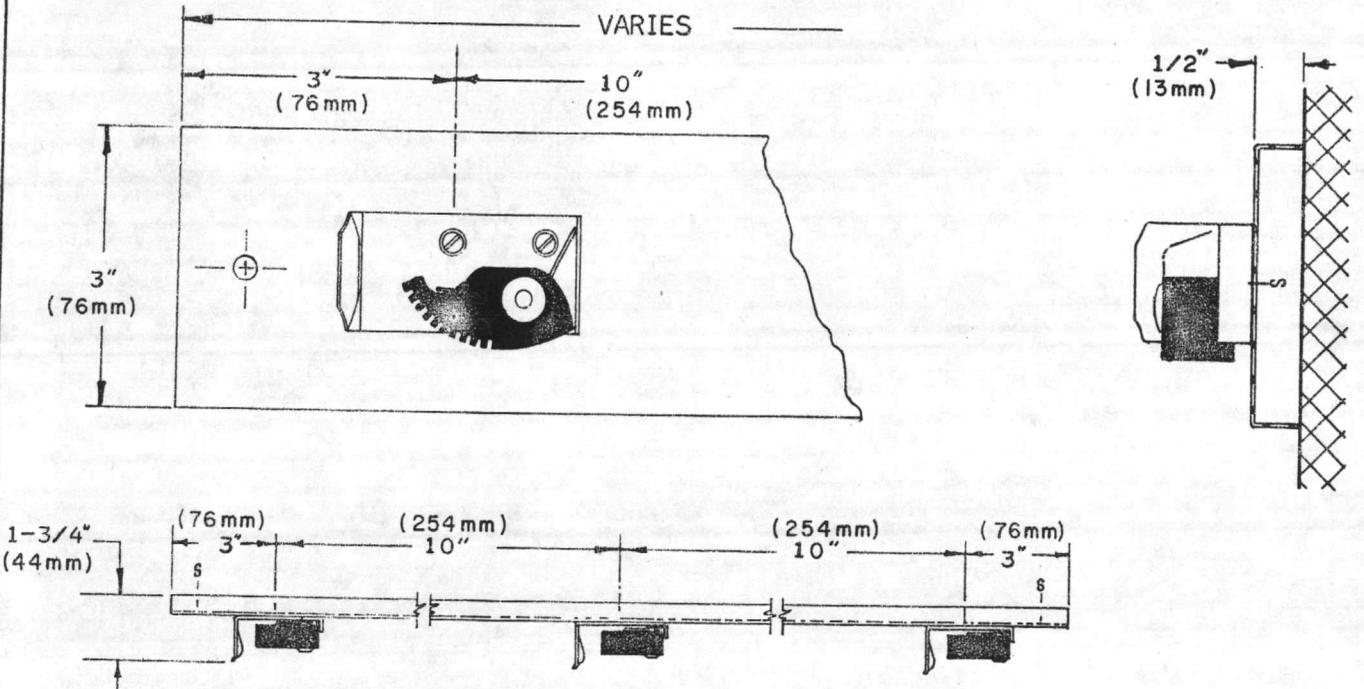

SCHEDULE

ASI MOD. NO.	SUFFIX	REQ'D. LENGTH	MOP HOLDER QUANTITY	QUANTITY
0796	A	26" (660mm)	3	
0796	B	36" (914mm)	4	
0796	C	46" (1168mm)	5	
0796	D	56" (1422mm)	6	

SPECIFICATION -

RACK IS FABRICATED OF A ONE PIECE CHANNEL OF NO. 20 GAUGE, TYPE 304L, 18-8 ALLOY STAINLESS STEEL WITH HORIZONTAL EDGES RETURNING 1/2" TO THE WALL. SURFACE OF RACK IS POLISHED TO A NO. 4 SATIN FINISH. MOP HOLDERS ARE RIVETED TO RACK AT 10" INTERVALS. MOP HOLDERS ARE FABRICATED OF CADMIUM PLATES STEEL WHICH IS RIBBED FOR RIGIDITY. A PIVOTING SERRATED RUBBER CAM HOLDS MOP IN FIXED POSITION.

INSTALLATION -

CHANNEL IS PROVIDED WITH COUNTER SUNK HOLES WHICH ACCOMMODATE 3/16" DIAMETER SCREWS FURNISHED BY MANUFACTURER.


MOUNTING SUGGESTION -

LOCATION - 70" FROM TOP OF FINISHED FLOOR TO BOTTOM OF RACK.
(1778mm)

"It is hereby certified that the (equipment) shown and marked on this submittal is in accordance with the specifications proposed to be incorporated into Contract Number N62470-81-C-1766 and is in compliance with the Contract drawings and specifications. It is submitted in the allocated space, and is submitted Government approval.

Certified by D.S.
Date 5-22-84

THIS MANUFACTURER RESERVES THE RIGHT TO MAKE CHANGES IN DESIGN OR DIMENSIONS WITHOUT FORMAL NOTICE.

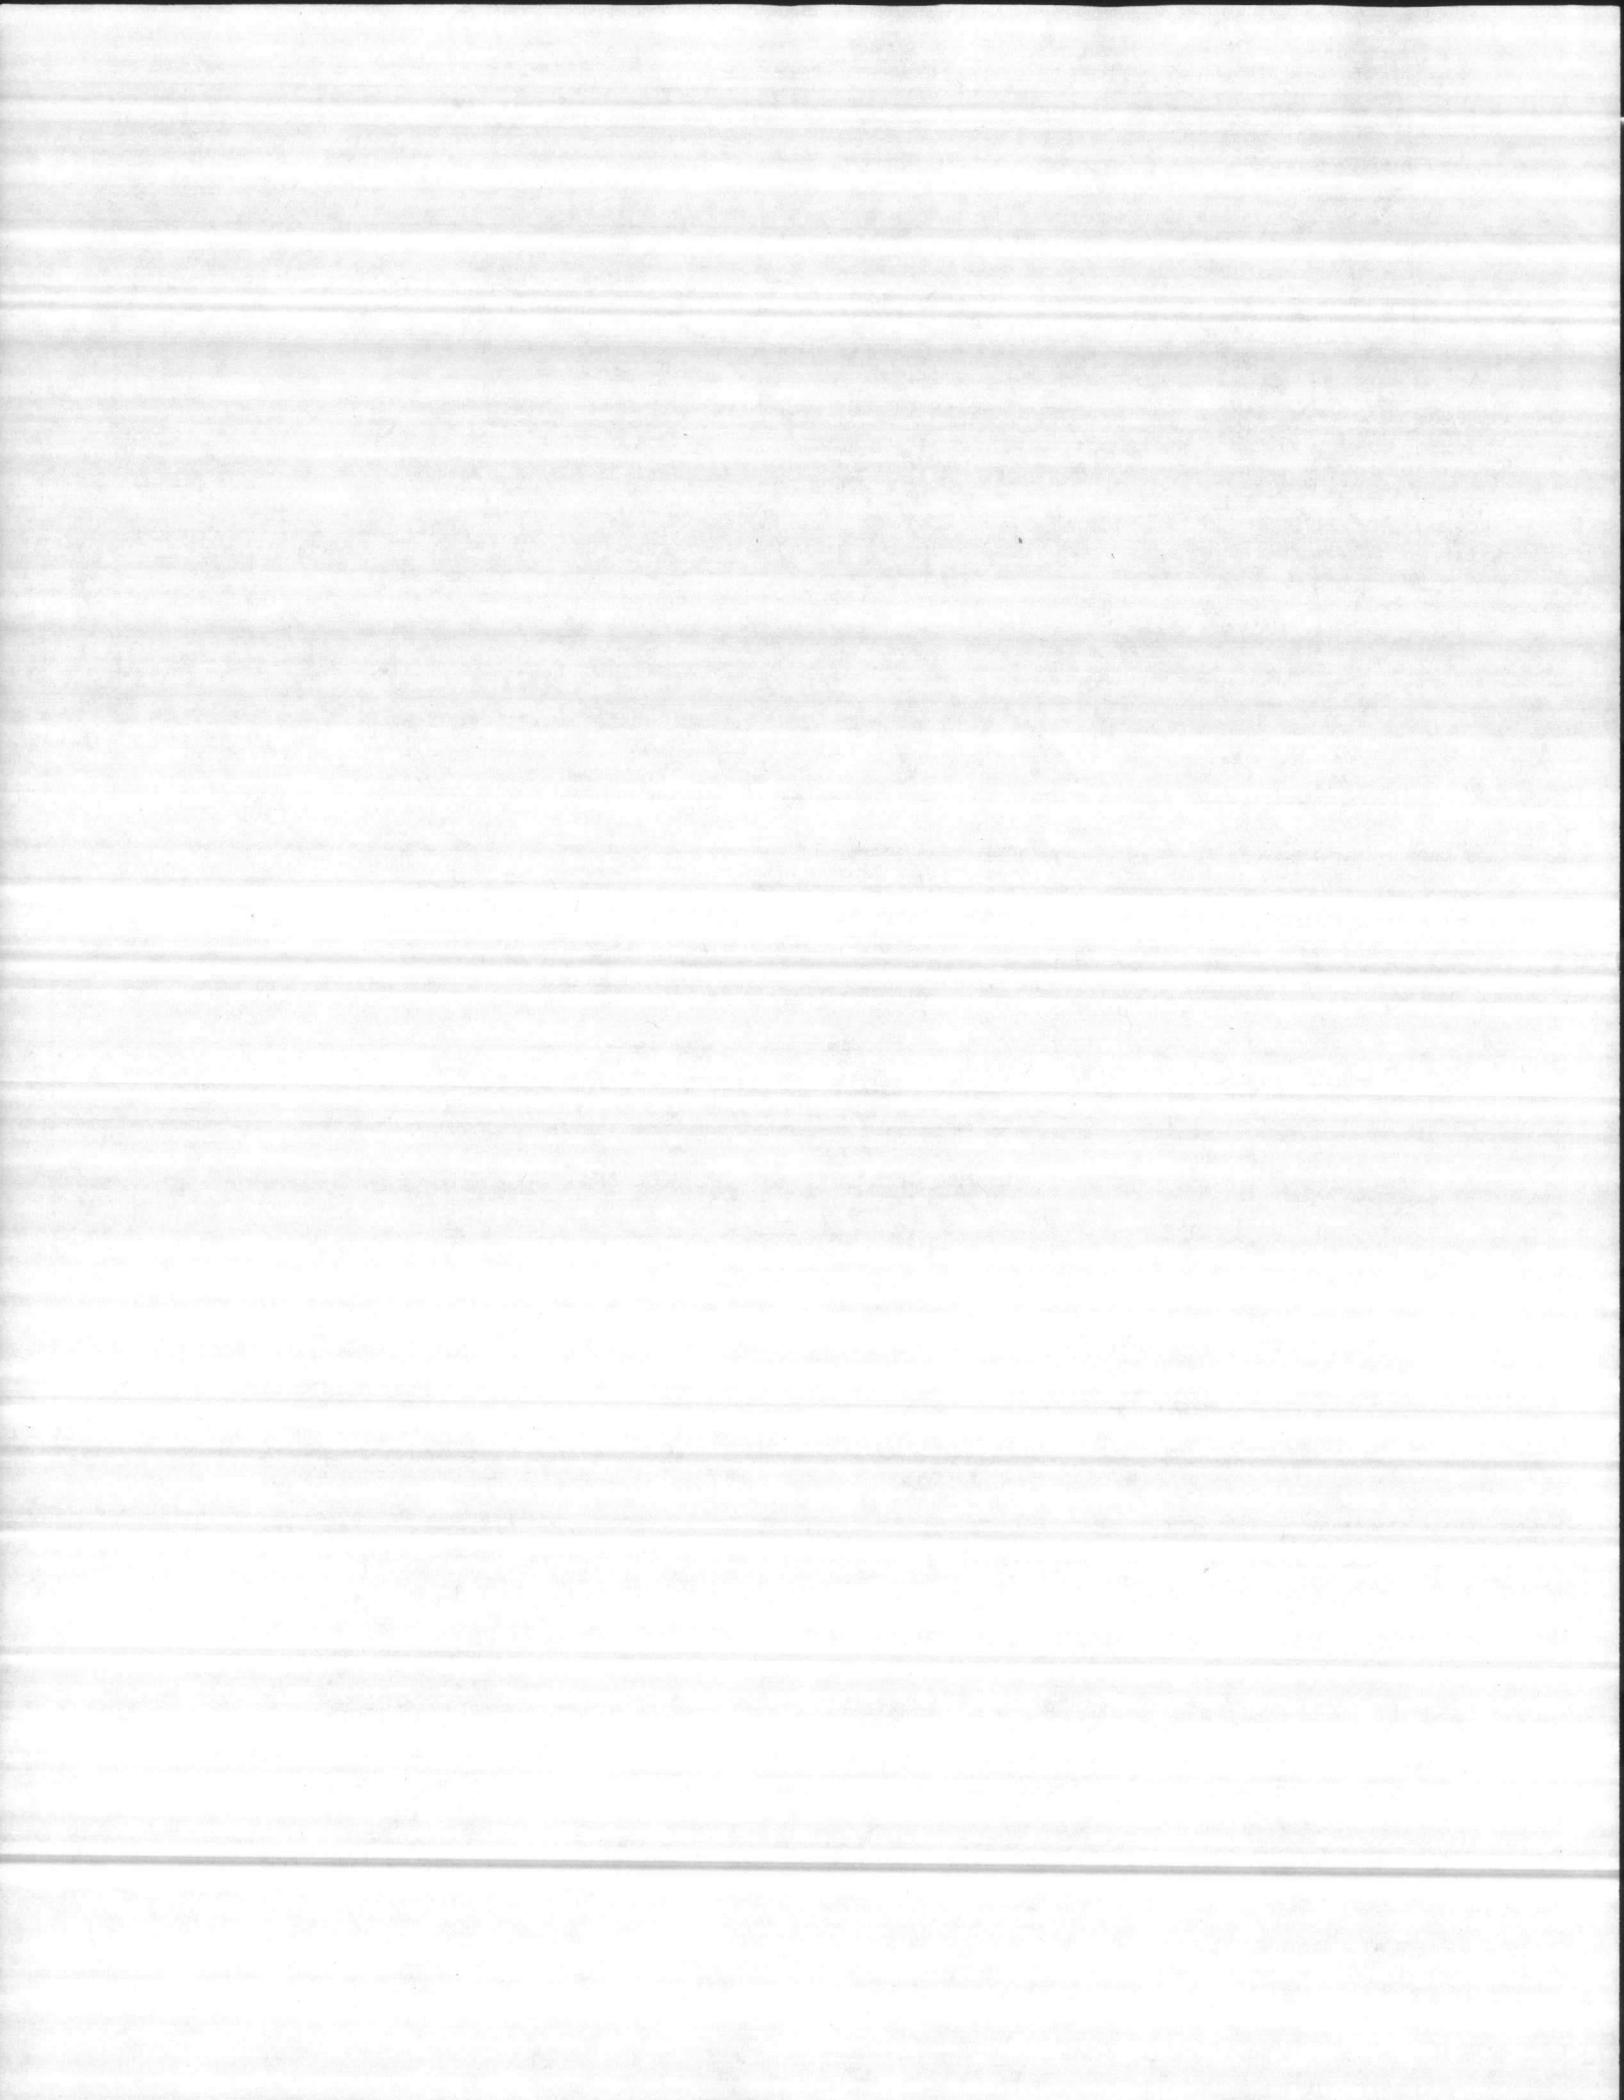




ACCESSORY SPECIALTIES, INC.

PAIL OR LADDER HOOK

1301A

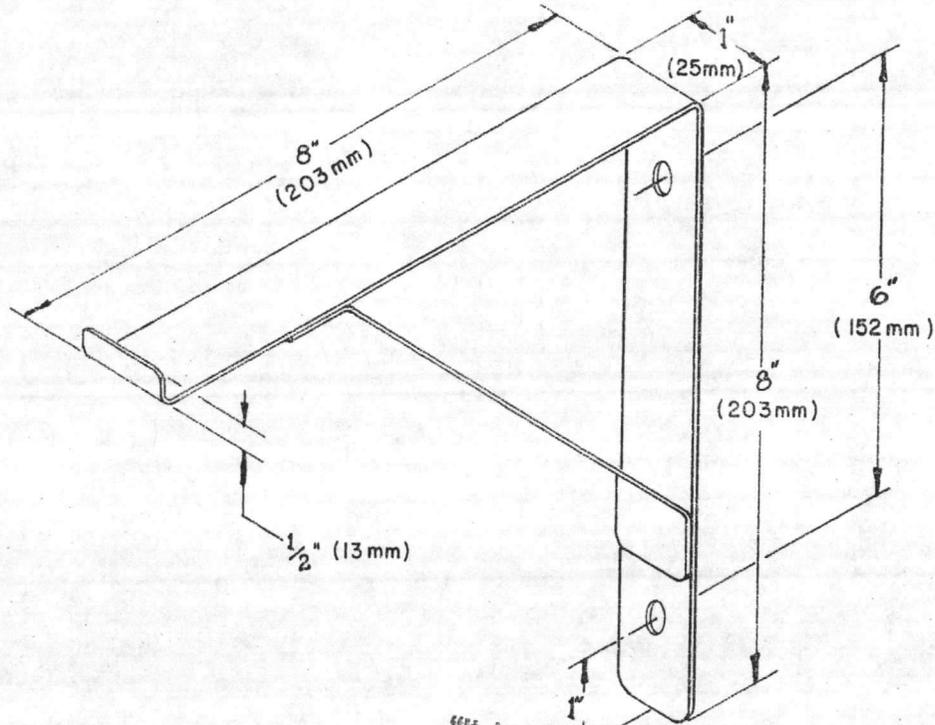

It is certified that the (equipment) (material) shown and marked in this submittal is that proposed to be incorporated into Contract Number N62470 81-C-1766, in compliance with the Contract drawings and specifications, can be installed in the allocated space, and is submitted Government approval.

Certified by DS


Date 5-22-84

SPECIFICATION -

HOOK IS FABRICATED OF #12 GAUGE TYPE 304L, 18-8 ALLOY STAINLESS STEEL WITH A NO. 4 SATIN FINISH PROTECTED BY A POLYVINYL COATING (PVC) EASILY REMOVED AFTER INSTALLATION. HOOK HAS A 1/2" HIGH 90° LIP AND IS REINFORCED WITH A DIAGONAL BRACE.
(13mm)

INSTALLATION -

HOOK IS PROVIDED WITH TWO MOUNTING HOLES TO RECEIVE 1/4" DIAMETER SCREWS.
(6mm)

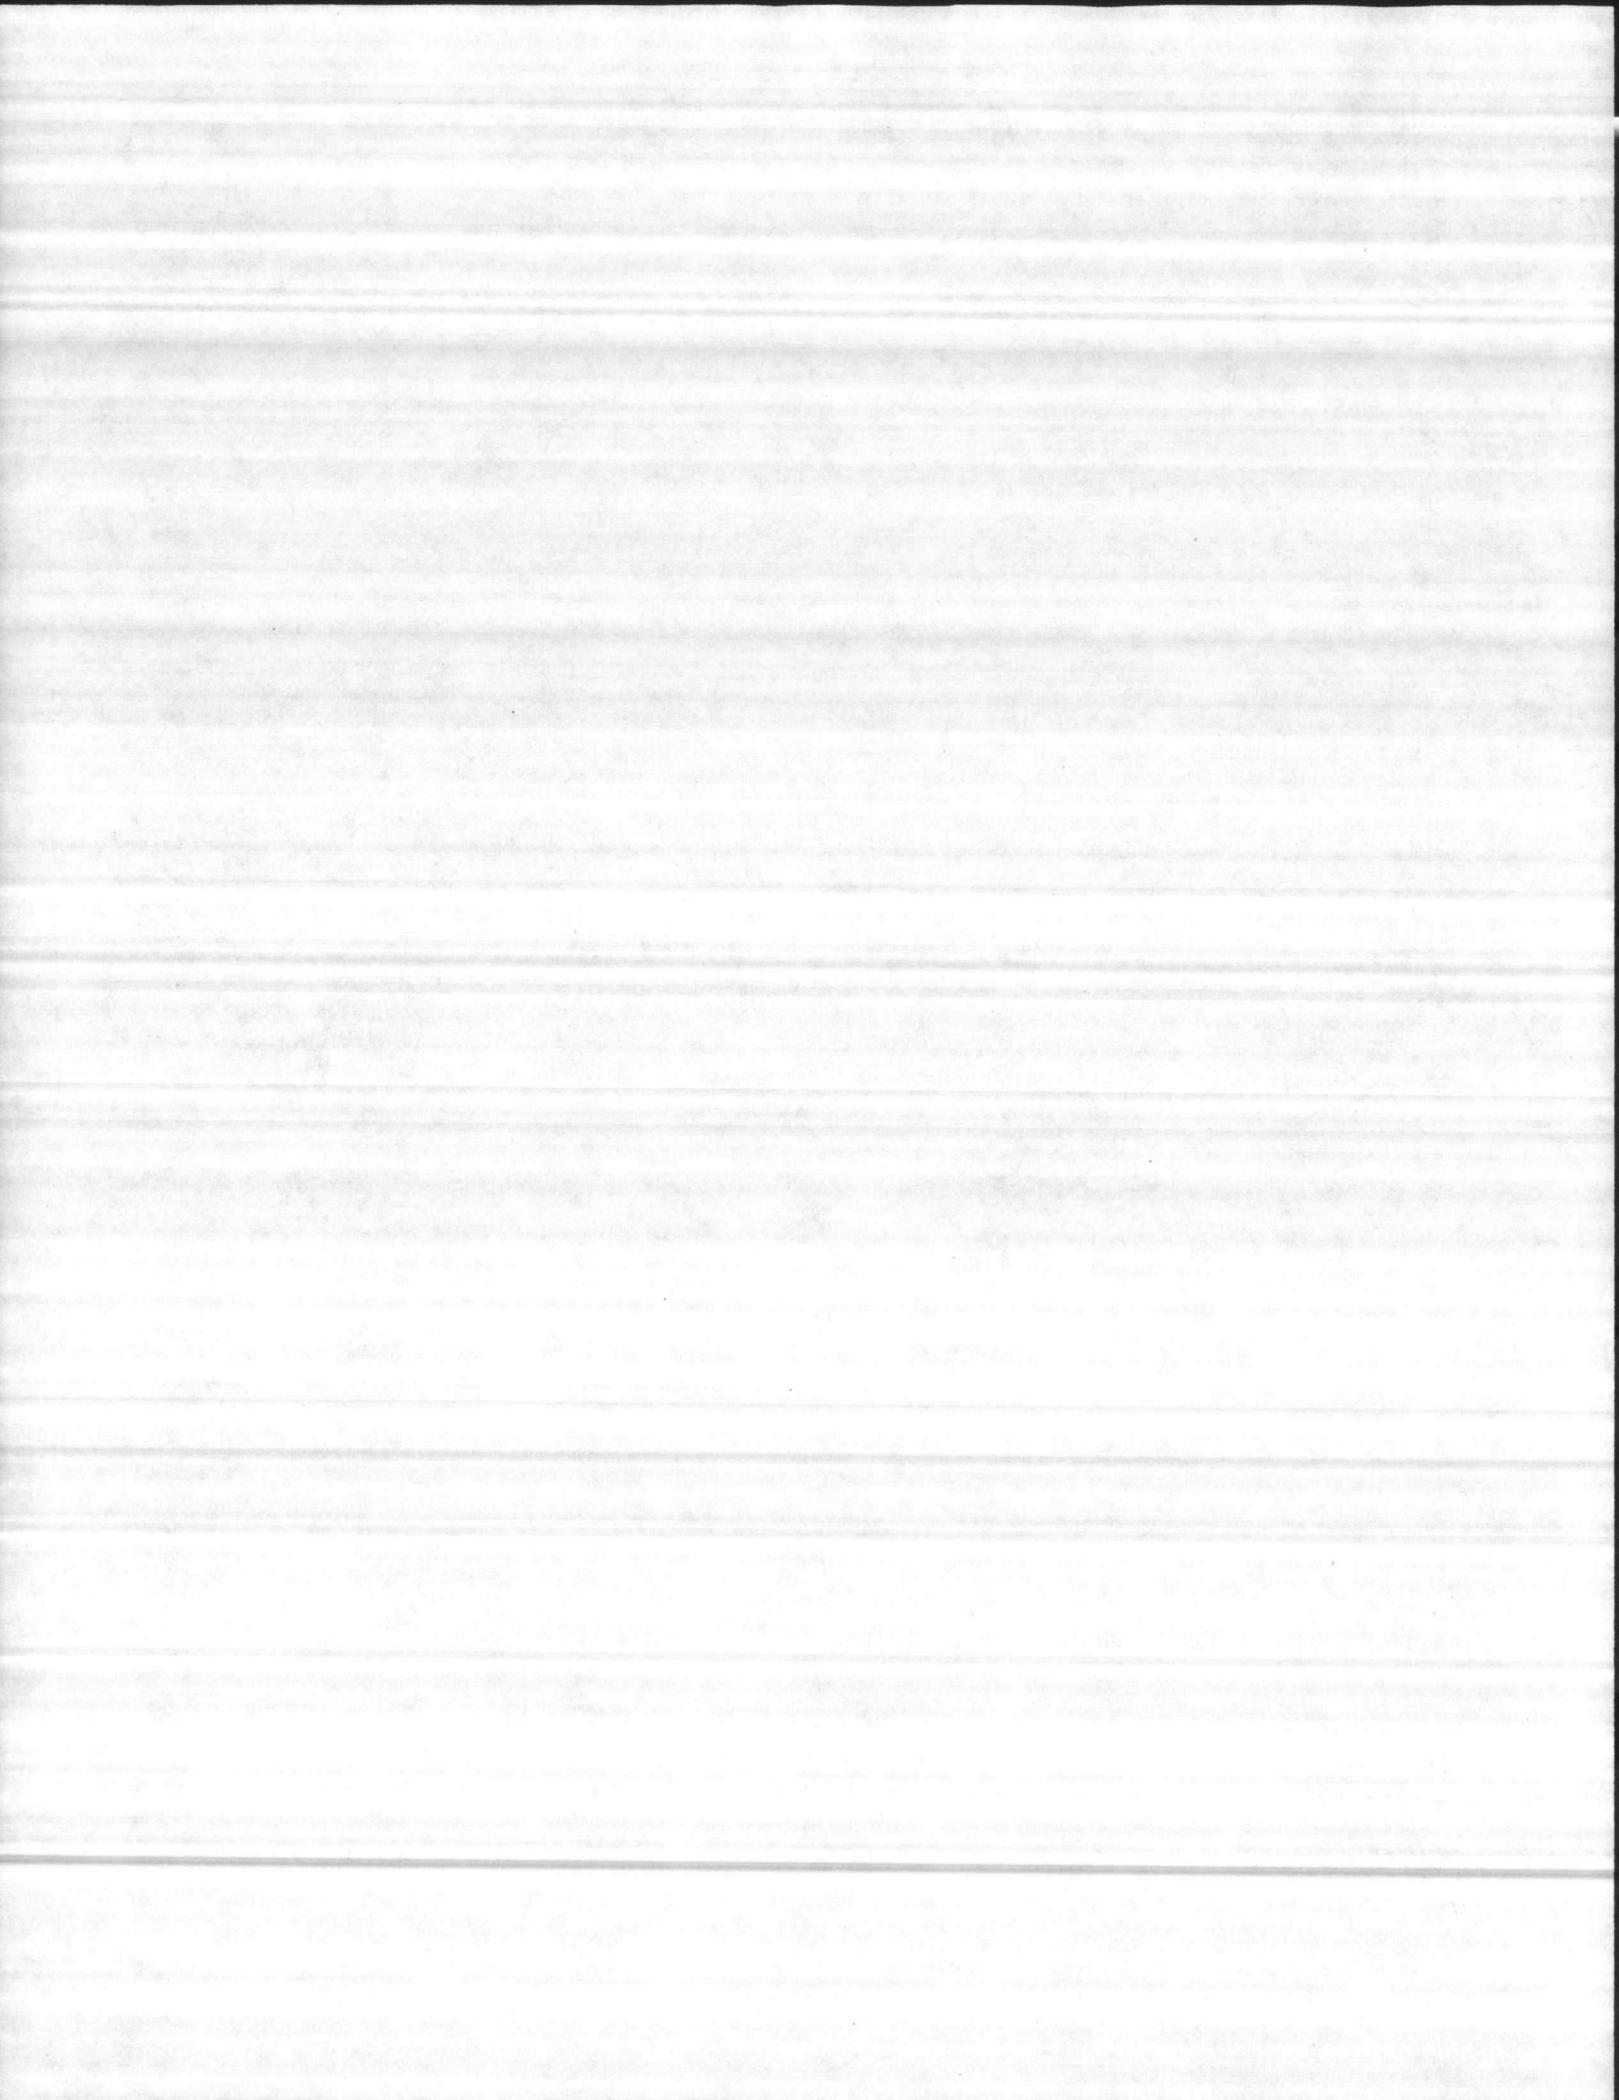





ACCESSORY SPECIALTIES, INC.

VACUUM HOSE BRACKET - ALUMINUM / STAINLESS

1305/ 1305A

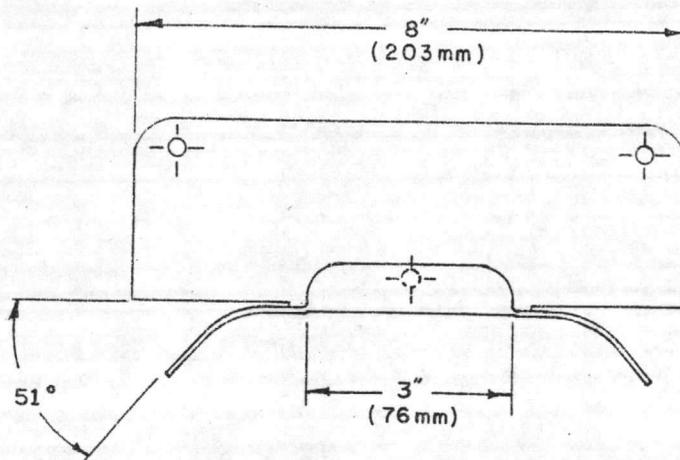

FRONT VIEW

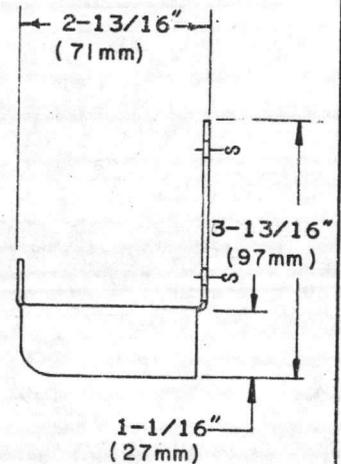

END VIEW

SPECIFICATION - 1305

VACUUM HOSE BRACKET IS FABRICATED OF ^(3mm) 1/8" THICK 6063-T3 ALLOY ALUMINUM. BRACKET IS SHAPED IN ONE PIECE WITH ALL CORNERS AND EDGES ROUNDED. BRACKET IS ANODIZED DEEP ETCHED TO A SATIN FINISH.

SPECIFICATION - 1305A

VACUUM HOSE BRACKET IS FABRICATED OF #14 GAUGE TYPE 304L, 18-8 ALLOY STAINLESS STEEL WITH PLASTIC CLAD PRE-POLISHED NO. 4 SATIN FINISH ON ALL EXPOSED SURFACES. BRACKET IS SHAPED IN ONE PIECE AND HAS ALL CORNERS AND EDGES ROUNDED.

INSTALLATION -

VERTICAL INTEGRAL BACK PLATE IS PROVIDED WITH THREE HOLES TO ACCOMMODATE ^(5mm) 3/16" DIAMETER SCREWS.


MOUNTING SUGGESTION -

LOCATION - 60" FROM TOP OF FINISHED FLOOR TO BOTTOM OF HOSE BRACKET.
(1524 mm)

"It is hereby certified that the (equipment) (material) shown and marked in this submittal is that proposed to be incorporated into Contract Number N62470-81-C-1766, in compliance with the Contract drawings and specifications, can be installed in the allocated spaces, and is submitted Government approval.

Certified by DS

Date 5-22-84

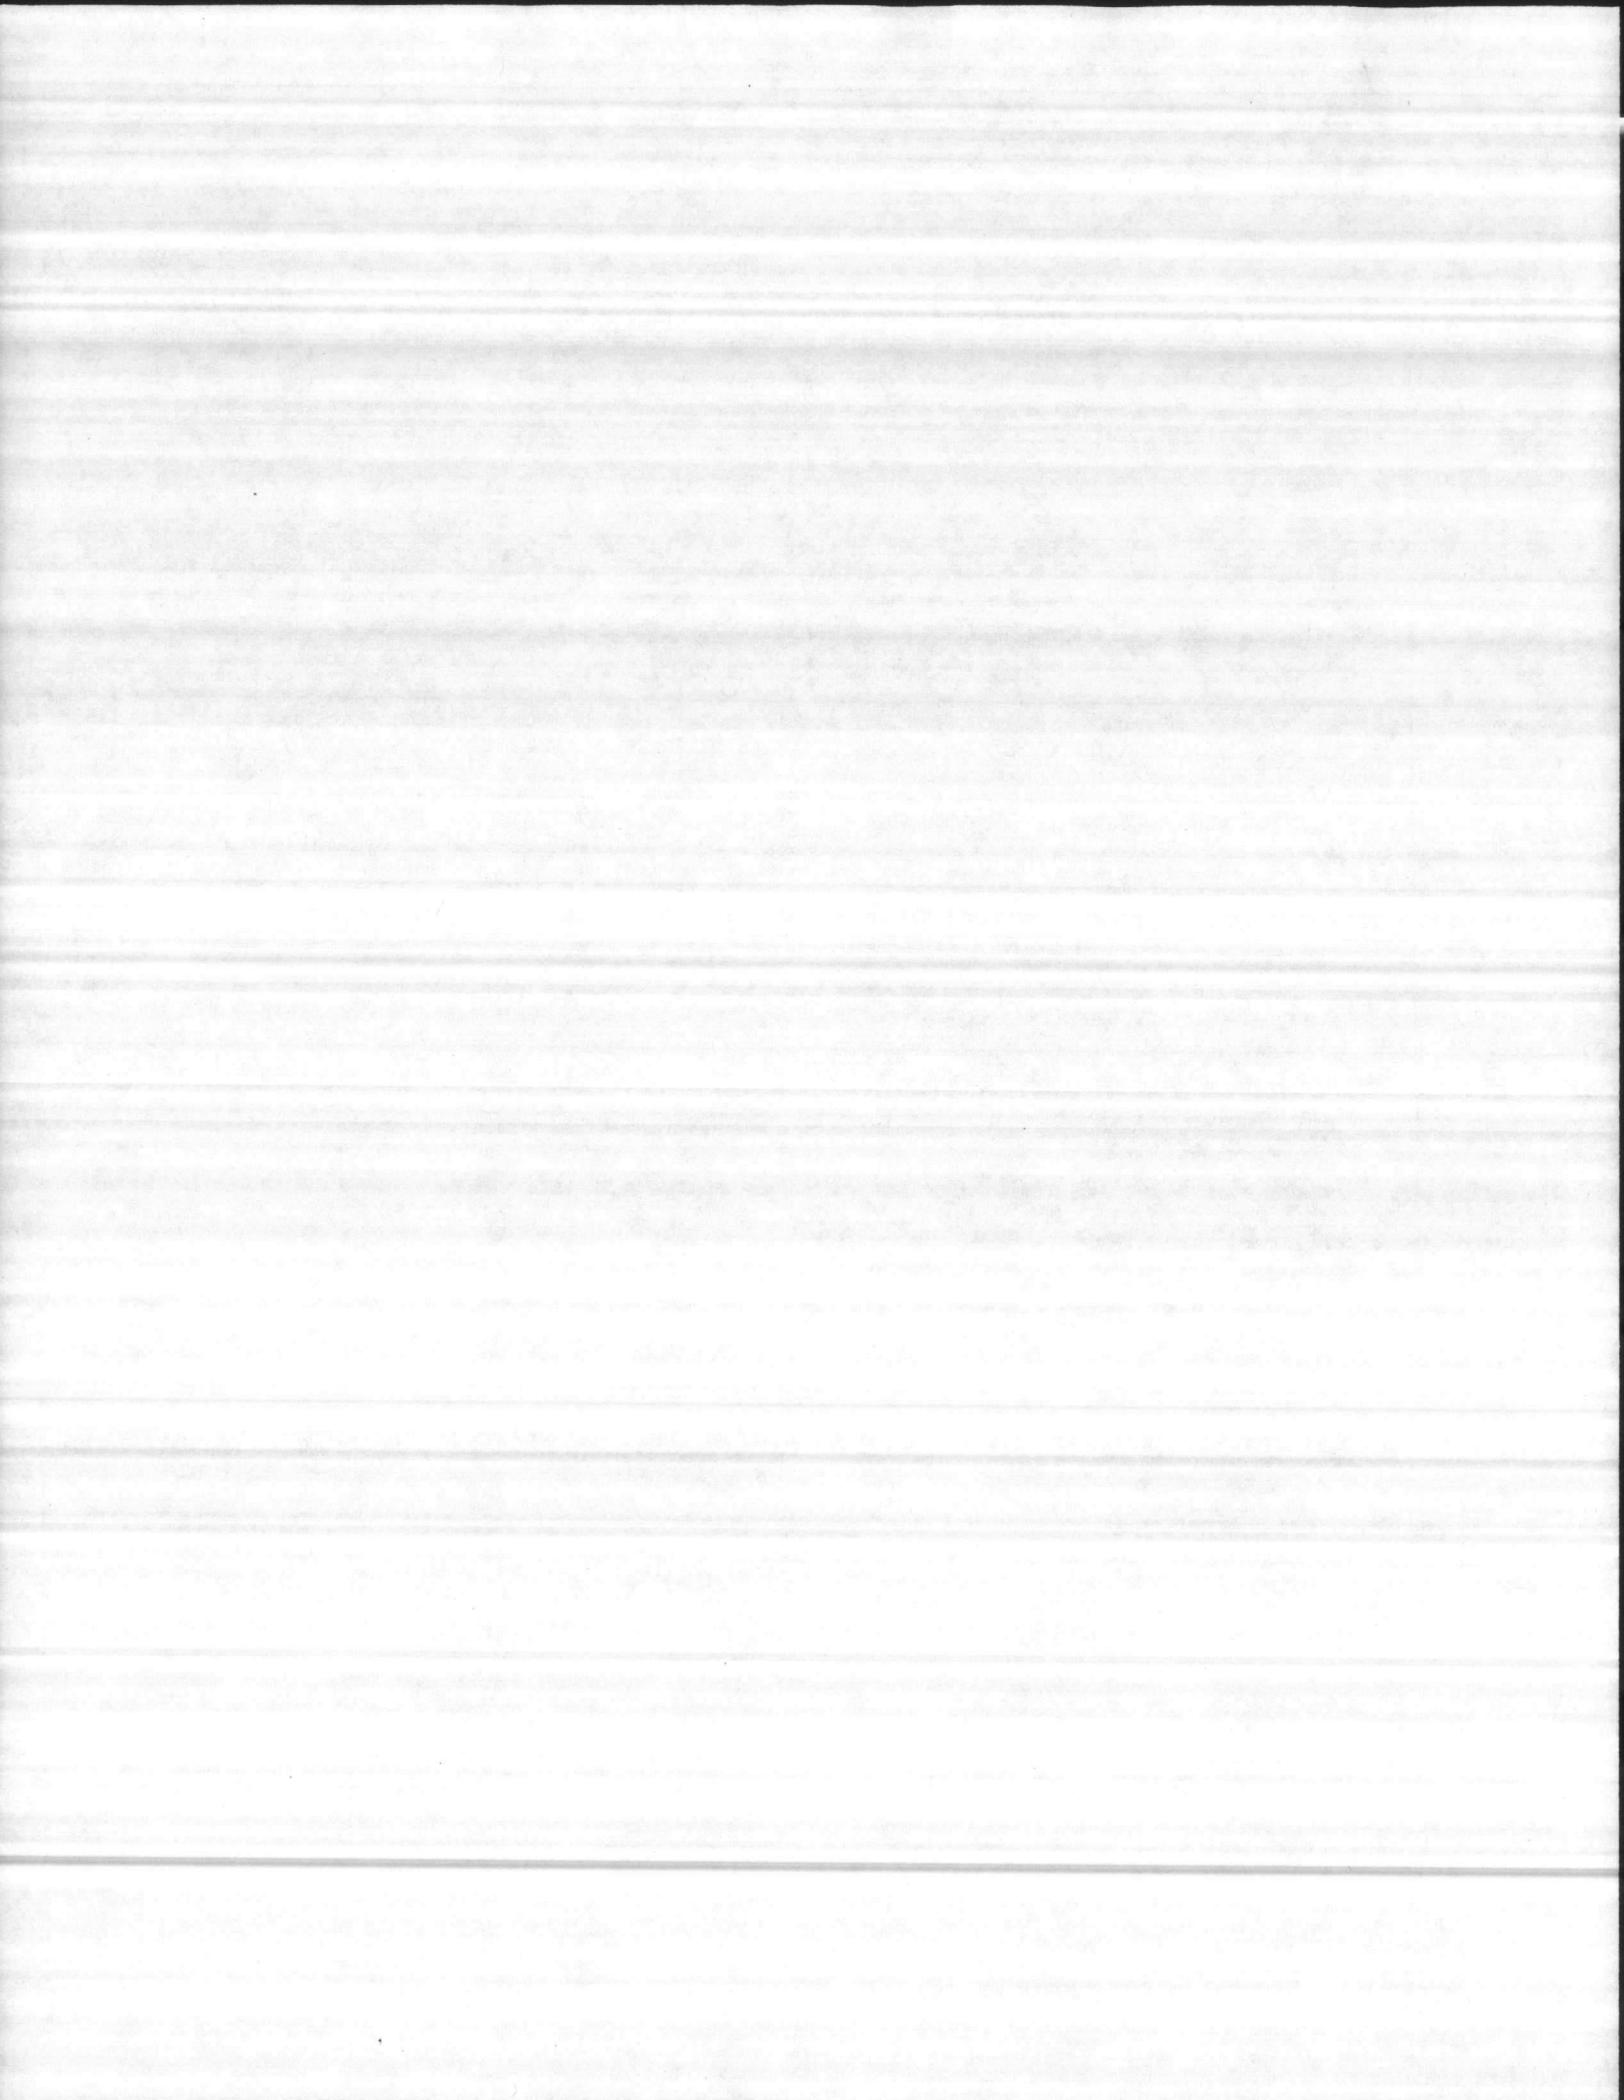





ACCESSORY SPECIALTIES, INC.

TILTED MIRROR FOR WHEEL CHAIR PATIENT
(STAINLESS STEEL FRAME)


0535-0535A

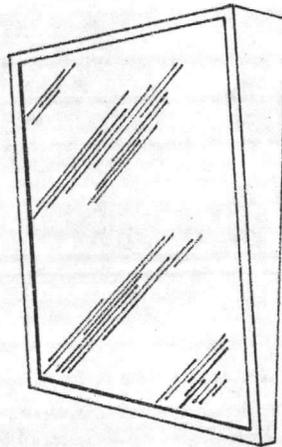

PICTORIAL VIEW

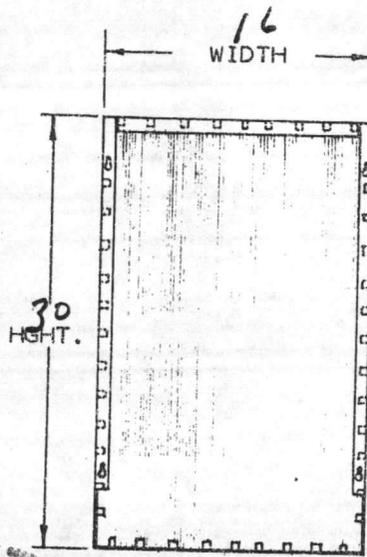

BACK VIEW

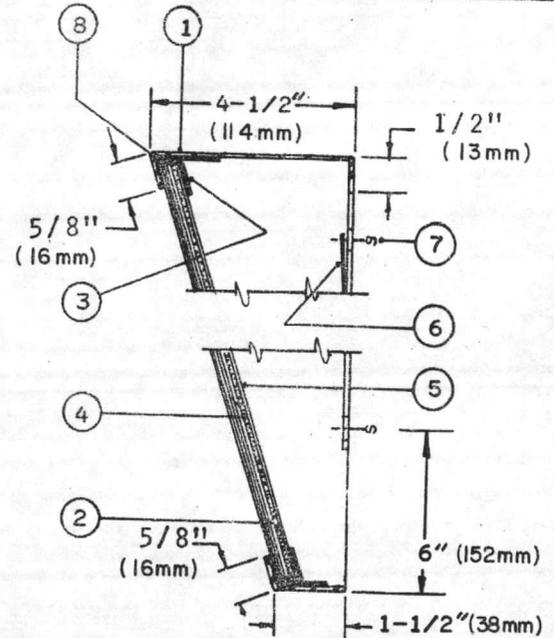

VERTICAL SECTION

DESCRIPTION

1. 20 GA. STAINLESS STEEL FRAME
2. 1/4" PLATE GLASS MIRROR
3. 20 GA. GLASS STRAP
4. FOAM CUSHION

It is hereby certified that the (equipment) (material) shown and marked in this submittal is that proposed to be incorporated in compliance with the Contract drawings and specifications, can be installed in the allocated spaces, and is submitted for Government approval.

Certified by *D.S.*

SPECIFICATIONS

FRAME - FACE FRAME FABRICATED OF NO. 20 GAUGE TYPE 304-L, 18-8 ALLOY STAINLESS STEEL WITH NO MITRES, SPOT WELDED SEAMS OR SEPARATE COLLARS. ENTIRE FRAME IS POLISHED TO A NO. 4 SATIN FINISH. BACK PLATE IS FABRICATED OF NO. 20 GAUGE GALVANIZED STEEL, ONE PIECE AND DIE CUT TO FIT FRAME. HANGER ASSEMBLY IS PROVIDED TO PERMIT WALL MOUNTING AND HAS CONCEALED THEFT PROOF LOCKING DEVICES. A 1/16" THICK FELT BACK IS PROVIDED BETWEEN MIRROR AND BACK PLATE. MIRROR IS 1/4" QUALITY POLISHED PLATE GLASS, SILVER COATED AND HERMETICALLY SEALED WITH A UNIFORM COATING OF ELECTROLYTIC COPPER PLATING GUARANTEED FOR 15 YEARS. MIRRORS MEET GOVERNMENT SPECIFICATIONS No. DD-G-451.

GLAZING - THE ABOVE FRAME IS ALSO AVAILABLE WITH THE FOLLOWING SURFACES.

- B. TEMPERED GLASS - IS 1/4" THICK POLISHED TEMPERED GLASS WITH TWO COATS OF SILVER, PROPERLY APPLIED. THE COVERING IS HERMETICALLY SEALED BY ELECTROPLATING WITH A HEAVY UNIFORM COATING OF COPPER. BACK OF MIRROR IS FINISHED AND PROTECTED WITH A THICK COAT OF HEAVY WATERPROOF PAINT. (FED. SPEC. DD-G-1403B AMEND.1)
- C. METAL MIRRORS - ARE STAINLESS STEEL POLISHED TO A MIRROR FINISH AND PROVIDED WITH ADDITIONAL HARDBOARD BACKING.

INSTALLATION - REAR LEGS OF MIRROR HAVE KEY HOLE SLOTS WITH INTEGRAL TAMPER-PROOF LOCKING DEVICES.


NOTES - TILTED MIRROR FOR WHEEL CHAIR PATIENTS IS AVAILABLE IN TWO SIZES

- No. 535 - 16" WIDE BY 30" HIGH (406mm) (762mm)
- No. 535-A - 18" WIDE BY 36" HIGH (457mm) (914mm)

MOUNTING SUGGESTIONS

33" FROM TOP OF FINISHED FLOOR TO BOTTOM OF MIRROR OR 3" ABOVE TOP OF WASH BASIN (838mm) (76mm)


THIS MANUFACTURER RESERVES THE RIGHT TO MAKE CHANGES IN DESIGN OR DIMENSIONS WITHOUT FORMAL NOTICE.

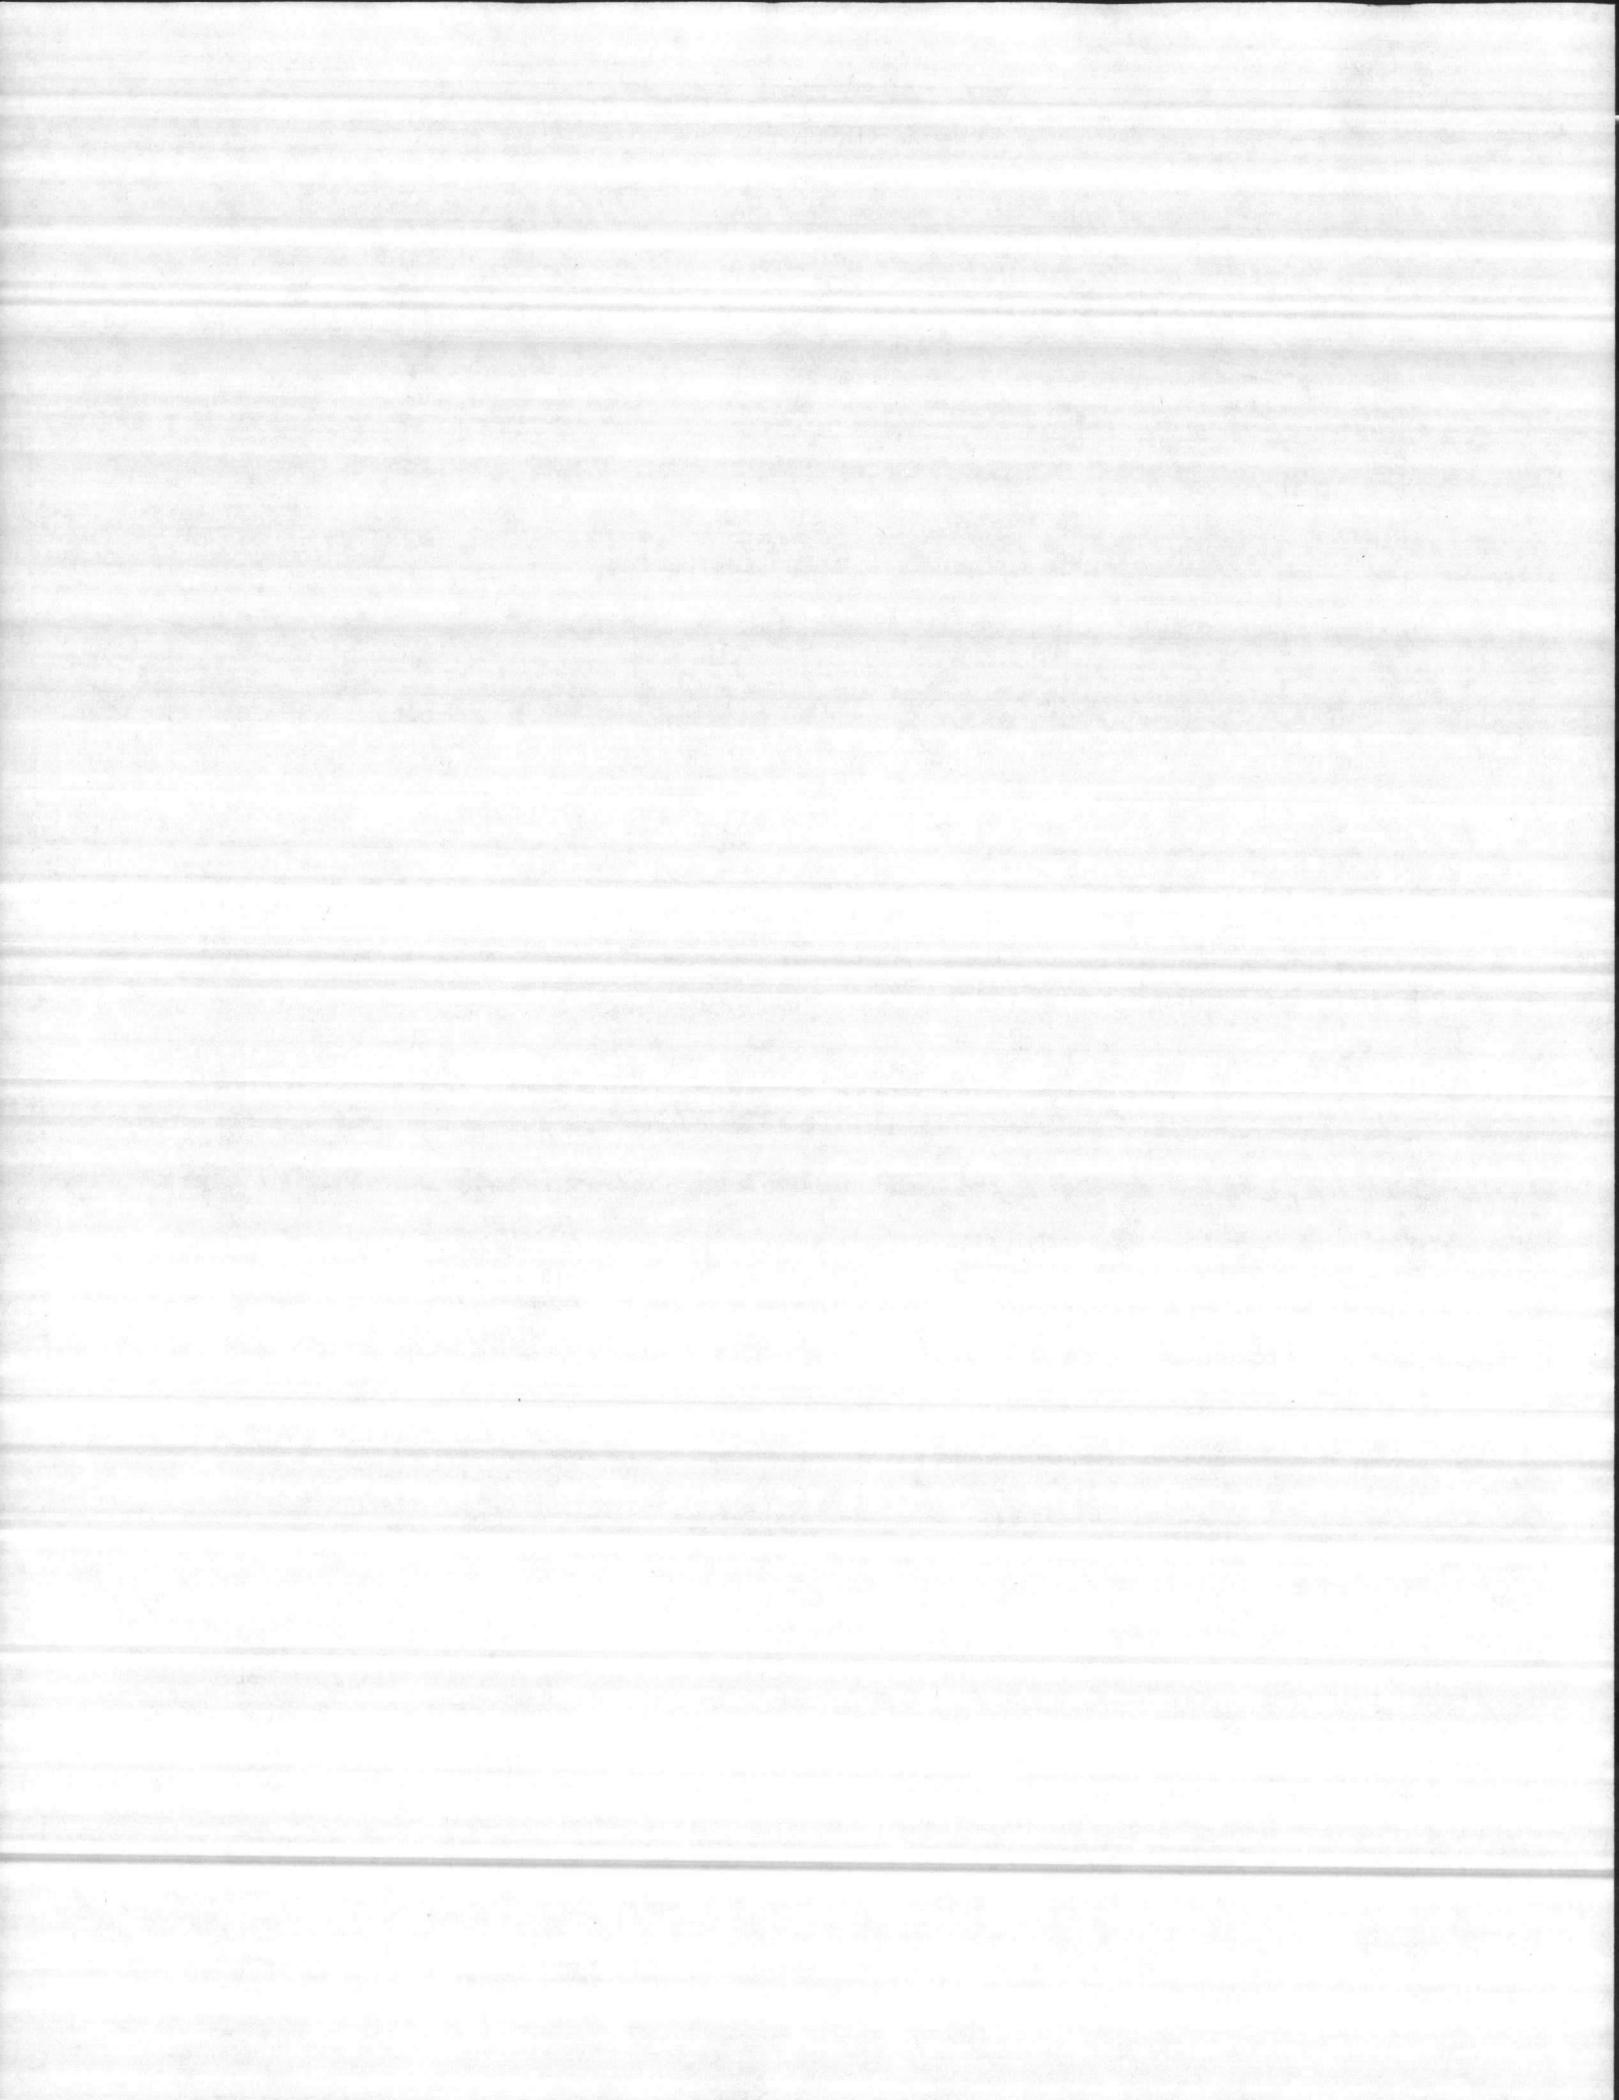



ACCESSORY SPECIALTIES, INC.

SURFACE-MOUNTED ASH URN

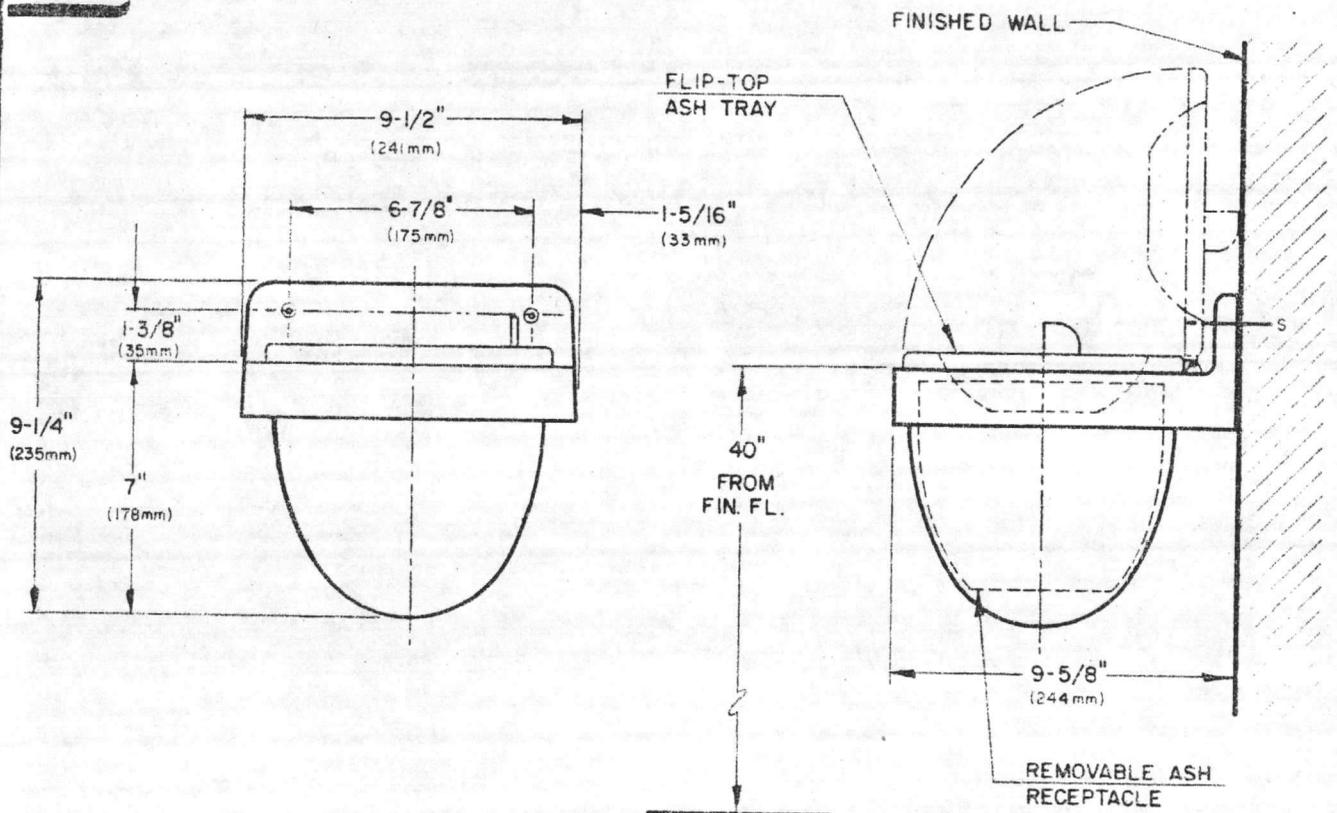

ELEVATION

END VIEW

SPECIFICATION -

FLIP-TOP ASH TRAY AND WALL URN SHALL BE FABRICATED OF #22 GAUGE, TYPE 304, STAINLESS STEEL WITH A SATIN FINISH. SEAMLESS ALUMINUM RECEPTACLE IS REMOVABLE FOR SERVICING. FLIP-TOP ASH TRAY IS SECURED TO WALL URN BY HINGE. VANDALPROOF, HEAVY-DUTY MOUNTING BRACKET IS FABRICATED OF ANODIZED ALUMINUM WITH A SATIN FINISH.

FOR BRONZETONE FINISH - ADD SUFFIX "A"

"It is hereby certified that the (equipment) (material) shown and marked in this submittal is that proposed to be incorporated into Contract Number N62470-81-C-176, as in compliance with the Contract drawings and specifications, can be installed in the allocated spaces, and is submitted Government approval.

Certified by D.S.

Date 5-22-84

10/21/81

SURFACE-MOUNTED ASH URN

8095

