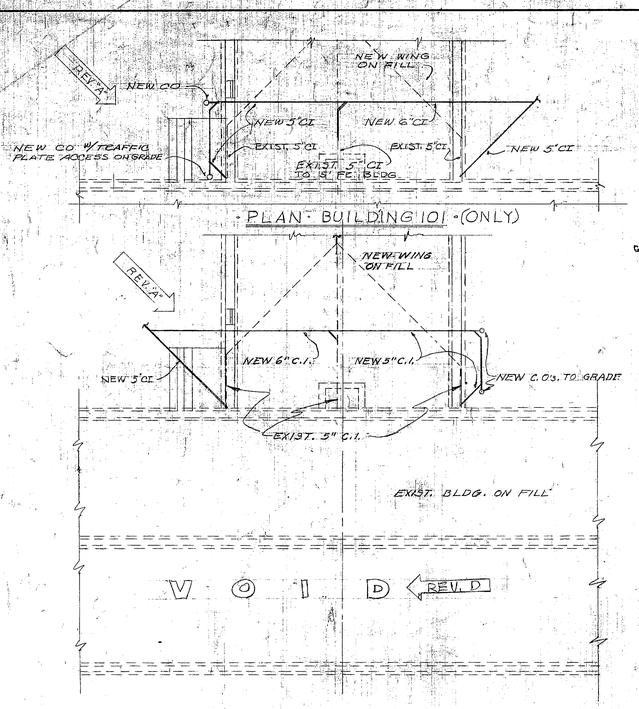

DRAINAGE

PLAN REGIMENTAL AREA 1

SCAL, 1/8"=1'-0"

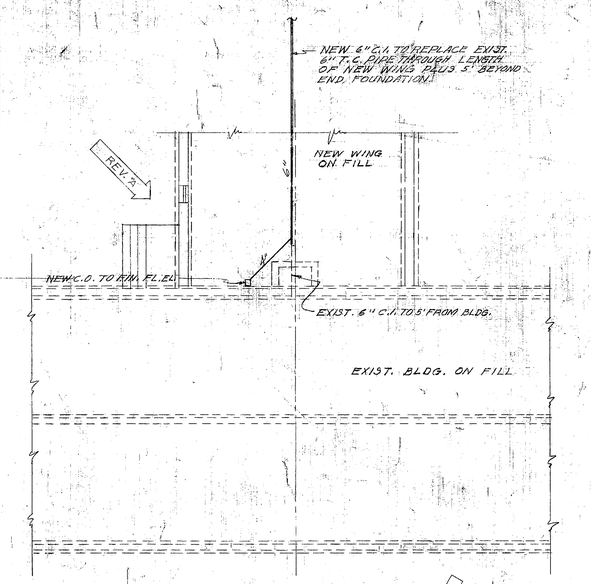

DRAINAGE

PLAN REGIMENTAL AREAS 1, 2, 3, & 4

SCALE, 1/8"=1'-0"

REV. D

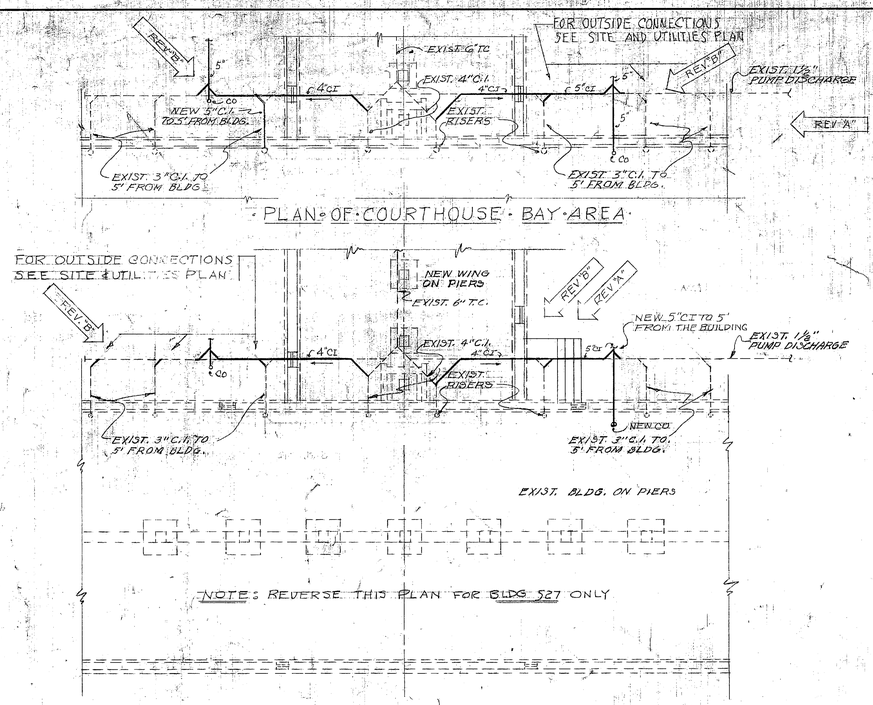

DRAINAGE

PLAN REGIMENTAL AREA 5 BLDG'S. 502, 503, 517, 519, 523 & 527

SCALE, 1/8"=1'-0"

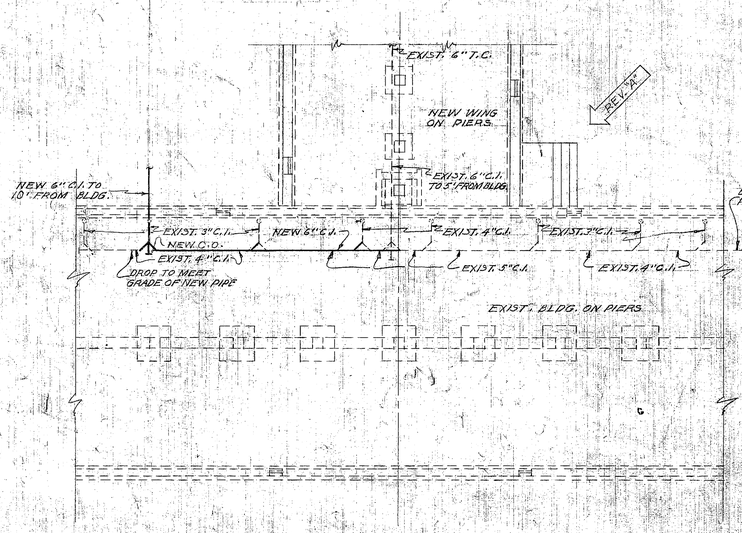

DRAINAGE

PLAN REGIMENTAL AREA 5 BUILDINGS: 506, 507, 510, 511, 514, 515 AND SERVICE COMPANY AREA BUILDING 10

SCALE 1/8"=1'-0"

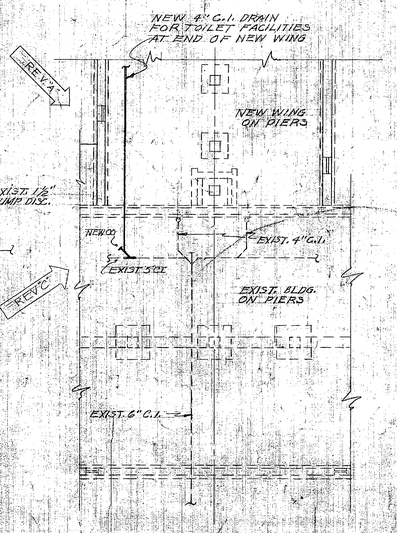

DRAINAGE

PLAN SERVICE COMPANY BUILDINGS 6, 8, & 12 ONLY

SCALE, 1/8"=1'-0"

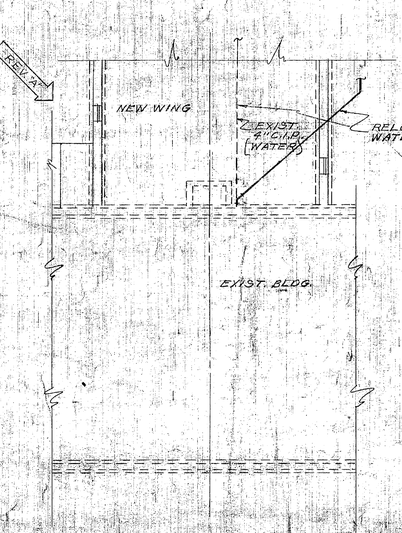

WATER

PLAN REGIMENTAL AREAS 1, 2 & 4 BUILDINGS 5, 101, 105, 109, 111, 205, 209, 213, 217, 407, 409, 415, & 417 ONLY

SCALE, 1/8"=1'-0"

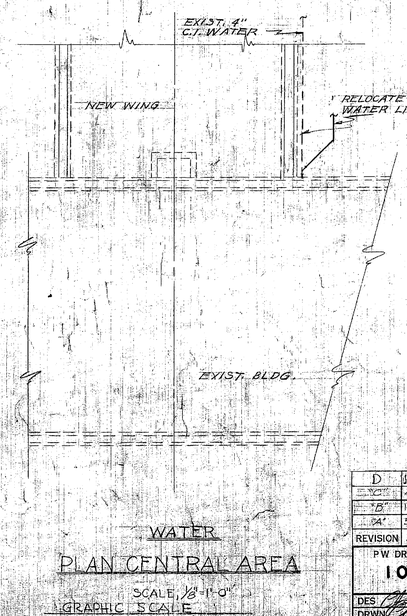

WATER

PLAN CENTRAL AREA

SCALE, 1/8"=1'-0"

GRAPHIC SCALE

1/8"=1'-0" 0 5' 10' 15' 20' 25' 30' 35' 40'

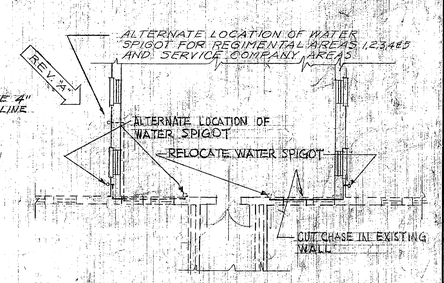

RELOCATION OUTSIDE WATER SPIGOT

ALL AREAS

SCALE 1/2"=1'-0"

REVISION	DATE	APPD.	DESCRIPTION	BY
D	13MAR57	JJW	AS BUILT REVISIONS	WAS
"C"	4APR57	JJW	RELOCATE SOIL PIPE CONNECTION	WAS
"B"	18MAR57	JJW	MOVE SEWER COLLECTION LINES FROM BELOW EXIST. BLDG.	WAS
"A"	5FEB57	JJW	REV. IN ACCORDANCE WITH AMEND. NO. 2	WAS

PW DRAWING NO.	10742
DES.	
DRWN.	
TR.	
CHK.	
SUPV.	
IN CHARGE	

MARINE CORPS BASE
CAMP LEJEUNE, N. C.

MODIFICATION BARRACKS
REGIMENTAL AREAS - SERVICE COMPANY AND COURTHOUSE BAY
ALTERATIONS TO PLUMBING SYSTEMS
PLANS AND DETAILS

APPROVED _____ DATE _____ No. 1956
PUBLIC WORKS OFFICER

SATISFACTORY TO
THE COMMANDING GENERAL MARINE CORPS BASE, CAMP LEJEUNE, N.C.
DATE

SATISFACTORY TO
THE QUARTERMASTER GENERAL OF THE MARINE CORPS
DATE

APPROVED FOR BUREAU OF YARDS & DOCKS
DPWO FOR CHIEF OF BUREAU
DATE

SCALE Graphic | SPEC 3564/56
SHEET 43 OF 48 | NDy 3564
Y & D DRAWING NO. 646942

NAVFAC-CLINC KEMPFEL & BERGER CO.