REFERENCE DRAWINGS	
SERIES A-690 FEEDER ✓	321-105
EXTENSION HOPPER ✓	321-121
HOPPER SCREEN ✓	321-122
CONSTANT LEVEL TANKS ✓	371-200

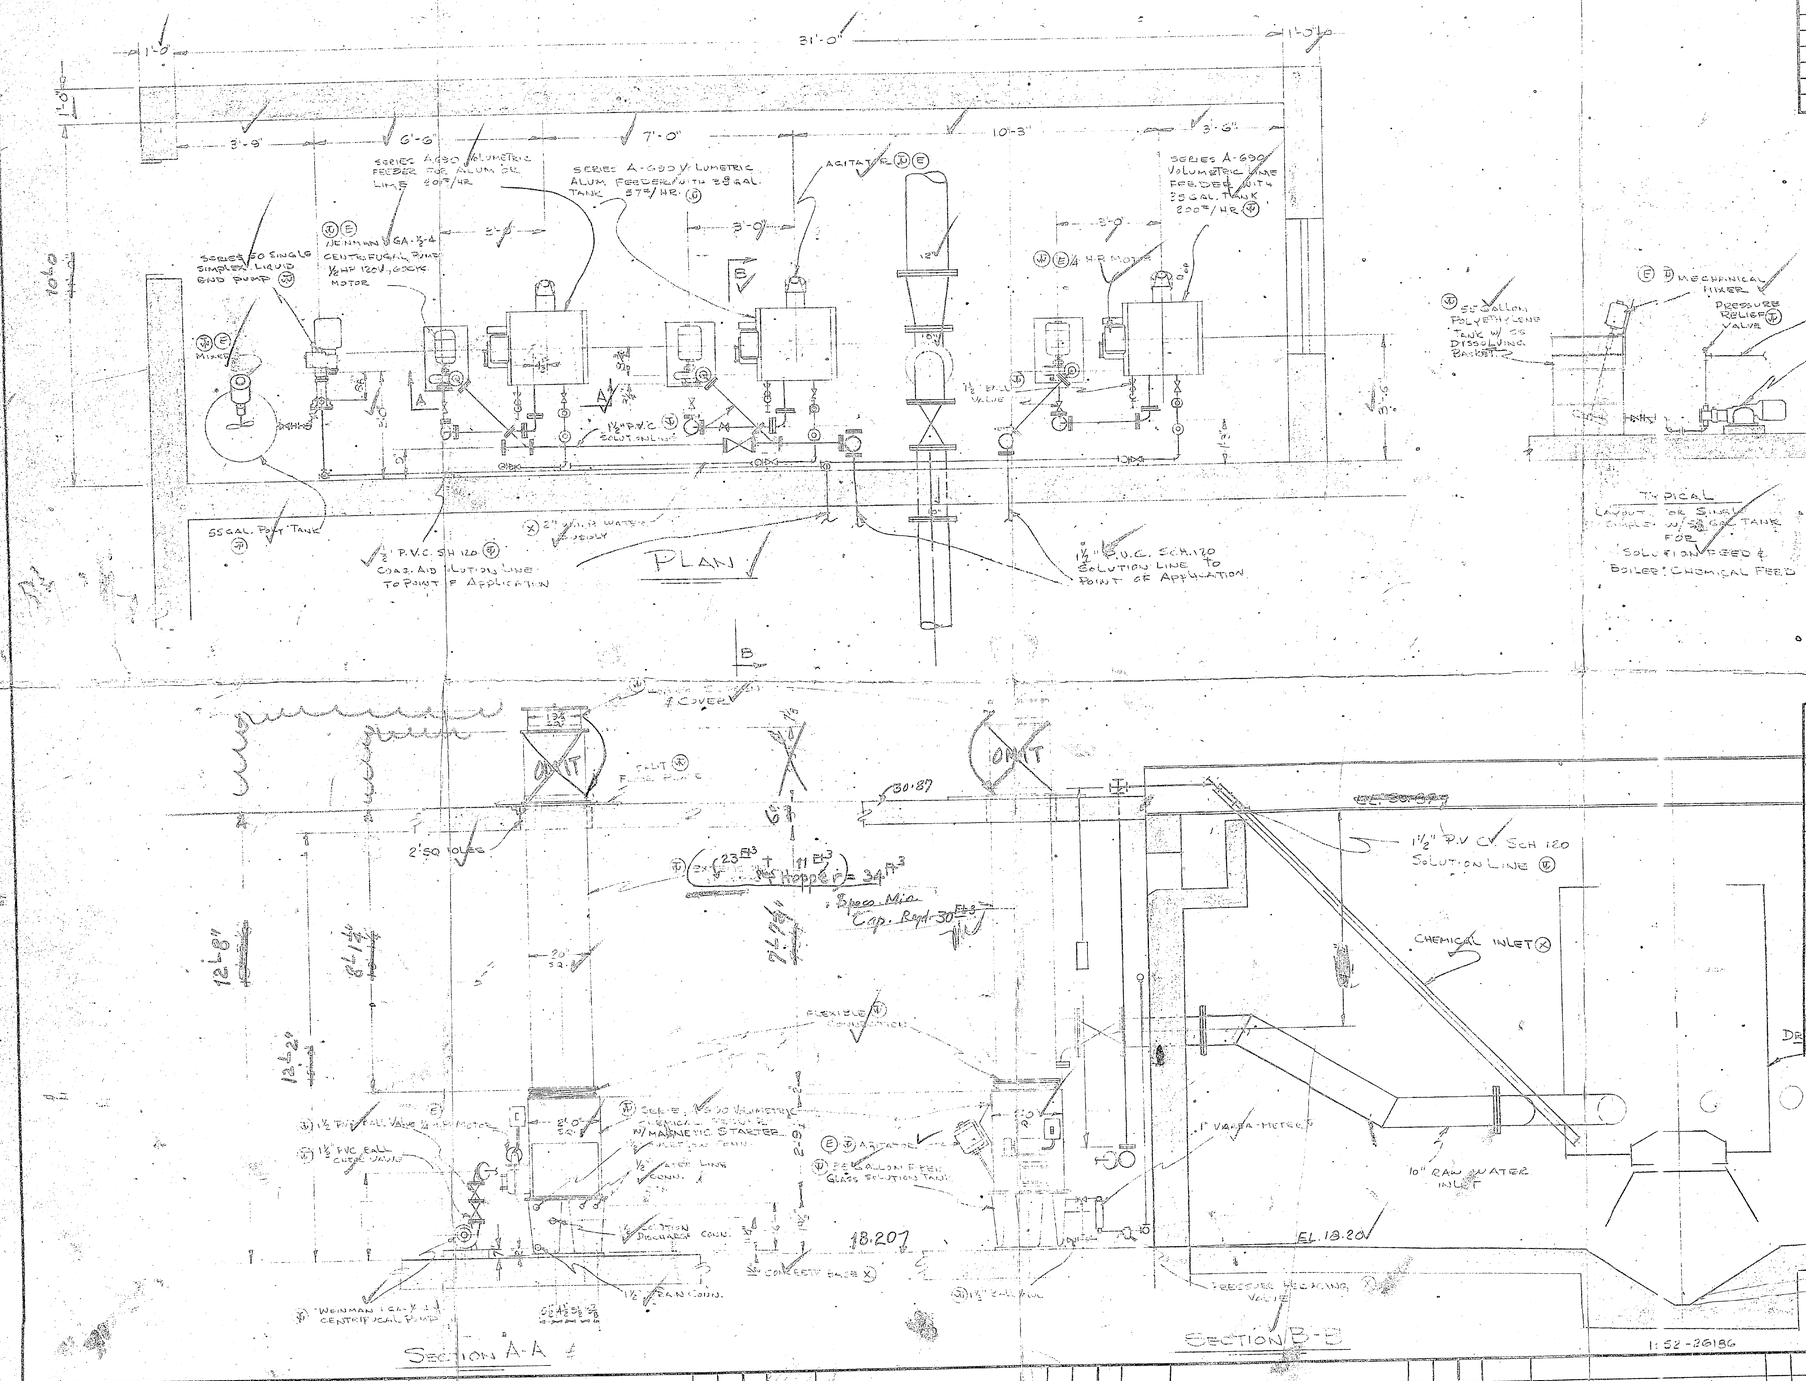

WM. F. FREEMAN, INCORPORATED
ENGINEERS AND ARCHITECTS
HIGH POINT, NORTH CAROLINA

DISTRICT PUBLIC WORKS OFFICE
NAVAL STATION NORFOLK, VA.

APPROVED AS NOTED

SUBJECT TO REQUIREMENTS OF

CONTRACT NBy 40139 SPEC. 40139/61
APPROVAL OF MATERIALS AND/OR EQUIPMENT INDICATES COMPLIANCE WITH SPECIFICATION REQUIREMENTS ONLY. THE CONTRACTOR SHALL BE RESPONSIBLE FOR PROVIDING PROPER PHYSICAL DIMENSIONS & WEIGHTS, COORDINATION OF TRADES, ETC., AS REQUIRED

DATE: 15 Aug 62 HENRY C. SHAID CAPTAIN, CEC, USN DISTRICT PUBLIC WORKS OFFICER

DATE: 8/18/62
CHECKED BY: VVM

Refer Engrs. Dwg. Y&D #883124

(WT) INDICATES MATERIALS FURNISHED BY W. & T.
(E) ELECTRICAL CONN.
(X) INDICATES MATERIALS FURNISHED BY OTHERS

INSTALLATION LAYOUT OF CHEMICAL CONTROL EQUIPMENT
MARINE CORPS AIR FACILITY
NEW RIVER, NORTH CAROLINA

WALLACE & TIERNAN INCORPORATED
BELLEVILLE, N. J.

DRN. SC	CHECKED	SHEET
DATE 6-22-62		OF
SCALE		

APP'D. Chief Engineer

DWG. No. 4515813

	DATE	REVISION	BY	CKD
A	7-9-62	AS PER MARKED PRINT	SC	
B	7-16-62	REMOVED CONSTANT LEVEL TANK	HDB	

DEFIANCE NO. 10711 59723