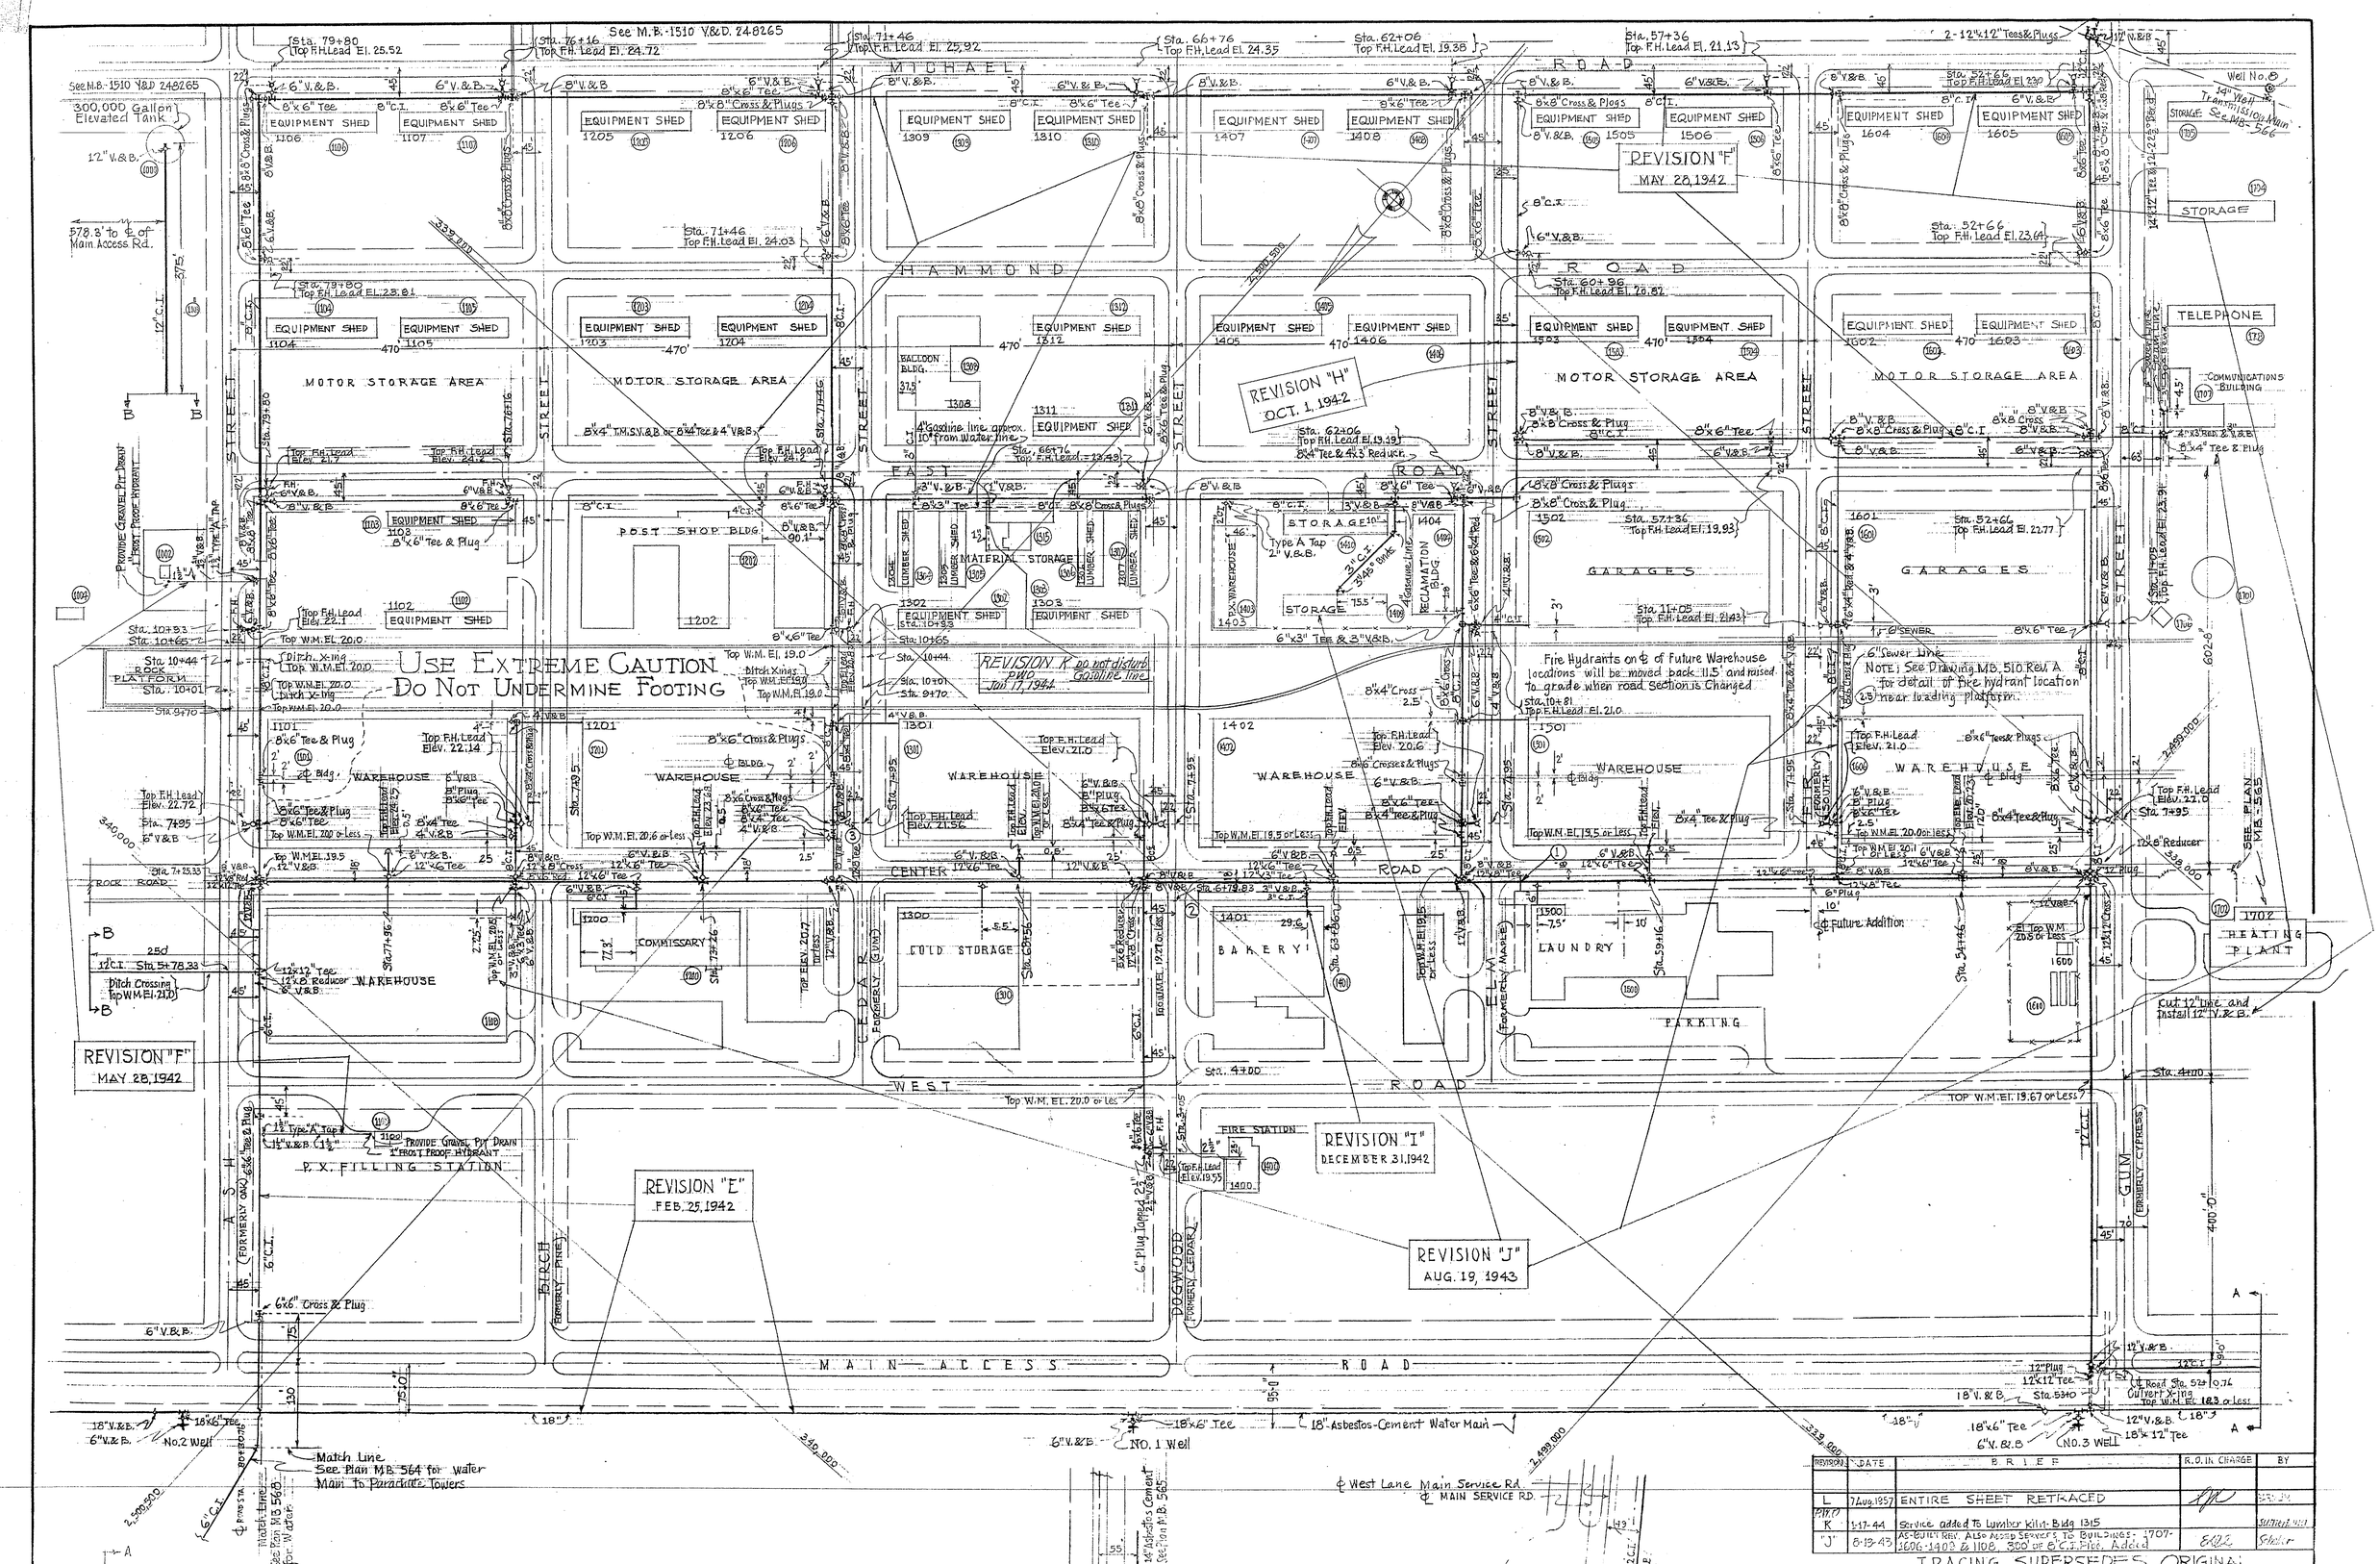

REVISION	DATE	BRIEF	R.O. IN CHARGE	BY
L	7 Aug. 1957	ENTIRE SHEET RETRACED		
M.P.O. K	1-17-44	Service added To Lumber kiln - Bldg 1315		
"J"	8-19-43	AS-BUILT REV. ALSO ADDED SERVICES TO BUILDINGS: 1707-1606-1403 & 1108. 300' OF 6" C.I. Pipe Added		

TRACING SUPERSEDES ORIGINAL

REVISION	DATE	BRIEF	R.O. IN CHARGE	BY
"I"	12/31/42	As-Built Revisions to Water Distribution System Added Bldg. Nos.		
"	10-1-42	Water Main along MAPLE Street Between East & Michael Road.		
"G"	7-25-42	SERVICE TO P.X. WAREHOUSE ADDED		
"F"	3-28-42	MAINS & SERVICES ADDED ALONG CYPRESS - SOUTH AVE & EAST ROAD. SERVICE TO POST SHOP & GASOLINE STATION VALVE AT CYPRESS & CENTER		
E	2-25-42	6" WATER MAIN TO PARACHUTE TOWERS & TRANSMISSION MAINS FROM WELLS		
D	9-25-41	Complete Distribution and Fire Protection System Along Center from Wood to Cedar		
C	9-2-41	Tees and Services Added for Laundry, F.S. & Houses & Commissary F.H.'s		
B	6-25-41	Revised and Reversion, Relocation of Fire Station Center Rd. Paving Changed, Tank Relocated		
L	8-1-41	Plan Revised Warehouse, Of 470' Change in Location		

REVISION	DATE	BRIEF	R.O. IN CHARGE	BY

DRAWN BY J.W.S.-O.Y.H. Jr.
TRACED BY O.Y.H. Jr.
CHECKED BY J.W.S.-F.D.K.
CHIEF DFM'N F.D.K.
IN CHARGE N.C.M.
DATE Aug. 25, 1941
SCALE 1" = 100'

Y. & D. DRAWING NO. 162183

ARCHITECT - ENGINEERS SPECIFICATION No. 501

CARR & J. E. GREINER CO. — ARCHITECT - ENGINEERS
DURHAM, N.C. BALTIMORE, MD.

MARINE BARRACKS — NEW RIVER, N.C.
BUREAU OF YARDS AND DOCKS — U.S. NAVY

12" FEEDER MAIN & WATER DISTRIBUTION SYSTEM SUPPLY AND INDUSTRIAL AREA

APPROVED Sept. 3, 1941
BY Gordon Nichols
RESIDENT OFFICER IN CHARGE

SHEET ___ OF ___

M.B. PROJ NO. P-108-4
M.B. DWG. NO. 503