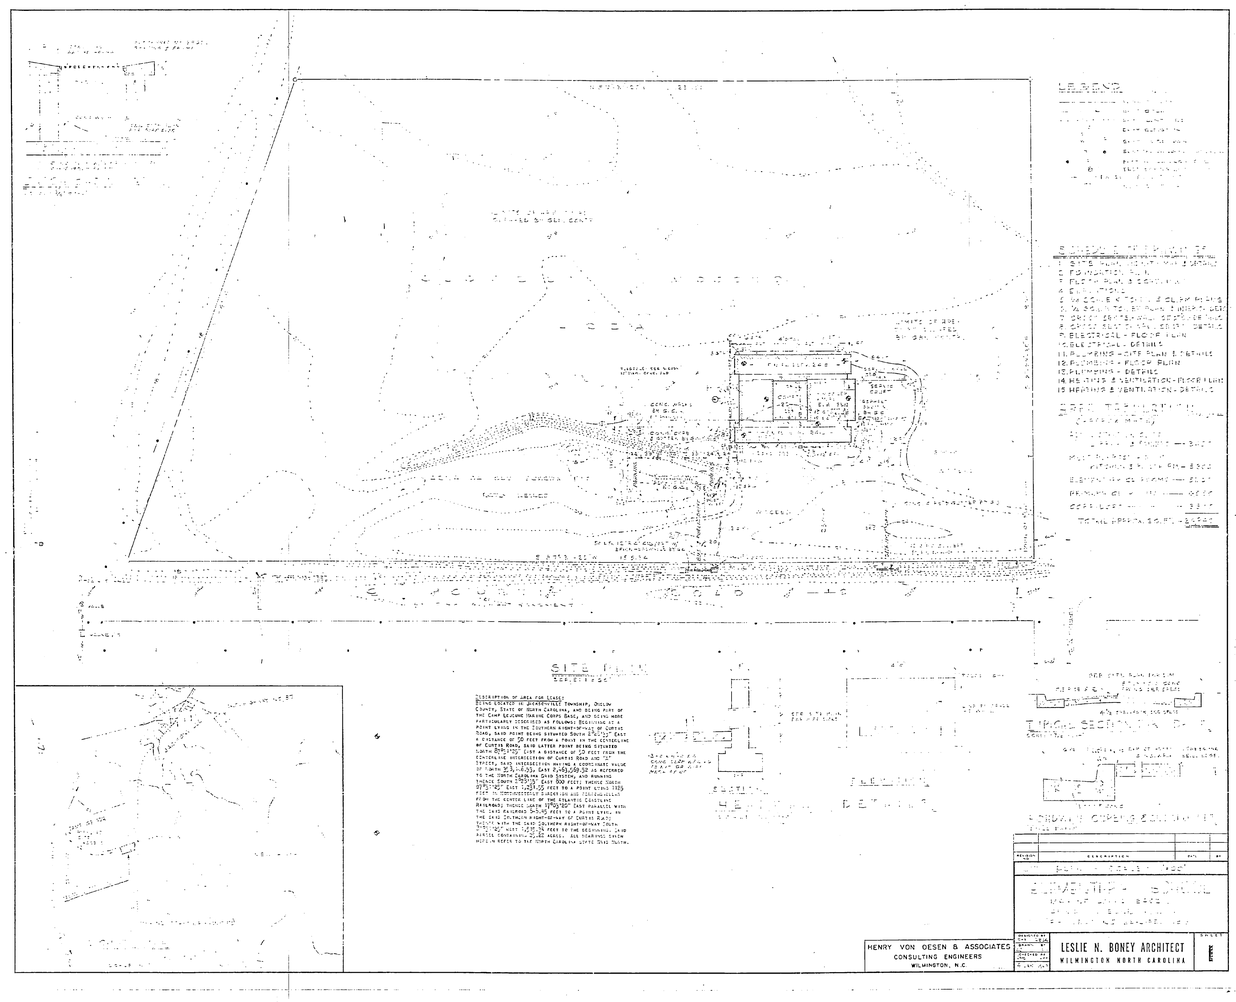
LEGEND
SITE PLAN
FOUNDATION PLAN
FLOOR PLAN & SECTION
ELEVATIONS
WALL SECTIONS & DOOR SCHEDULE
DETAILS
ELECTRICAL - FLOOR PLAN
ELECTRICAL - DETAILS
PLUMBING - SITE PLAN & DETAILS
PLUMBING - FLOOR PLAN
PLUMBING - DETAILS
MECHANICAL & VENTILATION - FLOOR PLAN
HEATING & VENTILATION - DETAILS
SITE PLAN
DESCRIPTION OF AREA FOR ESCAPE
TYPICAL SECTION
FOUNDATION DETAILS
HENRY VON OESEN & ASSOCIATES
CONSULTING ENGINEERS
WILMINGTON, N.C.
LESLIE N. BONEY ARCHITECT
WILMINGTON NORTH CAROLINA

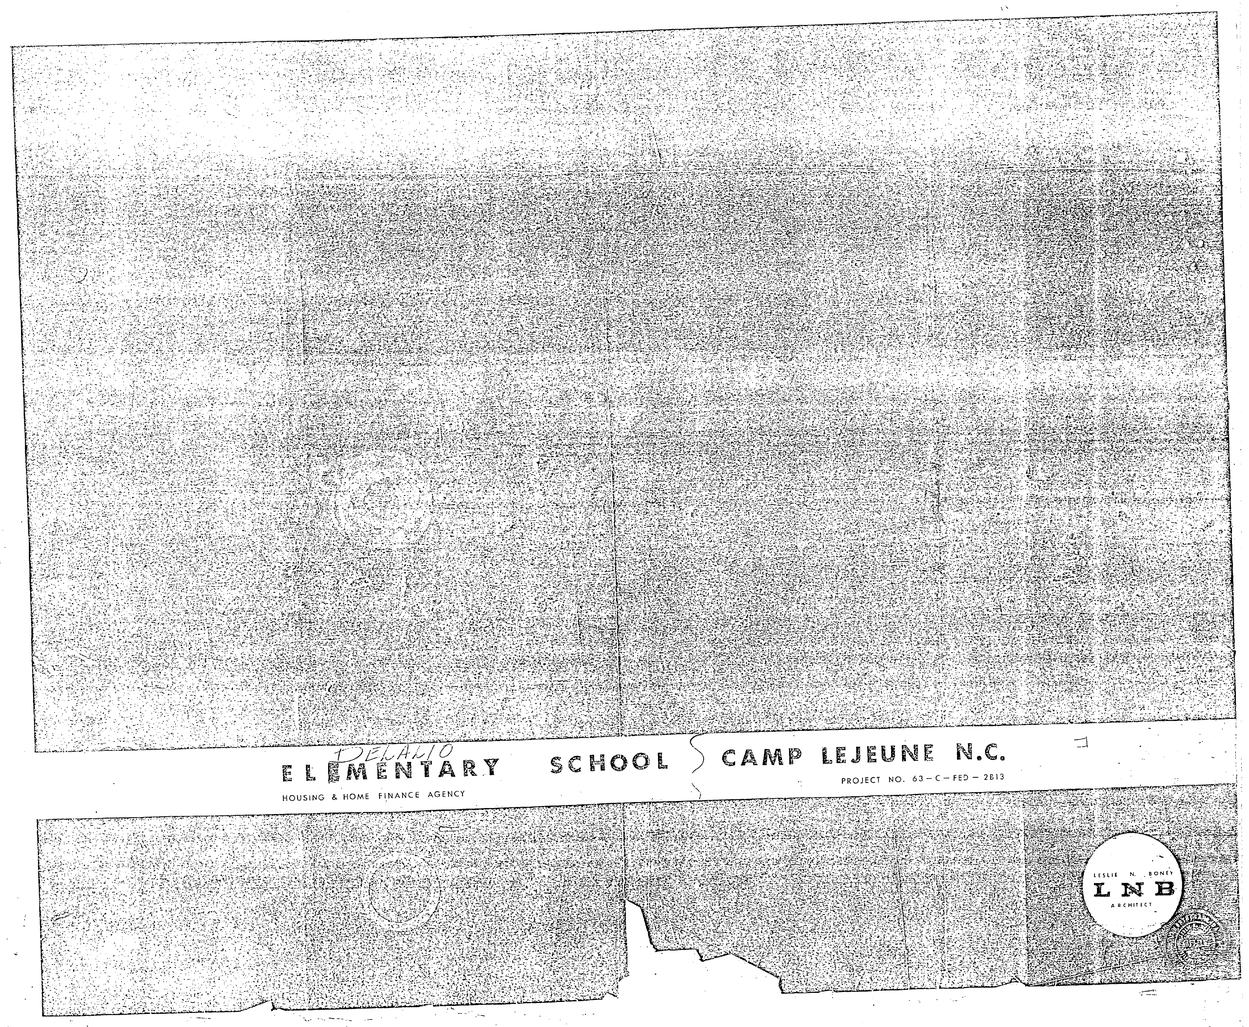
ELEMENTARY SCHOOL
CAMP LEJEUNE N.C.
PROJECT NO. 63-C-FED-2813
HOUSING & HOME FINANCE AGENCY
LESLIE N. BONEY
L N B
ARCHITECT

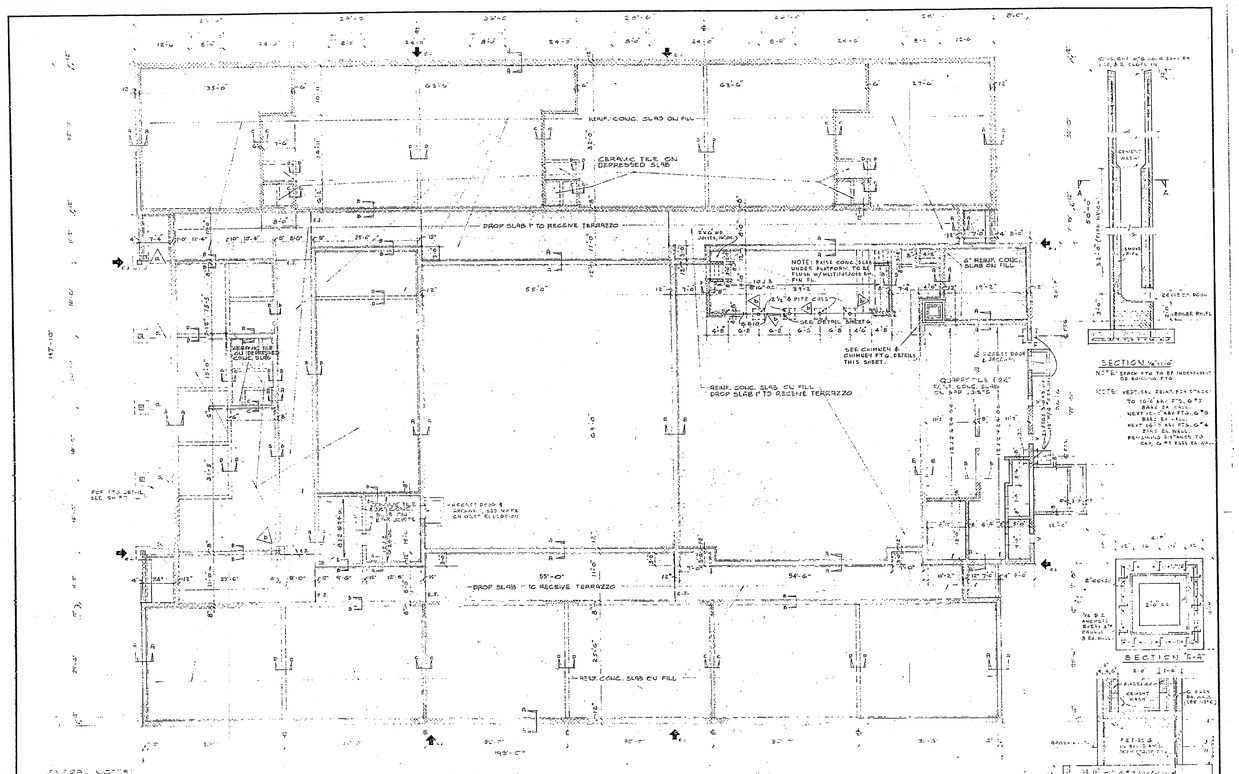

FLOOR NOTES:

1. On East side of building provide concrete retaining wall with top soil fill for planting area extending from East face of colloms to East face of the administrative offices. Retaining wall shall by pass on East side of 5 concrete columns and extend 65'-0" from face to face.

The top of wall to align with concrete platform, and shall be 6" wide with 3/4" chamfered edges. Back to be straight with front exposed wall face to taper to width at bottom which is to be 18" minimum below existing grade.

Provide 6 x 6-10-10 gauge mesh reinforcing. Provide #6 all shaped dowels 1 long and anchor 6" oc to concrete columns. Provide ½" flexcell expansion at center line of each column.

Exterior steps shall have top riser align with CB-1 exterior brick wall return each tread 12" each side to concrete and brick walls. Have dim to sides to clar the step returns.

REVISED	DESCRIPTION	DATE	BY
	FOUNDATION PLAN		

ELEMENTARY SCHOOL
MCAGLE COSBY BASE
CAMP LEJEUNE, N.C.
PROJECT NO 65-D-FED-SBIS

DESIGNED BY	LESLIE N. BONEY ARCHITECT
DRAWN BY	WILMINGTON NORTH CAROLINA
CHECKED BY	
APPROVED BY	
DATE	SHEET 2

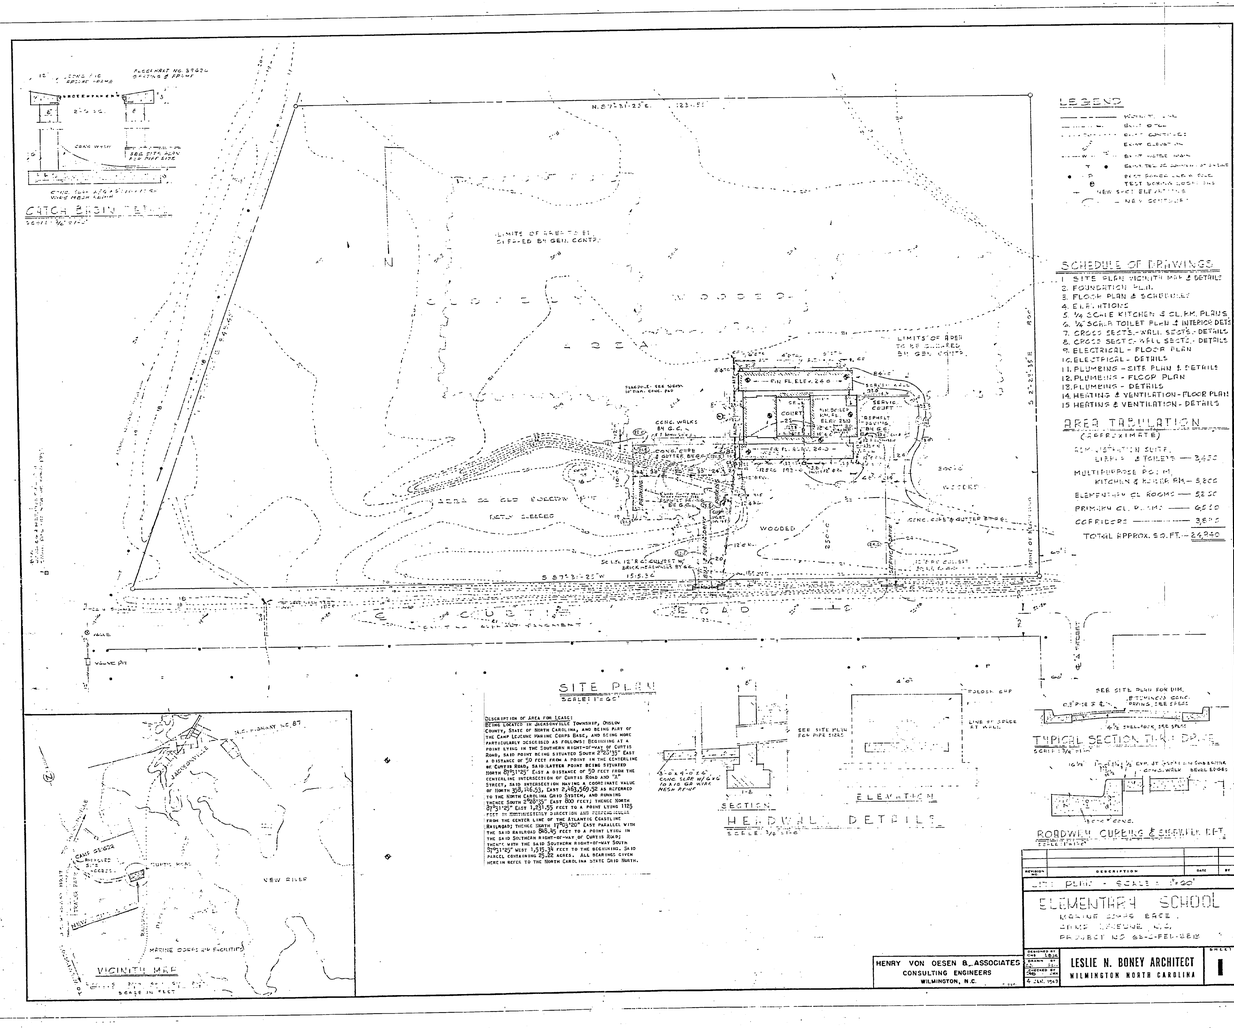
CATCH BASIN "A"
LEGEND
SCHEDULE OF DRAWINGS
1. SITE PLAN, VICINITY MAP & DETAILS
2. FOUNDATION PLAN
3. FLOOR PLAN & SCHEDULES
4. ELEVATIONS
5. 1/4 SCALE KITCHEN & EL. RM. PLANS
6. 1/4 SCALE TOILET PLANS & INTERIOR DETS
7. CROSS SECTS. - WALL SECTS. - DETAILS
8. CROSS SECTS. - WALL SECTS. - DETAILS
9. ELECTRICAL - FLOOR PLAN
10. ELECTRICAL - DETAILS
11. PLUMBING - SITE PLAN & DETAILS
12. PLUMBING - FLOOR PLAN
13. PLUMBING - DETAILS
14. HEATING & VENTILATION - FLOOR PLAN
15. HEATING & VENTILATION - DETAILS
AREA TABULATION
(GROSS AREA)
CLASSROOMS & TOILETS — 3,622
MULTIPURPOSE ROOM
KITCHEN & SERVER RM — 5,826
ELEMENTARY EL. ROOMS — 12,150
PRIMARY EL. RMS. (2) — 6,510
CORRIDORS — 3,672
TOTAL APPROX. SQ. FT. — 24,940
VICINITY MAP
SCALE: 1" = 1000'
SITE PLAN
DESCRIPTION OF AREA FOR LEASE:
TYPICAL SECTION THRU DRIVE
CURB WALK
RETAINING WALL
HEADWALL DETAILS
SECTION
ELEVATION
CONC. SLOPE WALL
CONC. WALKS
CONC. CURB & GUTTER
ASPHALT PAVING
WOODED
ENTRANCE COURT
SERVICE COURT
FIN. FL. ELEV. 24.0
SEE SITE PLAN FOR DIM.
SEE SITE PLAN FOR PIPE SIZES
SLOPE GRP
LINE OF SPACE AT WALL
SEE SITE PLAN FOR DIM.
RETAINING WALL
CONC. WALK
SIGNAL BOXES
CURB & GUTTER
CONC. WALKS
CURB & GUTTER
ASPHALT PAVING

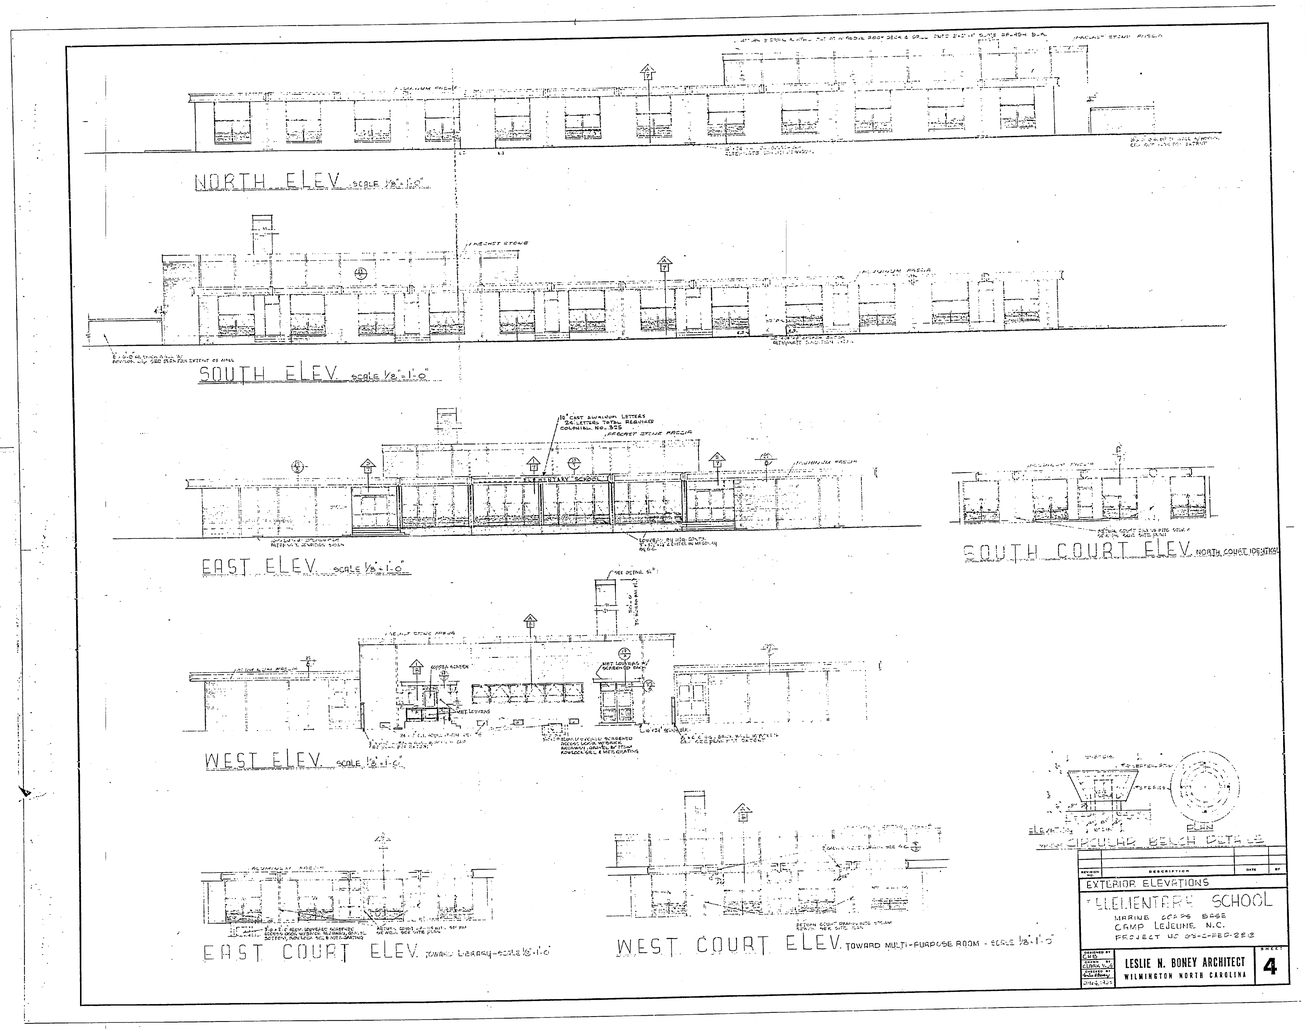
NORTH ELEV. SCALE 1/8"-1'-0"
SOUTH ELEV. SCALE 1/8"-1'-0"
EAST ELEV. SCALE 1/8"-1'-0"
SOUTH COURT ELEV. NORTH COURT IDENTICAL
WEST ELEV. SCALE 1/8"-1'-0"
EAST COURT ELEV. TOWARD LIBRARY - SCALE 1/8"-1'-0"
WEST COURT ELEV. TOWARD MULTI-PURPOSE ROOM - SCALE 1/8"-1'-0"
CIRCULAR BENCH DETAIL
EXTERIOR ELEVATIONS
ELEMENTARY SCHOOL
MARINE CORPS BASE
CAMP LEJEUNE, N.C.
PROJECT NO. 65-C-FED-2618
LESLIE N. BONEY ARCHITECT
WILMINGTON NORTH CAROLINA
4

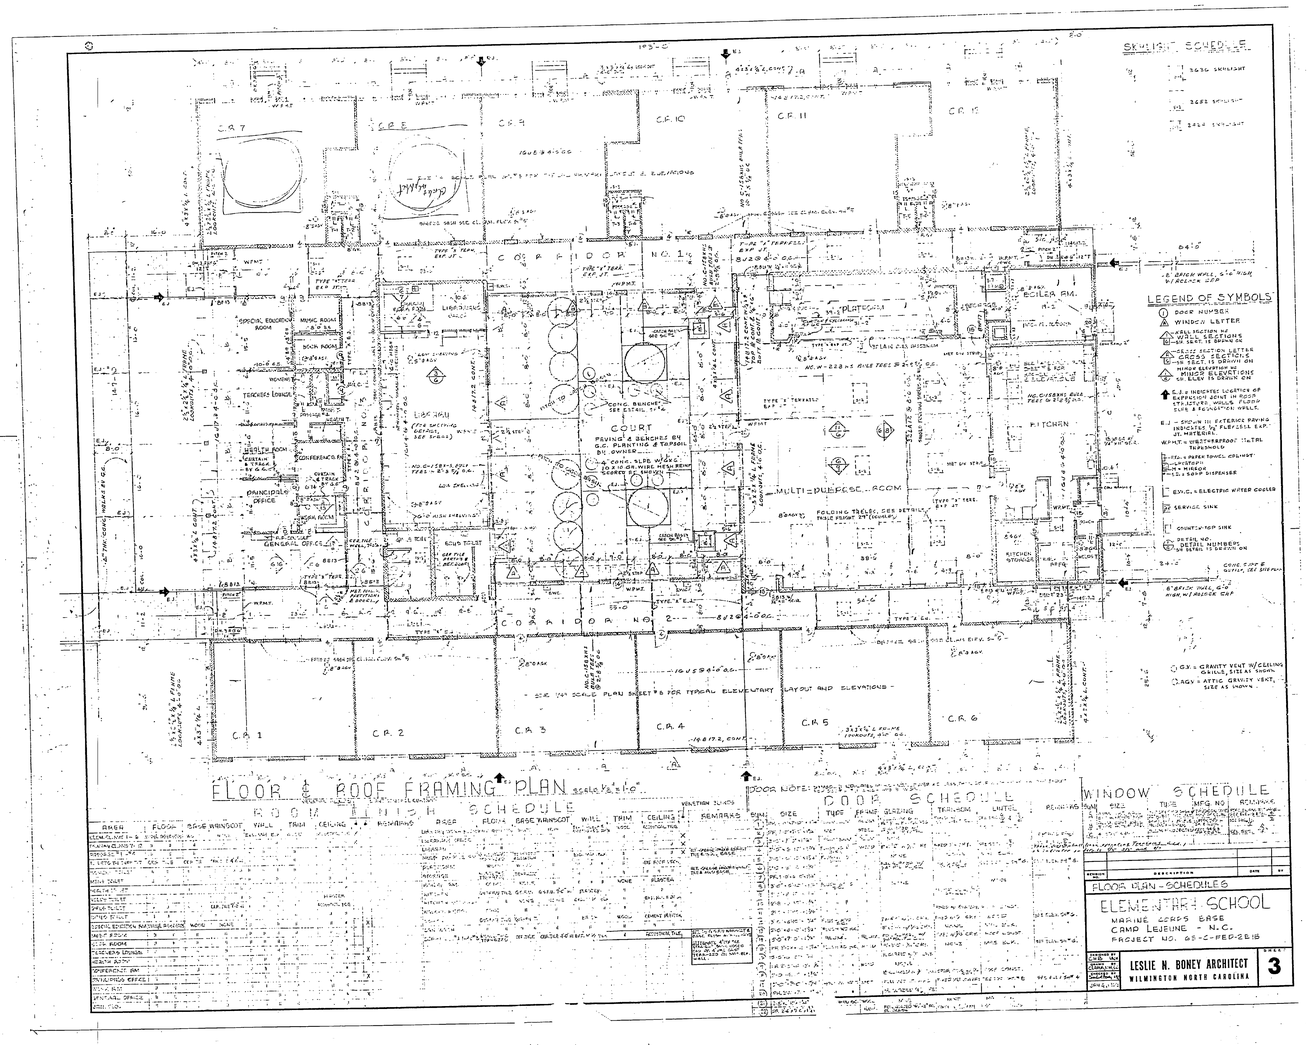
FLOOR & ROOF FRAMING PLAN scale 1/8"=1'-0"
SKYLIGHT SCHEDULE
LEGEND OF SYMBOLS
CORRIDOR NO. 1
CORRIDOR NO. 2
COURT
MULTI-PURPOSE ROOM
KITCHEN
BOILER RM.
LIBRARY
PRINCIPAL'S OFFICE
C.R. 1
C.R. 2
C.R. 3
C.R. 4
C.R. 5
C.R. 6
ROOM FINISH SCHEDULE
DOOR SCHEDULE
WINDOW SCHEDULE
FLOOR PLAN - SCHEDULES
ELEMENTARY SCHOOL
MARINE CORPS BASE
CAMP LEJEUNE - N.C.
PROJECT NO. 65-C-FED-2618
LESLIE N. BONEY ARCHITECT
WILMINGTON NORTH CAROLINA
3

ELEV. scale ¼"-1'-0"

ELEV. scale ¼"-1'-0"

ELEV. scale ¼"-1'-0"

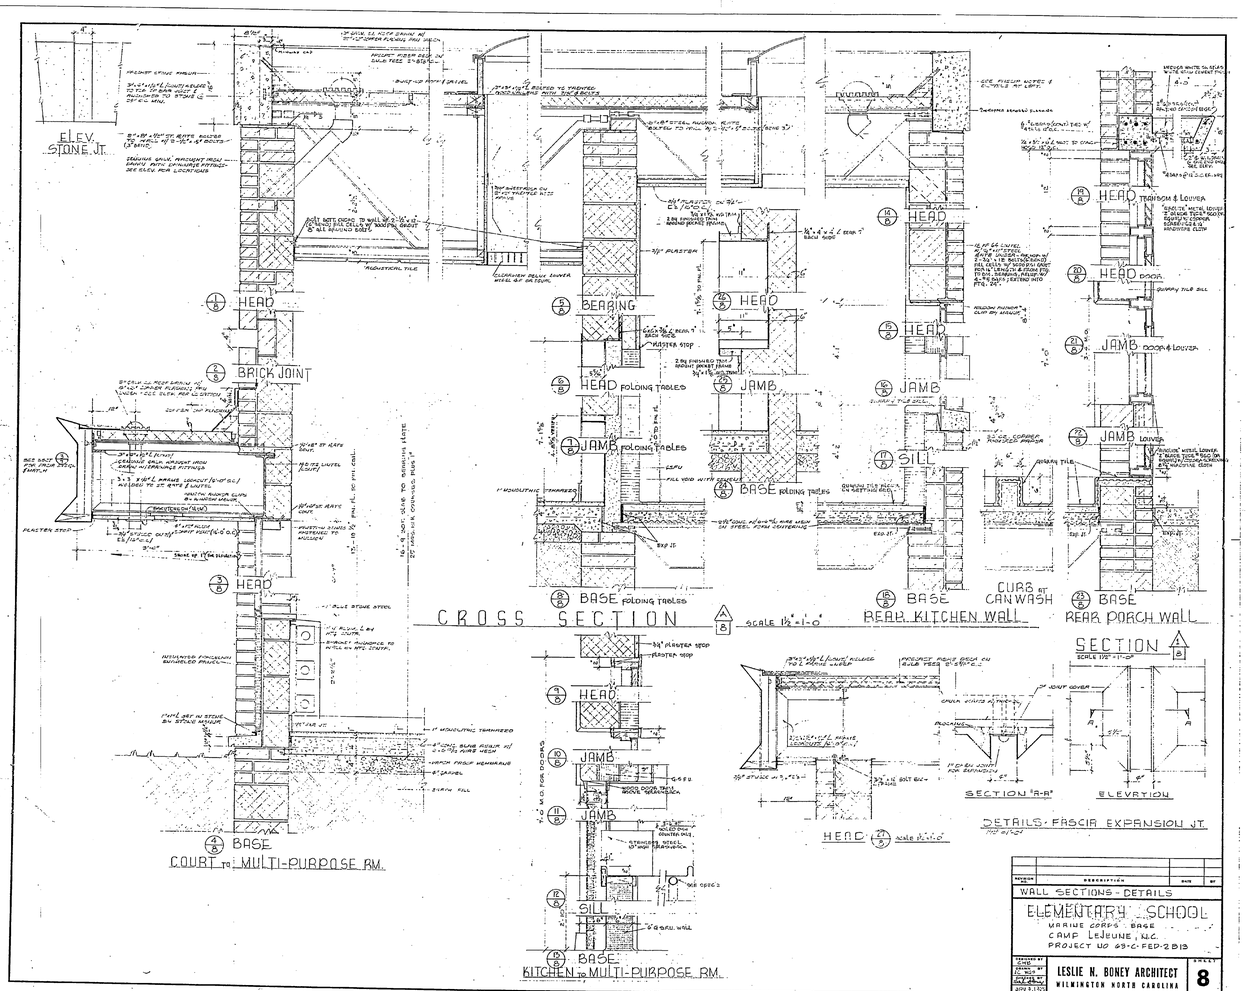
ELEV. STONE JT.
HEAD
BRICK JOINT
HEAD
BASE
COURT to MULTI-PURPOSE RM.
CROSS SECTION
scale 1½"=1'-0"
BEARING
HEAD FOLDING TABLES
JAMB FOLDING TABLES
BASE FOLDING TABLES
HEAD
JAMB
SILL
BASE
KITCHEN to MULTI-PURPOSE RM.
HEAD
JAMB
SILL
BASE
REAR KITCHEN WALL
CURB at CANWASH
HEAD TRANSOM & LOUVER
HEAD DOOR
JAMB DOOR & LOUVER
JAMB LOUVER
BASE
REAR PORCH WALL
SECTION
SECTION "A-A"
ELEVATION
DETAILS · FASCIA EXPANSION JT.
HEAD
WALL SECTIONS - DETAILS
ELEMENTARY SCHOOL
MARINE CORPS BASE
CAMP LEJEUNE, N.C.
PROJECT NO 69-C-FED-2813
LESLIE N. BONEY ARCHITECT
WILMINGTON NORTH CAROLINA
8

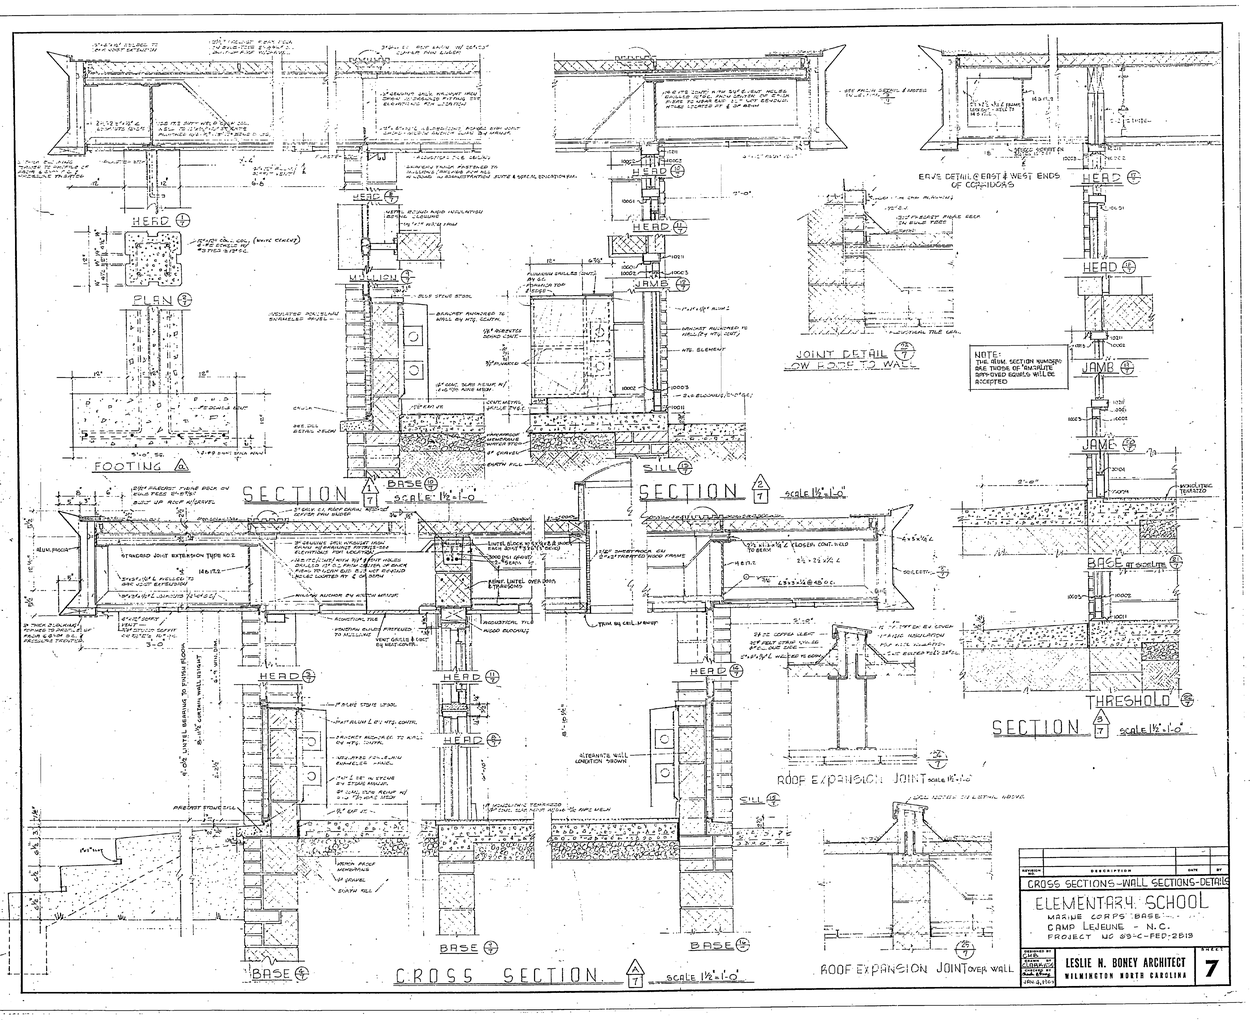
PLAN
FOOTING
SECTION
scale 1½"=1'-0"
BASE
HEAD
JAMB
SILL
CROSS SECTION
scale 1½"=1'-0"
JOINT DETAIL OVER POST TO WALL
NOTE:
THE NEW SECTION NUMBERS SHOWN THUS OR SIMILAR TO THOSE OF SUPERSEDED BOARDS WILL BE ACCEPTED
ROOF EXPANSION JOINT
ROOF EXPANSION JOINT over WALL
ERVS DETAIL @ EAST & WEST ENDS OF COLONNADES
BASE at SCORE LINE
THRESHOLD
CROSS SECTIONS-WALL SECTIONS-DETAILS
ELEMENTARY SCHOOL
MARINE CORPS BASE
CAMP LEJEUNE - N.C.
PROJECT NO 69-C-FED-2813
LESLIE N. BONEY ARCHITECT
WILMINGTON NORTH CAROLINA
7

FIXTURE SCHEDULE

TYPE	LAMP / VOLTAGE	DESCRIPTION	MFGR.	CAT. NO.	OPTIONS
A	300 w DE MED. SILVER BOWL	CONVENTIONAL RING UNIT 90° OPENING DROP ALUMINUM CONSTRUCTION - PORTABLE PENDANT	RUSS WIDMAN	S 5583 B	WITH PRISMAT
B	20" TO 0-60 1P 2-100 3-150	DRUM TYPE CEILING UNIT - SAFETY PANNS OR SPRING - INSULATED - FLANGED HEAD TYPE	LIGHTOLIER CORP. LIMING	6 SW 1 6 SW 2 6 SW 3	PERFECTITE WITH
C	100 W A. C.	GEN'L USE LIGHT WITH GUARD - PORT ALUM. CONST.	FEDERALITE	C P C 6	-
D	18" TO 150 W	BOWL REFLECTOR PENDANT MOUNTED ON ALL CANOPY BASE, SUSPEND 8-0" OR AS NOTED	BRUNING & SAULTE	V 9651 RLC 6 150	HOLDER GUARD
E	300 W	KELLEX PORCELAIN LAMP HOLDER	BRYANT	9313	~
F	100 W	VAPOR TIGHT UNIT WITH GLASS AND GUARD UNIT GUARD IN RANGE HOOD	CROUSE HINDS	VTAR 1149	WITH PRISMATIC
G	300 W 2 LAMP	RECESSED FLUORESCENT UNIT - FLUSH TYPE WITH LOUVERED TYPE - GLASS DIFFUSER	MILLER	1312 D	DAYGLOW LIGHTOLIER
H	100 W I P	RECESSED LIGHT WITH REFLECTABLE GLASS SHIELD	-	P. S.	A-3327 S	~
J	150 W	30° - RECESSED INC. GIMBAL WITH OPAL GLASS DIFFUSER - REWIRED	LIGHTOLIER CORP.	NYTEX C 6 W	1715	~
K	75 W R30 FLOOD	RECESSED ADJ. FLOOD WITH 7" GLASS LOUVER AND (TYPE) CLOSE LENS & BACK IN RED, BRONZE BLUE AND GREEN	CROUSE HINDS	GYDALITE	1814	~
L	3-150 W PAR 38 FLOOD LAMPS	OPEN TYPE FLOOD LIGHT - MOUNTED ON ALL SIDES OF BASE OF FLAG POLE - WITH 3 LAMP HOLDERS CLUSTER FITTING AND 3 LAMP HOLDERS	SYLVANIA ELECTRIC	SPG-1355	HOLDERS SPG-250
M	4-40 W 48" PRE A. P. SEATING COOL WHITE 5400	LOUVERED RAPID START FLUORESCENT UNIT - PRODUCT NO. 24 GAUGE STEEL HOUSING, METAL ENDS, STEEL LOUVERS, ALUMINUM REFLECTOR - FACTORY WIRED TO BE SET UP FOR "RAPID START" BALLASTS AS REQ'D.	DAYLIGHTER	FC 548-4-SE	MILLER
N	1-40 W 48" INC. WHITE THEN PER A. P. SEATING	SURFACE MOUNTED FLUORESCENT UNIT - PRISMATIC PLASTIC DIFFUSER	L.P.I. CATERPILLAR	F 1464 A	MILLER DAYGLOW
P	2-150 PAR 38 FL	CYLINDER WALL BRACKET - UP AND DOWN FLOOD LAMPS - FINISH, WITH WEATHER PROOF SHEATH ALL OUTSIDE USE	PEERLESS	WB-9313 MED-1980	~

⊗1 EXIT LIGHT & CEILING MOUNTED, RED GLASS METAL SCRIBE PERFECTITE PE-231 (WITH BATTERIES) 2-25 W IP LAMPS

⊗2 EXIT LIGHT - WALL MOUNTED 15'-0" ABOVE GRADE PERFECTITE PE-241

⊗3 EXIT LIGHT - WITH EXIT MOUNTED 2-25 W IP " PE-151
EXIT SIGN

PANEL 'K' SCHEDULE

400 A 208 W 120/208 3PH - 4W - 60 CY

CIRCUIT	AMPS	POLES	VOLTS	WIRE & CONDUIT	FEEDS
1, 3	20	1	120	#12-2 w #3/4"	LIGHTS IN MULTIPURPOSE
2, 4	20	1	120	"	GYM
5, 7	20	1		"	LIGHTS + REC. RM. # 6
6, 8	20	1		"	" REC. RM. #5
9	20	1		"	SPARE (MIN.)
10, 12	20	1		#12-3 w	EXTERIORS: EL. #1
11	20	1		#12-2 w #3/4"	EXTERIORS: FLAG POLE
13	20	1		"	EXTERIORS: PLANTER
15	20	1		2 #12 w "	2 RECEPT. IN KITCHEN
14	40	2		"	STOVE
16	40	2		"	"
17	30	1		"	SPARE
19	30	1		"	"
18	30	2		"	"
20	30	2		"	"
21	70	3	208	#10-3 w #3/4"	FEED WARMER
23	50	3		#8-3 w #1"	2 RANGE, 2 OVEN RECPT.
25	70	3		#6-3 w #1"	DISH WASHER
27	70	3		#4-3 w #1 1/4"	1 DISP. 1 DW
29	50	3		#6-3 w #1"	REFRIG. COMPR. AT CONDENSING UNIT
31	50	3		#6-3 w #1"	SPARE
33	50	3		#6-3 w #1"	"
35	50	3		#6-3 w #1"	"

PANEL'S END TO HAVE S.W. GUTTERS
BUS: TOP - BOTTOM

PANEL 'A' SCHEDULE

100 A 240 W 120/240 1 PH - 3 WIRE

CIRCUIT	AMPS	POLES	VOLTS	WIRE & CONDUIT	FEEDS

PANEL 'B' SCHEDULE

100 A 208 W 120/208 3 PH - 4 W

1, 3	20	1	120	#12-2 w #3/4"	LIGHTS - CLASS ROOM 1
2, 4	20	1		Dia.	" " 2
5, 7	20	1		Dia.	" " 3
6, 8	20	1		Dia.	" " 4
9, 11	20	1		Dia.	" " 5
10	20	1		Dia.	" " 6
12	20	1		Dia.	2 - TOILET RMS & RECEPT. PANS
13	30	1		Dia.	1 - HALL AND WATER COOLER
15	30	1		Dia.	1 - RECEPT - JANITORS ETC.
17	20	1		Dia.	1 - EXTRA LIGHTS
14	20	1			SPARE
16	20	1			"
18	30	3	208		HEATING UNIT
20	30	3			"
19	30	3	120	#12-3 w #3/4"	HEATING UNIT
21	30	3			"

PANEL 'C' SCHEDULE

100 A 208 W 1 PHASE 3 WIRE MAIN BUS BAR

1, 3, 5	20	1	120	#12-2 w #3/4"	LIGHTS - CLASS ROOM 7
2, 4, 6	20	1		Dia.	" " 8
7, 9, 11	20	1		Dia.	" " 9
8, 10	20	1		Dia.	" " 10
12	20	1		Dia.	" " 11
14	20	1		Dia.	" " 12
16	20	1		Dia.	" " 13
18	20	1		Dia.	2 MALE WING WATER COOLERS
20	20	1		Dia.	" " " "
22	30	1		Dia.	SPARE
24	30	1		Dia.	"
26	50	3	240	#10-3 w #3/4"	HEATING UNITS
28	50	3			" "
30	50	3	120	#12-2 w #3/4"	SPARE
32	50	3			"

PANEL 'D' SCHEDULE

100 A 208 W 120/208 3 PH - 4 W MAIN BUS BAR

1, 3, 5	20	1	120	#12-2 w #3/4"	LIGHTS + CLASS ROOM 7
2, 4, 6	20	1		Dia.	" " 8
7, 9, 11	20	1		Dia.	" " 9
8, 10	20	1		Dia.	" " 10
12	20	1		Dia.	SPARE TO #14
14	20	1		Dia.	" " #16
16	20	1		Dia.	LIBR. WORK ROOM
18-20	20	2		Dia.	LIBRARY
22	20	1		Dia.	2 RECEPT. INTER RM. CO.
24	20	1		Dia.	RECEPTACLES IN 13, 14, 15
26	20	1		Dia.	" " 16, 17, 18
28	20	1		Dia.	SPARE
30	20	1		Dia.	"
32	20	1		Dia.	2 WALL HUNG WATER COOLERS
34	20	1		Dia.	" " " "
36	50	3	240		HEATING UNITS
38	50	3			" "
40	50	3	120	#12-2 w #3/4"	SPARE
42	50	3			"

PANEL 'BR' SCHEDULE

100 A 208 W 1 PH 3 WIRE MAIN BUS BAR

1	50	1	120	#10-2 w #3/4"	RECEPT. BOYS ROOM
3	50	1	120	"	RECEPT. + EXH. FAN
5	50	1		Dia.	RECEPT. GIRLS ROOM
7	50	1		Dia.	BOILER CONTROLS
9	20	1		Dia.	TIME SW. FOR CIRC. CONTROLS
11	20	1		Dia.	CIRCULATOR - DOMESTIC HOT WATER
13	20	1		Dia.	" RECIRC. LINE
15	20	1		Dia.	CIRCULATOR - ZONE 1
17	20	1	1/4" SL WIRE GUTTER		SPARE
19	30	1			"
21	30	1			"
23	30	1			"
25	30	1			SPARE, NO OIL BURNER
27	30	1			"
29	30	1			OIL BURNER OR SPARE
31	30	1			SPARE

PANEL 'O' SCHEDULE

100 A 208 W 1PH 3 WIRE MAIN BUS

1	20	1	120	#12-2 w #3/4"	1 EXH. FAN & 6 OUTLETS LTS
3	20	1		"	LIGHTS - CEIL. OFFICE
5	20	1		"	" - TOILETS & JANITORS
7	20	1		"	CORRIDOR
9	20	1	#10-3 w #3/4"		SPARE
11	20	1	#10-3 w #3/4"		"
13	20	1	#12-3 w #3/4"		"
15	20	1			RECEPT. OFFICE
17	20	1	#12-2 w #3/4"		RECEPT. CORRIDOR
19	20	1	#12-3 w #3/4"		SPARES - MASTER CLOCK
21	20	1			SPARE - CENTRAL SOUND SYSTEM
23	20	1	#12-2 w #3/4"		TIME SW. - CLOCK OFF
25	20	1	#12-3 w #3/4"		RECEPT. CORRIDOR
27	20	1	#12-2 w #3/4"		SPARES - MASTER CLOCK
29	20	1			TIME SW. - CLOCK ON
31	20	1	#12-2 w #3/4"		" - CENTRAL SOUND
33	20	1			SPARE

SOUND SYSTEM DIAGRAM

TRANSFORMER BANK DETAILS

PARTIAL PLOT PLAN

SERVICE RISER DIAGRAM

ITEM	DESCRIPTION
1	HOT LINE CLAMP
2	DEAD END HOOK
3	SUSPENSION INSULATOR 3½" - 2 PER STRING
4	GROSS ASM. 1¾" x 4½" x 8'-0"
5	STEEL PINE THIMBLE 8'-0" x 11'-0"
6	DOUBLE ARMING BOLT 5/8" x CORD LENGTH
7	BOLT BIG TYPE GUY ATTACHMENT
8	GROUND CLAMP - COPPER ROD TO STEEL - STRAND
9	STEEL ANGLE BRACE 1¾" x 1¾" x ¼" - 60° SPREAD
10	THROUGH BOLT 5/8" WITH NUT & WASHERS
11	4/0 - 2 TO METERING EQUIPMENT
12	LIGHTNING ARRESTOR AS SPECIFIED
13	PHASE CLEVIS AS SPECIFIED
14	1¾" x 90° PLAT BRACE
15	HEAVY DUTY SECONDARY RACK
16	TRANSFORMER PER KVA SEE SPEC. SEC.

ELECTRICAL - DETAILS

ELEMENTARY SCHOOL
MARINE CORPS BASE
CAMP LEJEUNE, N.C.
PROJECT NO 63-C-FED-2813

LESLIE N. BONEY ARCHITECT
WILMINGTON NORTH CAROLINA

SHEET 10

N.C. EES NO. 1058
JOB NO. 653
DATE JAN 65
SHT. NO. E 5 OF 5

GENERAL NOTES

- COLOR CODE ALL WIRING BLACK - RED - BLUE WHITE FOR NEUTRALS.
- NAME ALL PANELS. FILL OUT SCHEDULES COMPLETELY AND COMPLETELY.
- BOND ALL GROUND RECEPTACLES USING A STEEL CITY GROUND CLIP + GREEN WIRE.
- RUN 2 - ¾" EMPTY CONDUITS FROM EACH FLUSH PANEL TO ATTIC ABOVE CEILING.
- COORDINATE WORK WITH MECHANICAL AND ARCHITECTURAL PLANS - DO NOT INSTALL OUTLETS BEHIND RADIATORS.
- IN CONCR. FOOTINGS, TAPES SHALL NOT BE USED ON ANY WIRE SMALLER THAN #6
- PROVIDE WIRING FOR HEATING EQUIPMENT AS REQUIRED.
- TELEPHONE CONDUITS: RUN 1" EC. FROM OUTLETS MARKED "TEL" IN ATTIC ABOVE TO TERMINAL CABINET IN OFFICE AND FROM BOXES RUN ¾" FROM SWITCH OUTLET TO CABINET.
- PUBLIC ADDRESS SYSTEM: CONDUITS FROM SPEAKERS SHALL END IN CAB. W.P. OUTLET BOXES. USE ¾" EC. FOR 1 OR 2 SPKRS.; 1¼" FOR 3, 4 OR 5 SPKRS AND 1" FOR 6 OR 7. PROVIDE CAN BELL PUSH BUTTON MOUNTED FLUSH IN COURTYARD. SEE CONDUIT SEE RISER DIAGRAM ON SHT E-5

SPECIAL NOTES

2. FLUSH MOUNT LIGHT SWITCH AND FAN SPEEDER SWITCH AT DOOR JAMBS. PROVIDE AS PER WIRING DIAGRAM IN CHAPTER AND SELECT WITH PANEL
   a. PROVIDE WIRING FOR JANITOR, JANITORS ROOM, UNIT HEATER. DOWN IN TOP THERMOSTAT AND 48" ABOVE FINISH FLOORS.
   c. 150 C. WALL FLOOD OUTLET, LEVEL WITH 24" CONC. NO. 5 C. W. PURCHASE 4 - 150 W. R30 FLOOD LAMPS TO OWNER.
   d. WIRING FOR FOUNTAIN, SEE SPECIALISTS AND CONTRACTOR.
   e. FLOOR TELEPHONE OUTLET LEVEL WITH SIDE OF EXTERIOR CURB. USE FULL STEEL BOX
   f. PROVIDE DUPLEX + SIGNAL NO. 1906 FLUSH FLOOR DUPLEX AND RE. 1919 CAP AND EXTEND WIRING TO RANGES AND OVEN USING STEEL BRAID CONDUIT NIPPLE AND GREENFIELD ETC.
   j. FLUSH TERMINAL CABINET 2'-0" x 1'-6" - WITH PLYWOOD BACK AND 2 VERT. TAN. SHELVES FOR MASTER TELEPHONE AND BELL SYSTEMS SEE RISER DIAGRAM SHT E-5, & NOTES
   h. 6' SQ. FLUSH OUTLET 4'-0" ABOVE FLOOR FOR LOCK THERMOSTAT. RUN 2" CONDUIT TO CAB. W.P. OUTLET TO WORK IN ATTIC SPACE
   i. OUTLET FOR WELL WING WATER COOLER.
   j. USE 3 - #12 AWG + 1 #12 AWG - 1" CONDUIT/ASSEMBLY FOR BRANCH TO STRIKING CIRCUIT TO BELL SYSTEM. SPARE #12 AWG IN CONDUIT IN ATTIC.
   k. INSTALL 24 GAUGE SHEET METAL BOX AT TOP OF ALL DOOR JAMBS FOR FUTURE DOOR CONTACTS. BOX TO BE FLUSH TO FINISHED SURFACE AND WHEN DOOR IS OPEN. BOX TO BE COVERED WITH PLASTIC COVER PLATE AND WORK WITH DOOR OPEN OR SHUT. SEE DOOR SCHEDULE.
   l. OUTLET FOR TIME TABLE. PROVIDE FLUSH BOX 1½" x 6½" x 4" DEEP AND CONDUIT OF TABLE AS REQUIRED AT 24" A.F.F.
   m. PROVIDE 4" FLUSH OUTLET IN WELL RECESS. BOTTOM OF BOX 12" ABOVE FINISH FLOOR. PROVIDE 4" CONDUIT FROM OUTLET TO ATTIC SPACE ABOVE. RUN 1/0 #6 AWG IN CONDUIT FOR FUTURE USE.
   n. ELEC. OR TIME SWITCH CONTROL FOR ALL EXTERIOR LIGHTING. SEE SPECIFICATIONS FOR SETTINGS AND OPERATION.
   p. RUN 3/0 #1/0 AWG GROUND WIRE FROM SERVICE EQUIPMENT TO ELECTRODE. SIZE AS PER N.E.C. WHERE GROUND WIRE IS RUN IN METAL CONDUIT BOTH ENDS OF CONDUIT SHALL BE GROUNDED.
   q. PROVIDE WIRING FOR DISHWASHER AND ELECTRIC DOMESTIC HEATER - SEE DETAIL ON SHT E-5.
   r. FOR BELL SYSTEM SEE SPECIFICATIONS. ELECTRICAL CONTRACTOR SHALL FURNISH AND INSTALL ALL WIRING AND CONDUIT FOR BELL SYSTEM AS SHOWN ON DRAWINGS AND AS SPECIFIED. ALL WIRING SHALL BE IN CONDUIT. SEE RISER DIAGRAM SHT E-5 & NOTES

SYMBOLS

- ⊕ CEILING WITH JOB CONDUCTORS
- ⊕ WALL BRACKET
- ⊕ WALL BRACKET WITH OUTLET
- ⊕ FLUSH OUTLET
- ⊕ SPECIAL OUTLET
- ⊕ SPECIAL OUTLET AS SPECIFIED
- ⊕ WATER HEATER OUTLET
- ⊕ TERMINAL CABINET
- ⊕ LIGHTING OUTLET
- ⊕ PANEL BOARD
- ⊕ BRANCH CIRCUIT CONCEALED
- ⊕ BRANCH CIRCUIT EXPOSED
- ⊕ BRANCH CIRCUIT UNDERFLOOR
- ⊕ SINGLE POLE SWITCH
- ⊕ DOUBLE POLE SWITCH
- ⊕ 3 WAY SWITCH
- ⊕ 4 WAY SWITCH
- ⊕ DOOR AND PILOT LIGHT
- ⊕ KEY SWITCH

SYMBOLS

- ⊕ CEILING OUTLET
- ⊕ WALL BRACKET
- ⊕ BLANK OUTLET
- ⊕ TEL. OUTLET
- ⊕ JUNCTION BOX
- ⊕ FAN HANGER
- ⊕ EXIT LIGHT
- ⊕ SPECIAL PURPOSE OUTLET AS SPECIFIED
- ⊕ SPECIAL PURPOSE OUTLET
- ⊕ CLOCK OUTLET. FOR SPECIAL SYSTEM UNIT
- ⊕ FIRE ALARM STATION
- ⊕ FIRE ALARM BELL
- ⊕ BELL
- ⊕ LOUDSPEAKER OUTLET
- ⊕ TELEPHONE OUTLET
- ⊕ PUSH BUTTON
- ⊕ BUZZER
- ⊕ DOOR CONTACT
- ⊕ THERMOSTAT
- ⊕ PULL SWITCH
- ⊕ DAYLIGHT SWITCH

FLOOR PLAN

SCALE 1/8" = 1'-0"

ELECTRICAL NOTES:
RUN - 3 ¾" C. FROM EACH FLUSH PANEL TO CEILING SPACE + 2 EMPTY CONDUITS.
SERVICE ENTRANCE CONDUCTORS SIZED UP TO 250 MCM PER PHASE CONDUIT & INSTALLED AS DIRECTED FOR WATER COOLERS, FANS, HEATER, CLOCK, ETC. AS SHOWN

ELECTRICAL - FLOOR PLAN

ELEMENTARY SCHOOL
MARINE CORPS BASE
CAMP LEJEUNE, N.C.
PROJECT NO 63-C-FED-2813

LESLIE N. BONEY ARCHITECT
WILMINGTON NORTH CAROLINA

SHEET 9

N.C. EES NO. 1058
JOB NO. 653
DATE JAN 65
SHT. NO. E 1 OF 5

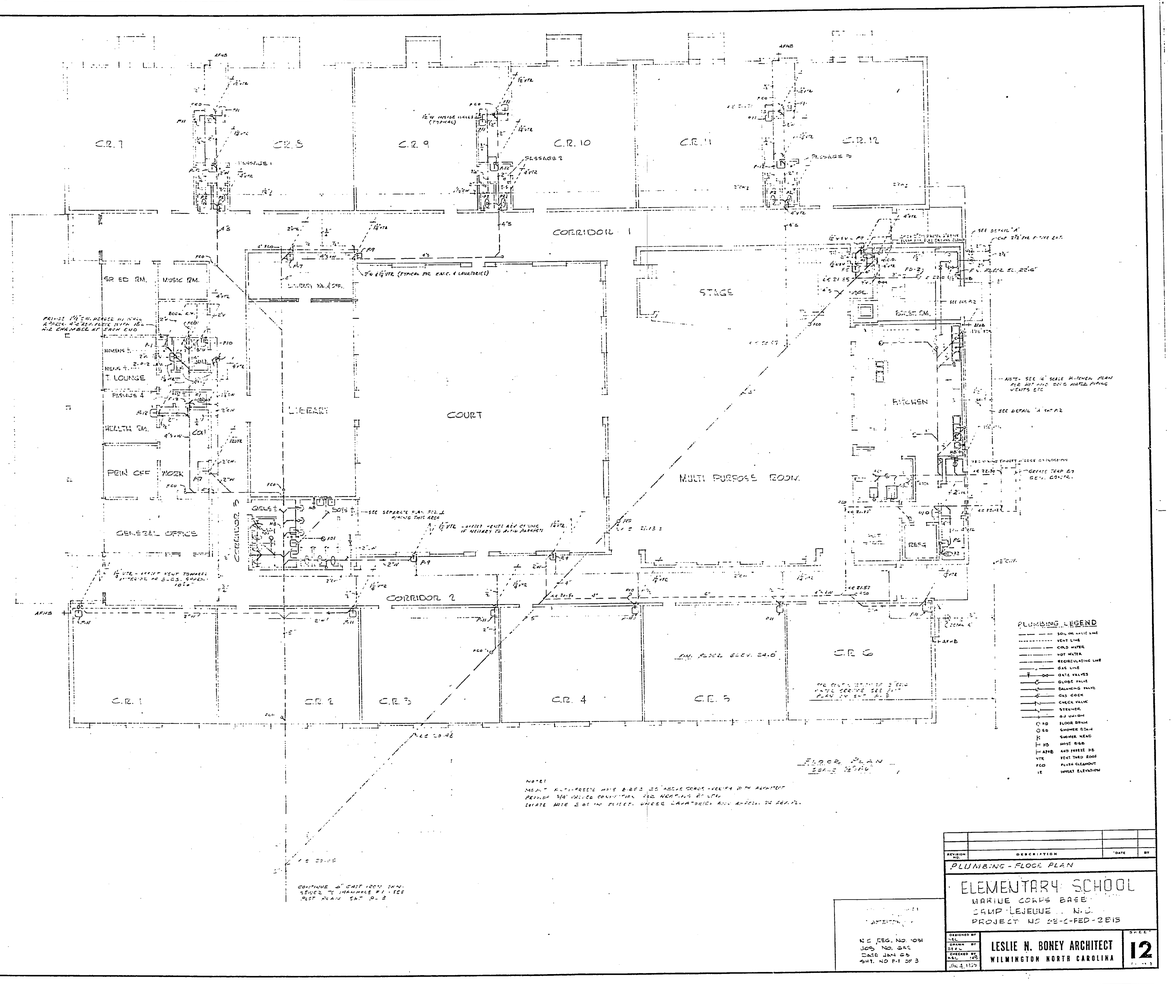
C.R. 7
C.R. 8
C.R. 9
C.R. 10
C.R. 11
C.R. 12
CORRIDOR 1
STAGE
MUSIC RM.
LOUNGE
LIBRARY
COURT
KITCHEN
MULTI PURPOSE ROOM
HEALTH RM.
PERS. SER.
GENERAL OFFICES
CORRIDOR 2
C.R. 1
C.R. 2
C.R. 3
C.R. 4
C.R. 5
C.R. 6
FLOOR PLAN
PLUMBING LEGEND
PLUMBING - FLOOR PLAN
ELEMENTARY SCHOOL
MARINE CORPS BASE
CAMP LEJEUNE, N.C.
PROJECT NO 09-C-FED-2813
LESLIE N. BONEY ARCHITECT
WILMINGTON NORTH CAROLINA
12

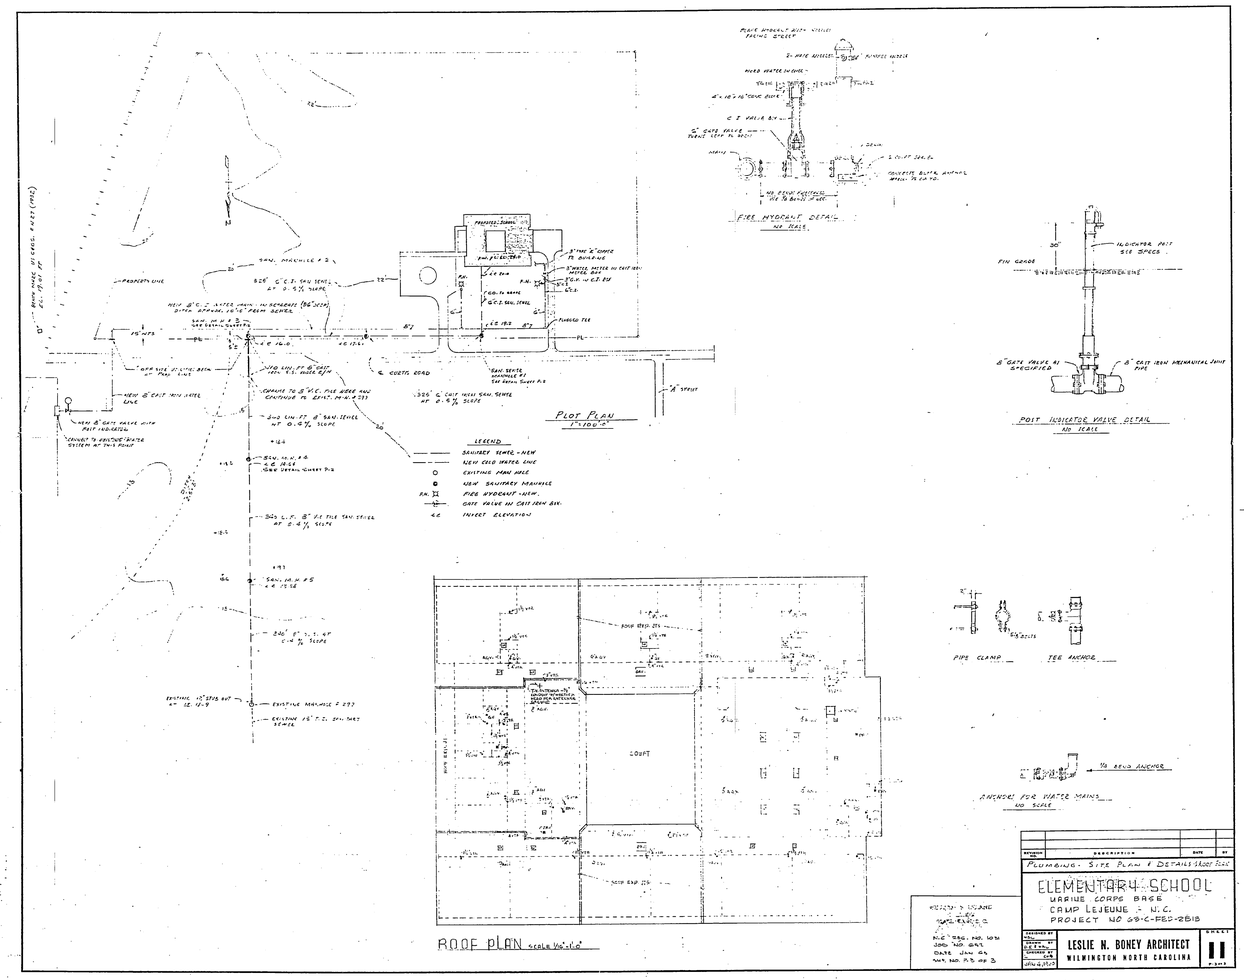
PLOT PLAN
1"=100'-0"
LEGEND
SANITARY SEWER - NEW
NEW COLD WATER LINE
EXISTING MAN HOLE
NEW SANITARY MANHOLE
FIRE HYDRANT - NEW.
GATE VALVE IN CAST IRON BOX
INVERT ELEVATION
FIRE HYDRANT DETAIL
NO SCALE
POST INDICATOR VALVE DETAIL
NO SCALE
ROOF PLAN
PIPE CLAMP
TEE ANCHOR
ANCHORS FOR WATER MAINS
NO SCALE
PLUMBING - SITE PLAN & DETAILS
ELEMENTARY SCHOOL
MARINE CORPS BASE
CAMP LEJEUNE, N.C.
PROJECT NO 09-C-FED-2813
LESLIE N. BONEY ARCHITECT
WILMINGTON NORTH CAROLINA
11

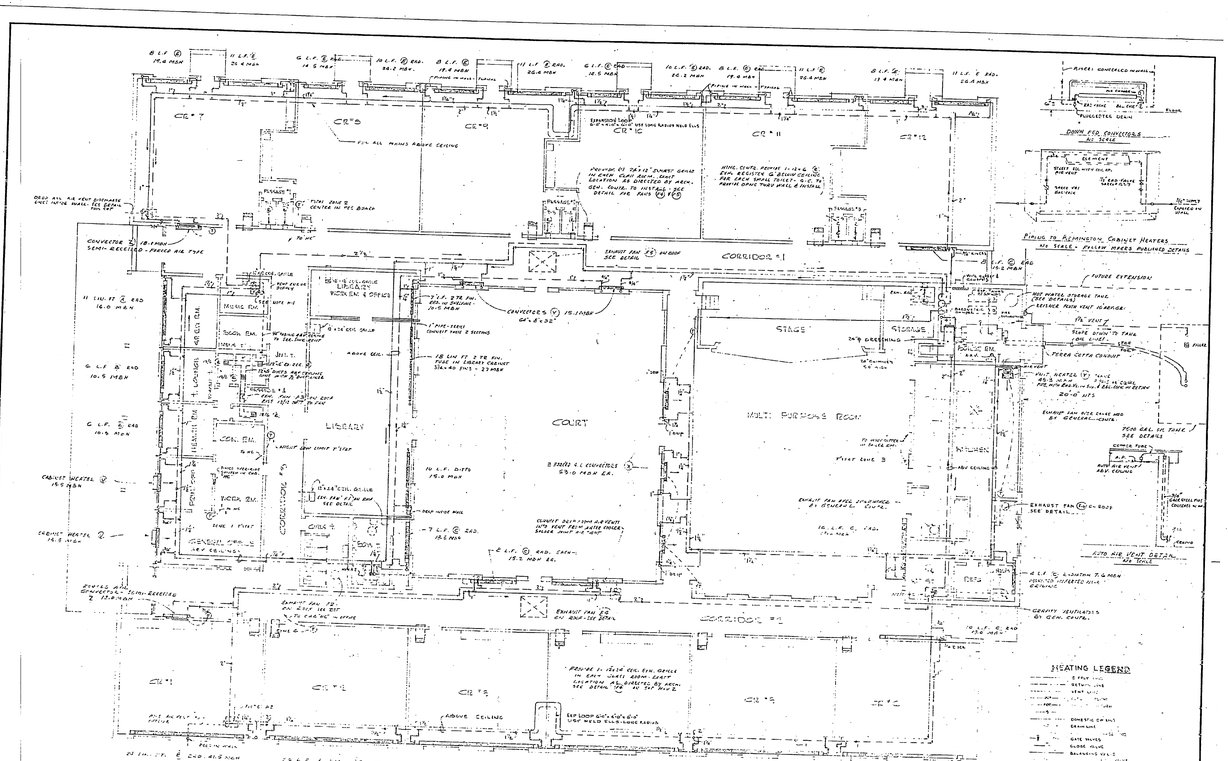
CORRIDOR #1
CORRIDOR #2
LIBRARY
COURT
MULTI-PURPOSE ROOM
STAGE
KITCHEN
CR #7
CR #8
CR #9
CR #10
CR #11
CR #12
CR #1
CR #2
CR #3
CR #4
CR #5
CR #6
HEATING LEGEND
FLOOR PLAN - HEATING & AIR CONDITIONING
ELEMENTARY SCHOOL
MARINE CORPS BASE
CAMP LEJEUNE, N.C.
PROJECT NO. 65-2-FEB-2815
LESLIE N. BONEY ARCHITECT
WILMINGTON NORTH CAROLINA
SHEET 14

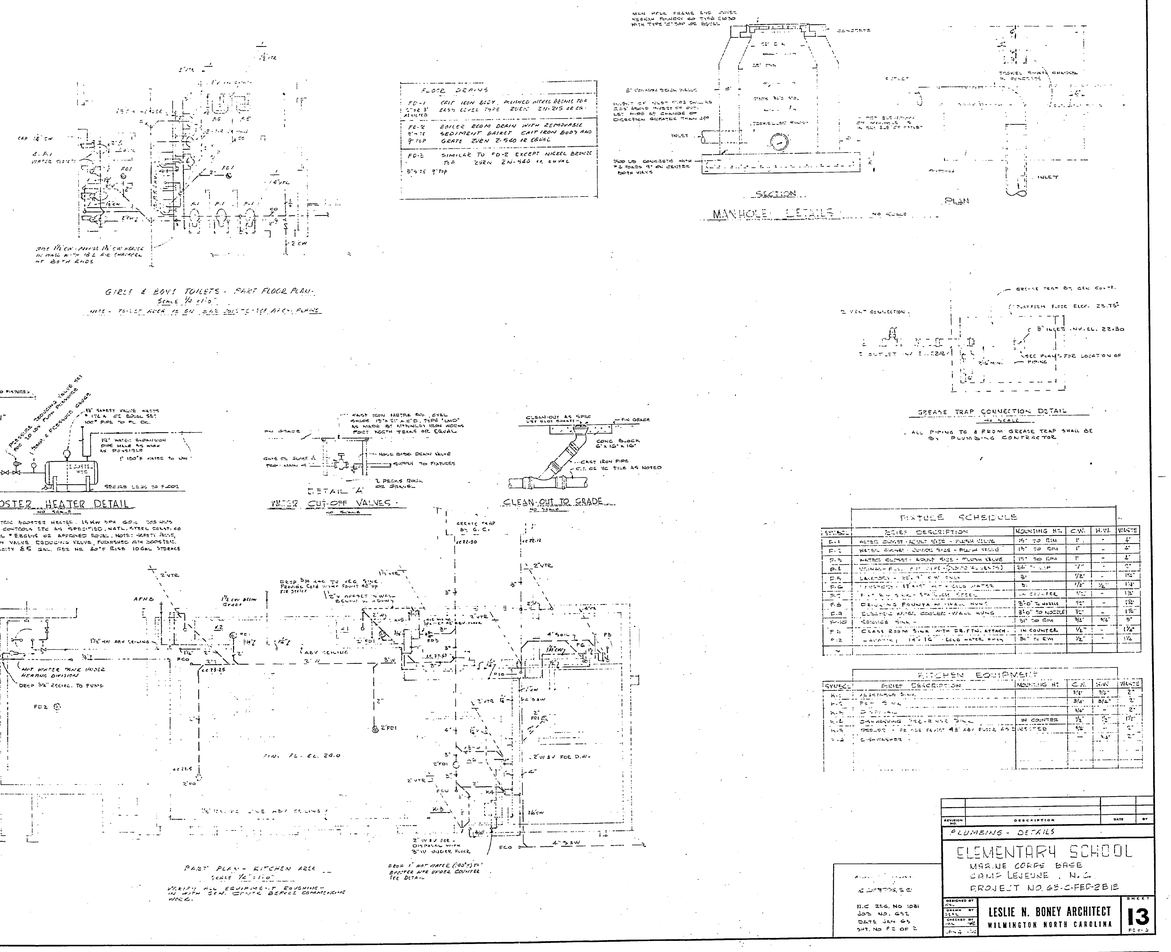
GIRLS & BOYS TOILETS - PART FLOOR PLAN.
MANHOLE DETAILS
SECTION
PLAN
GREASE TRAP CONNECTION DETAIL
BOOSTER HEATER DETAIL
DETAIL 'A'
WATER CUT-OFF VALVES
CLEAN-OUT TO GRADE
PART PLAN - KITCHEN AREA
PLUMBING - DETAILS
ELEMENTARY SCHOOL
MARINE CORPS BASE
CAMP LEJEUNE, N.C.
PROJECT NO 65-2-FEB-2815
LESLIE N. BONEY ARCHITECT
WILMINGTON NORTH CAROLINA
SHEET 13

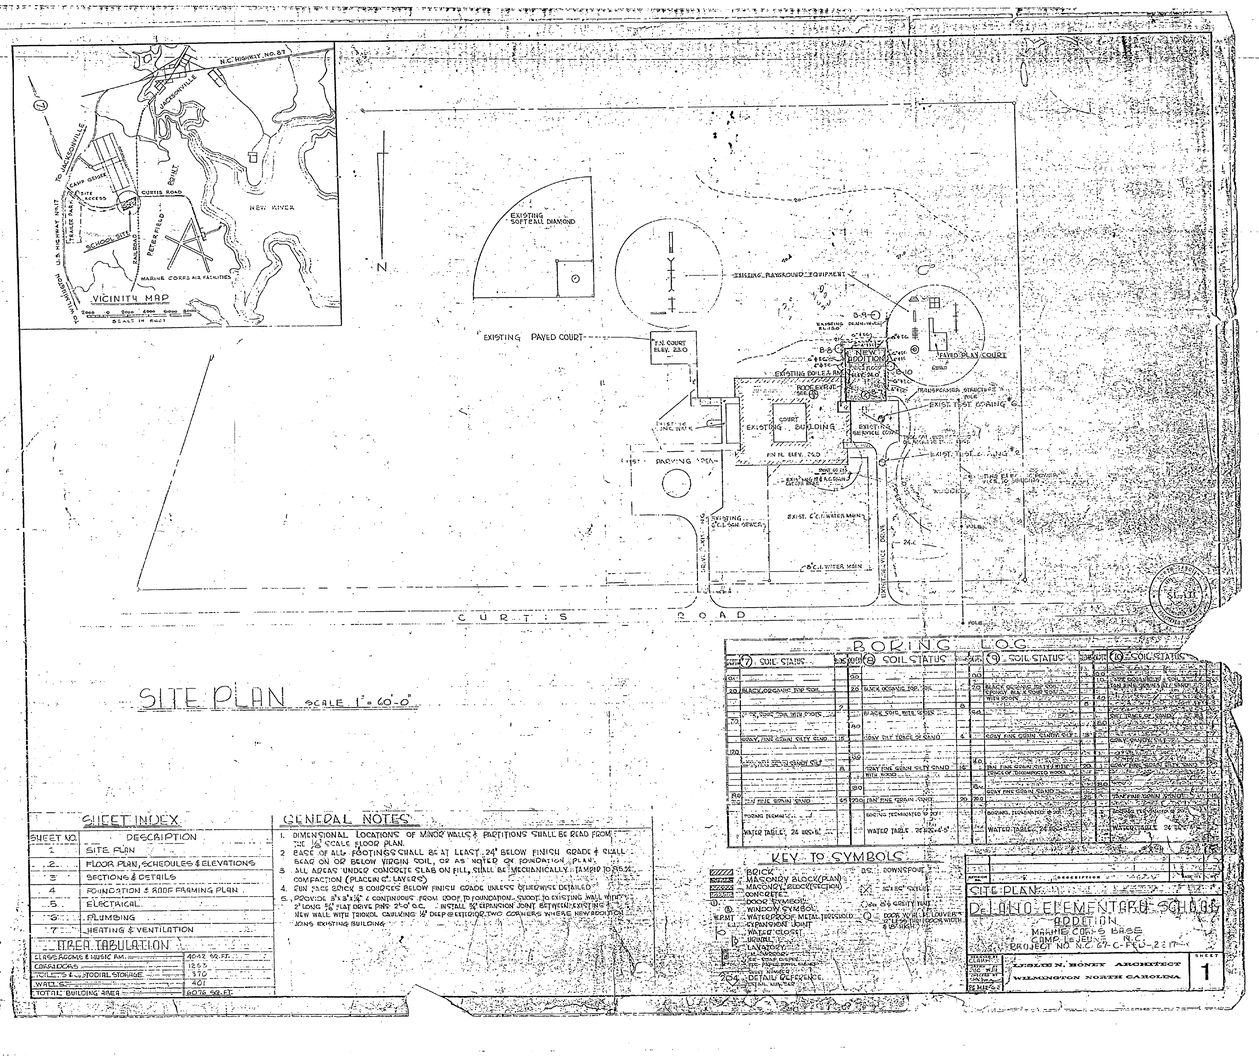

SITE PLAN

SCALE 1" = 60'-0"

BORING LOG

(7) SOIL STATUS	(8) SOIL STATUS	(9) SOIL STATUS	(10) SOIL STATUS
10 MUCK, ORGANIC, SOFT SOIL	20 BLACK ORGANIC SOIL	10 BLACK ORGANIC SOIL	10
70 GRAY FINE SILTY SAND	80 GRAY SILTY FINE TO COARSE SAND	40 GRAY FINE SILTY SAND	40 GRAY FINE SILTY SAND
120 GRAY FINE SILTY CLAY	100	60 GRAY FINE SILTY SAND	60
150 GRAY FINE SILTY SAND	120 GRAY FINE SILTY SAND	80 GRAY FINE SILTY SAND	80 GRAY FINE SILTY SAND
WATER TABLE 24 MAR-66	WATER TABLE 26 MAR-66	WATER TABLE 24 MAR-66	WATER TABLE 24 MAR-66

SHEET INDEX

SHEET NO.	DESCRIPTION
1	SITE PLAN
2	FLOOR PLAN, SCHEDULES & ELEVATIONS
3	SECTIONS & DETAILS
4	FOUNDATION & ROOF FRAMING PLAN
5	ELECTRICAL
6	PLUMBING
7	HEATING & VENTILATION

AREA TABULATION

CLASSROOMS & MUSIC RM.	4042 SQ. FT.
CORRIDORS	1255
TOILETS & JANITORIAL STORAGE	370
WALLS	401
TOTAL BUILDING AREA	6076 SQ. FT.

GENERAL NOTES

1. DIMENSIONAL LOCATIONS OF MINOR WALLS & PARTITIONS SHALL BE READ FROM THE 1/4 SCALE FLOOR PLAN.
2. BASE OF ALL FOOTINGS SHALL BE AT LEAST 24" BELOW FINISH GRADE & SHALL BEAR ON OR BELOW VIRGIN SOIL, OR AS NOTED ON FOUNDATION PLAN.
3. ALL AREAS UNDER CONCRETE SLAB ON FILL SHALL BE MECHANICALLY TAMPED TO 95% COMPACTION (PLACING 6" LAYERS)
5. PROVIDE 8"x 8"x 1/4" x CONTINUOUS ANGLE FROM ROOF TO FOUNDATION. ANCHOR TO EXISTING WALL WITH 5/8" LONG 3/4" FLAT DRIVE PINS 2'-0" O.C. INSTALL 3/4" EXPANSION JOINT BETWEEN EXISTING & NEW WALL WITH TROWEL CAULKING 1/2" DEEP AT EXTERIOR TWO CORNERS WHERE NEW ADDITION JOINS EXISTING BUILDING

KEY TO SYMBOLS

BRICK; MASONRY BLOCK (PLAN); MASONRY BLOCK (ELEVATION); CONCRETE; DOOR SYMBOL; WINDOW SYMBOL; WATER PROOF METAL THRESHOLD; EXPANSION JOINT; WATER CLOSET; URINAL; LAVATORY; DOWNSPOUT; SCALE 3/4" = 1'-0"; DOOR W.C. & CLEVERACK & SPECIFICATIONS; DETAIL REFERENCE

SITE PLAN

DELONO ELEMENTARY SCHOOL
ADDITION
MARINE CORPS BASE
CAMP LEJEUNE, N.C.
PROJECT NO. N.C. 67-C-FED-2813

LESLIE N. BONEY ARCHITECT
WILMINGTON NORTH CAROLINA

SHEET 1

CIRCULATOR SCHEDULE

PUMP # (SYM.)	1	2	3	4	—
G.P.M.	154	17.5	15.4	28.6	
HEAD	18.5	21.5	11.5	21.5	
H.P.	3/4	1	1/6	1	
RPM	1150	1150	1150	1150	
MODEL	405-B	70-3B	174-W	70-5B	
MFG	BELL & GOSSETT OR EQUAL AS NOTED				

BOILER ROOM EQUIPMENT SCHEDULE

BOILER — KEWANEE # 76/150 OR EQUAL — 439 SQ. FT.
HTNG. SURFACE (.333 MBH INT. 537 MBH TABLE)
OIL THERMOST. CAPACITY 250 GAL. SET AT 95° F. SUCT. OIL PUMP MOTOR — GORDON — 1/2 HP — 1725 RPM — 115 V. 1 PH.
HOT WATER STORAGE TANK — 120"D. x 84" HIGH — 720.00 GAL.
EQUAL OR ALL ALUM.
ESTIMATED HEATING LOSS CALCULATIONS 1,427,000 BTUH
ALLOWANCE 4 AIR CHANGES PER HOUR 1,427,000 BTUH

EXHAUST FAN SCHEDULE

FAN NO.	CFM	S.P.	MOTOR H.P.	MOTOR R.P.M.	FAN R.P.M.	TIP SPEED	DRIVE	MFRS. & TYPE
F-1	315	1/8	1/8	1140	1150	1075	1/4" V-BELT	GREENES DZS-9A
F-2	315	1/8	1/8	1140	1150	1075	1/4" V-BELT	SAME
F-3	510	1/8	1/8	1140	1150	1611	1/4" V-BELT	GREENES DZ2-10A
F-4	1455	1/8	1/8	1140	1150	1611	1/4" V-BELT	GREENES LS-50B
F-5	4455	1/8	1/2	1140	1150	1611	1/4" V-BELT	GREENES LS-53A
F-6	810	1/8	1/8	1140	1150	1611	1/4" V-BELT	GREENES DZ2-12A

SPECIAL HEATING UNITS

(2) CABINET HEATER — MODEL K-15 (490 BTUH, FROM 180 GAL/H @ 215° F) — REMINGTON N.C. 28, COMPLETE AS SHOWN
(4) FORCED AIR CONVECTOR (FROM 180 GAL/H @ 215° F) SEMI-RECESSED 3 SPEED FAN CONTROL — RAM 1 SPEED SWITCH — RECESS BOTTOM SMALL TO FIT FAN SWITCH & CONTROLS
(5) CONVECTOR HEATING PER MANUFACTURER'S RECOMMENDATIONS FOR 180° F. WATER
(6) CONVECTOR — HEATING PER MANUFACTURER'S RECOMMENDATIONS FOR 180° F. WATER
(7) FORCED AIR CONVECTOR, TRANE F-100-B SEMI-RECESSED 3 SPEED SWITCH (FROM 870 GAL/H @ 215° F) — HEATING OUTLET, COOLER INLET.



HEATING & VENTILATING - DETAILS

ELEMENTARY SCHOOL
MARINE CORPS BASE
CAMP LEJEUNE, N.C.
PROJECT NO. 05-C-FED-2813

LESLIE N. BONEY ARCHITECT
WILMINGTON NORTH CAROLINA

SHEET 15

N.C. GEN. NO. 1051
SQ. NO. 641
STR. JAN 69
NO. KEY 2 of 2

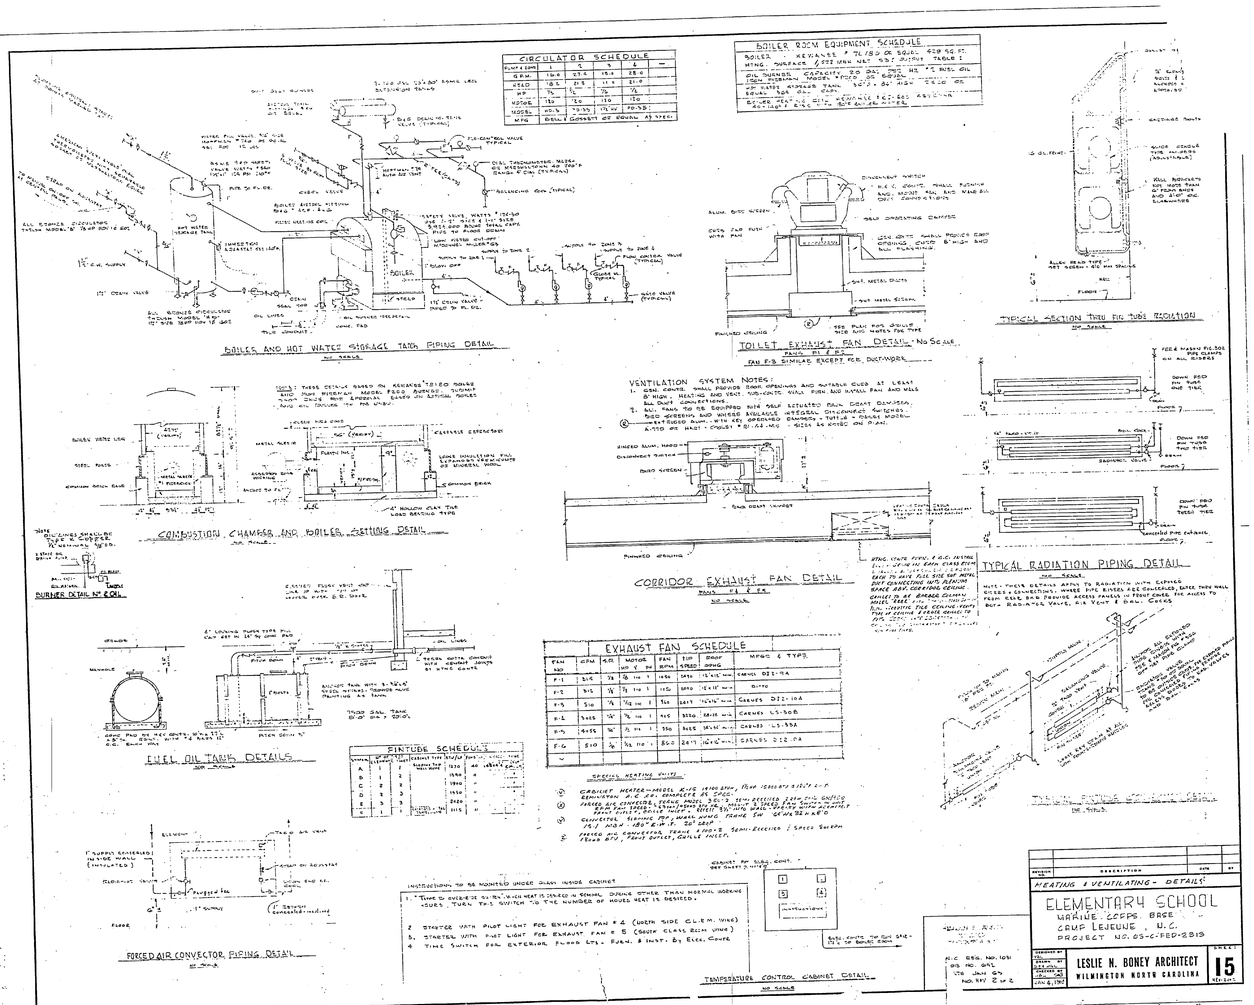

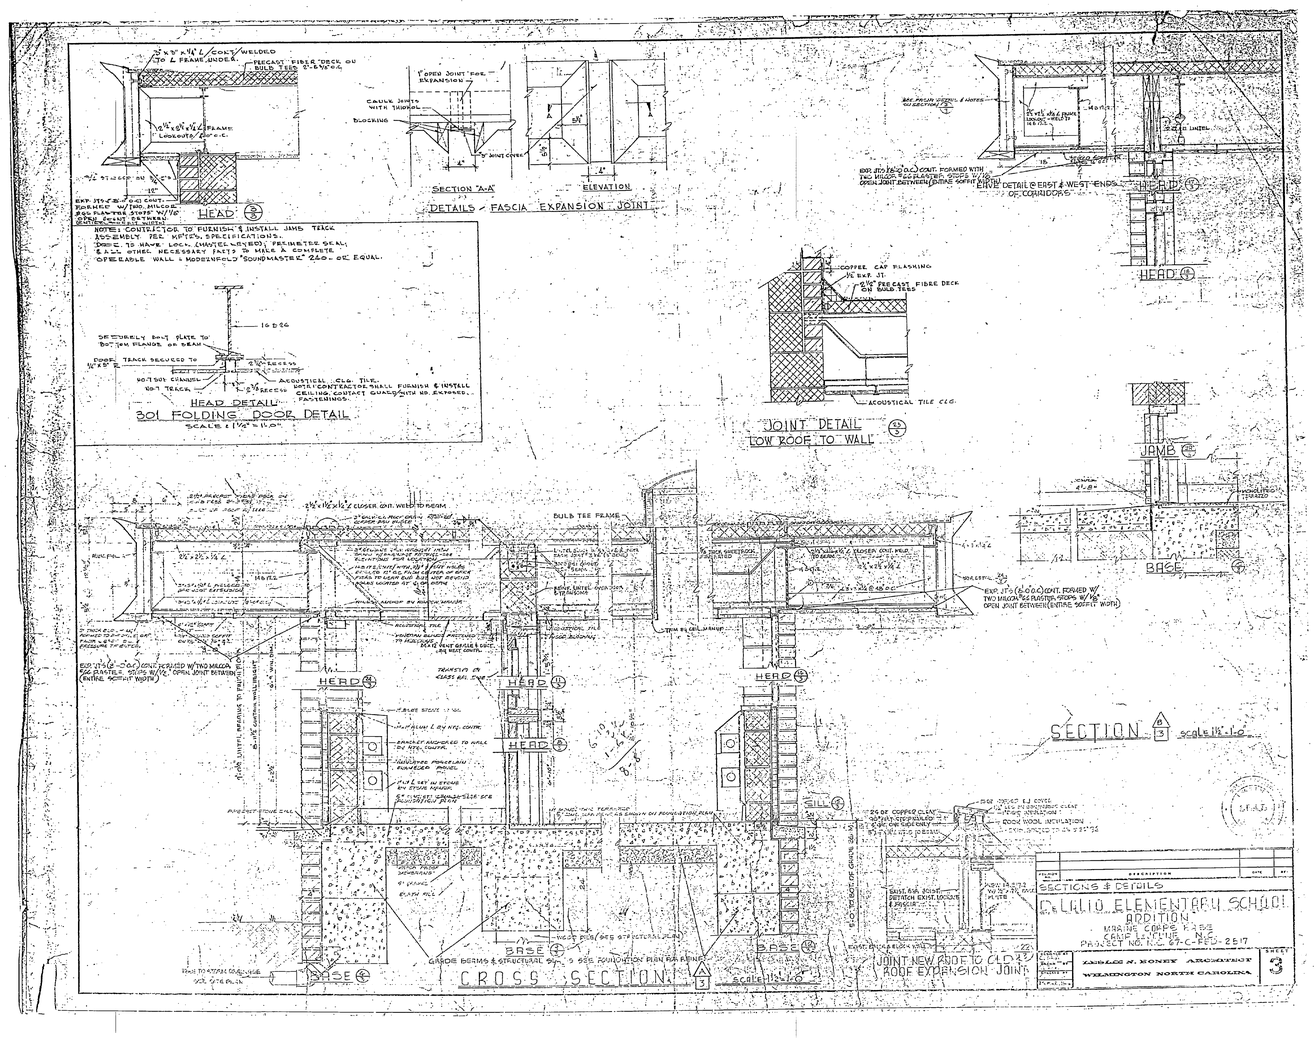
DETAILS - FASCIA EXPANSION JOINT
SECTION "A-A"
ELEVATION
HEAD
JAMB
BASE
SILL
HEAD DETAIL
301 FOLDING DOOR DETAIL
SCALE: 1 1/2" = 1'-0"
JOINT DETAIL
LOW ROOF TO WALL
SECTION
CROSS SECTION
JOINT NEW ROOF TO OLD ROOF EXPANSION JOINT
SECTIONS & DETAILS
DeLALIO ELEMENTARY SCHOOL
ADDITION
MARINE CORPS BASE
CAMP LEJEUNE, N.C.
PROJECT NO. NC-57-C-REG-2517
LEGLE & MONEY ARCHITECT
WILMINGTON NORTH CAROLINA
SHEET 3 OF 3

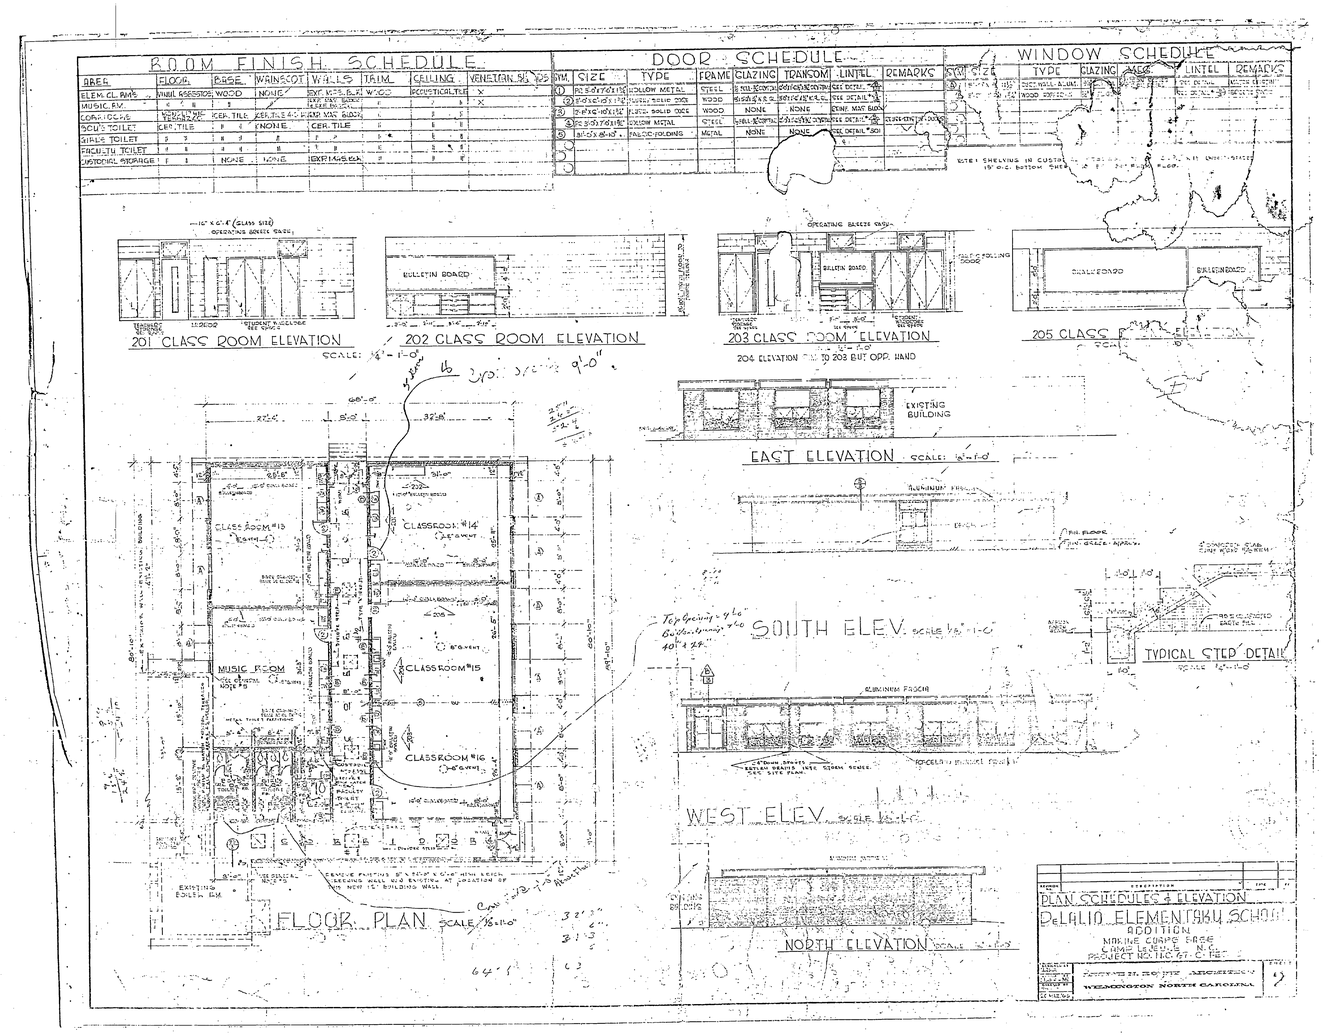
ROOM FINISH SCHEDULE
DOOR SCHEDULE
WINDOW SCHEDULE
201 CLASS ROOM ELEVATION
202 CLASS ROOM ELEVATION
203 CLASS ROOM ELEVATION
205 CLASS ROOM ELEVATION
EAST ELEVATION
SOUTH ELEV.
WEST ELEV.
NORTH ELEVATION
TYPICAL STEP DETAIL
FLOOR PLAN
CLASSROOM #13
CLASSROOM #14
CLASSROOM #15
CLASSROOM #16
MUSIC ROOM
PLAN SCHEDULES & ELEVATION
DeLALIO ELEMENTARY SCHOOL
ADDITION
MARINE CORPS BASE
CAMP LEJEUNE, N.C.
PROJECT NO. NC-57-C-REG-2517
LEGLE & MONEY ARCHITECT
WILMINGTON NORTH CAROLINA
SHEET 2 OF 3

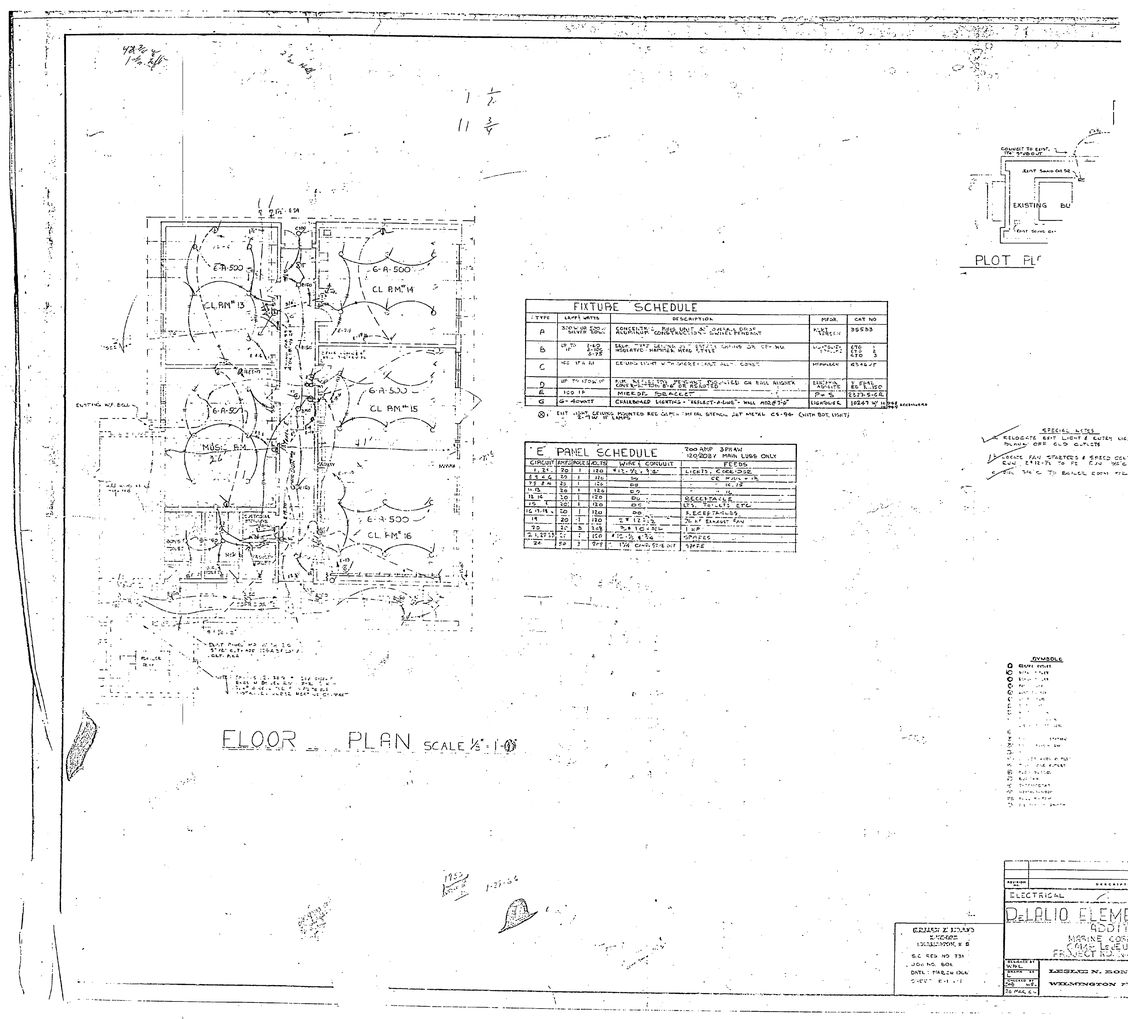
G-A-500
CL RM# 13
CL RM# 14
CL RM# 15
CL RM# 16
MOBILE #14
EXISTING M/F BDG.
EXISTING BUILDING
EXIST. SAND OIL SEP.
EXIST. SEWER LINE
EXISTING BU
PLOT PL
FIXTURE SCHEDULE
TYPE
LAMP WATTS
DESCRIPTION
MFGR.
CAT NO
DESCRIPTION
MFGR.
CAT NO
'E' PANEL SCHEDULE
700 AMP 3PHAW
120/208Y MAIN LUGS ONLY
CIRCUIT
AMP
POLE
WIRE & CONDUIT
FEEDS
SPECIAL NOTES
1. RELOCATE EXIT LIGHT & OUTER LIGHT TO END OF NEW CORRIDOR. REMOVE OPP. EXIT LIGHT.
2. CREATE NEW STARTERS & SPEED CONTROL SWS IN NEW CLASSROOMS. CONNECT TO PE CKT NOS 6 & 12 IN PANEL 'E'.
3. PROVIDE 3/4" C. TO ROOF FOR ROOF MOUNTED ANTENNA. COORDINATE WITH ROOFING CONTRACTOR.
SYMBOLS
ELECTRICAL
DELALIO ELEMENTARY SCHOOL
ADDITION
MARINE CORPS BASE
CAMP LEJEUNE N.C.
PROJECT NO. N.C. 67-C-FED-2817
LESLIE N. BONEY ARCHITECT
WILMINGTON NORTH CAROLINA
SHEET 5
FLOOR PLAN SCALE 1/8" = 1'-0"

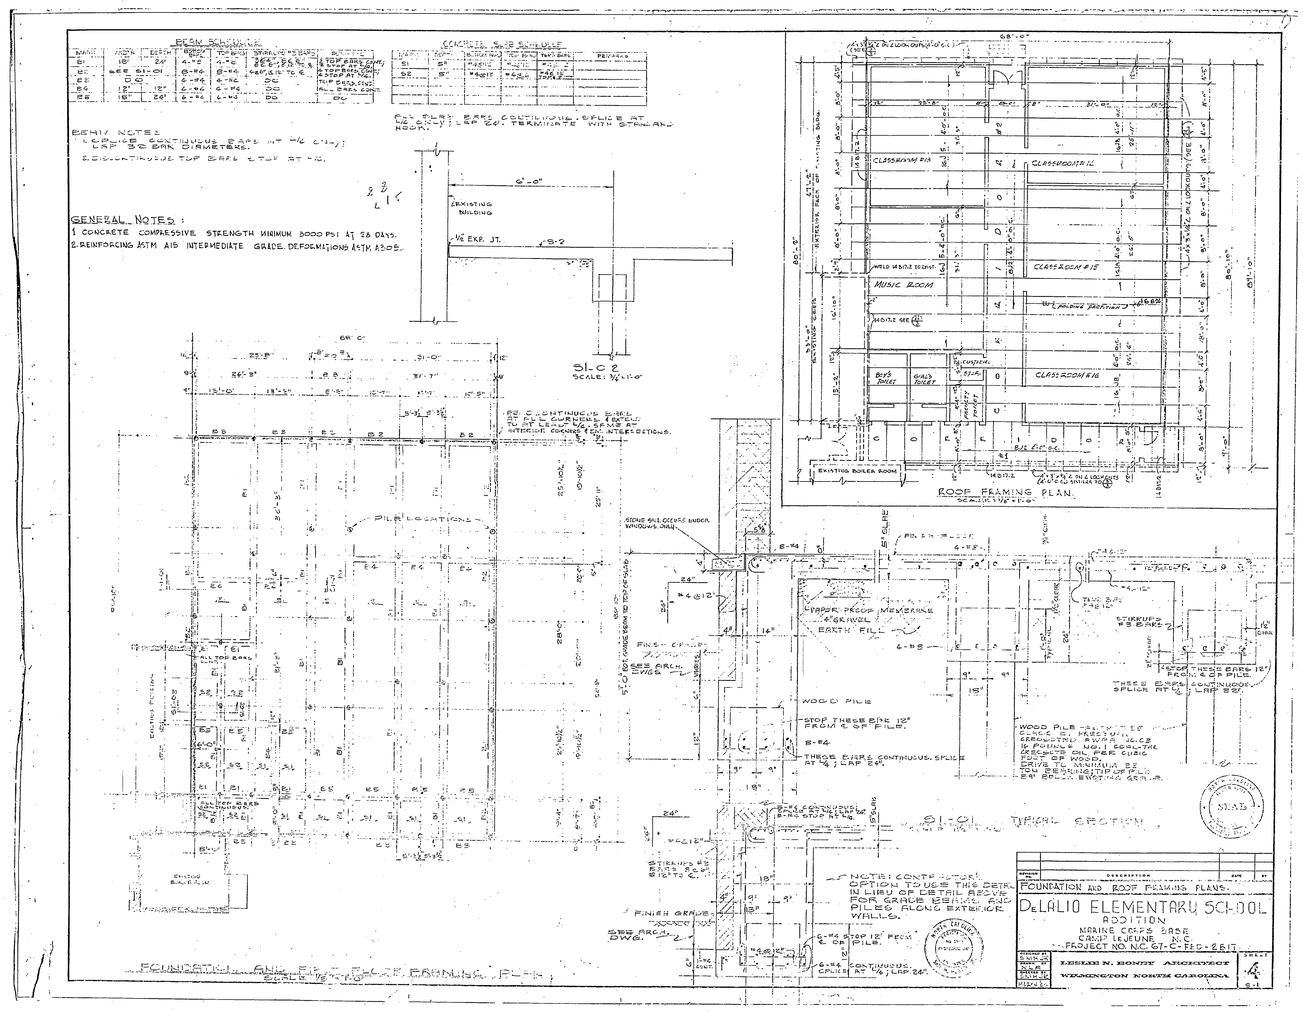
PIER SCHEDULE
CONCRETE CAP SCHEDULE
GENERAL NOTES:
1 CONCRETE COMPRESSIVE STRENGTH MINIMUM 3000 PSI AT 28 DAYS.
2. REINFORCING ASTM A15 INTERMEDIATE GRADE. DEFORMATIONS ASTM A305.
EXISTING BUILDING
1/2 EXP. JT.
S1-C 2
SCALE: 1/4"=1'-0"
CLASSROOM #15
CLASSROOM #16
MUSIC ROOM
EXISTING BOILER ROOM
ROOF FRAMING PLAN
SCALE: 1/8"=1'-0"
PILE LOCATIONS
EARTH FILL
WOOD PILE
STOP THESE BARS 12" FROM C OF PILE.
THESE BARS CONTINUOUS SPLICE AT 1/4 L LAP 24".
STIRRUPS #3 @ PIER 2
WOOD PILE NOTES
S1-C1 TYPICAL SECTION
FOUNDATION AND ROOF FRAMING PLANS
DELALIO ELEMENTARY SCHOOL
ADDITION
MARINE CORPS BASE
CAMP LEJEUNE N.C.
PROJECT NO. N.C. 67-C-FED-2817
LESLIE N. BONEY ARCHITECT
WILMINGTON NORTH CAROLINA
SHEET 4

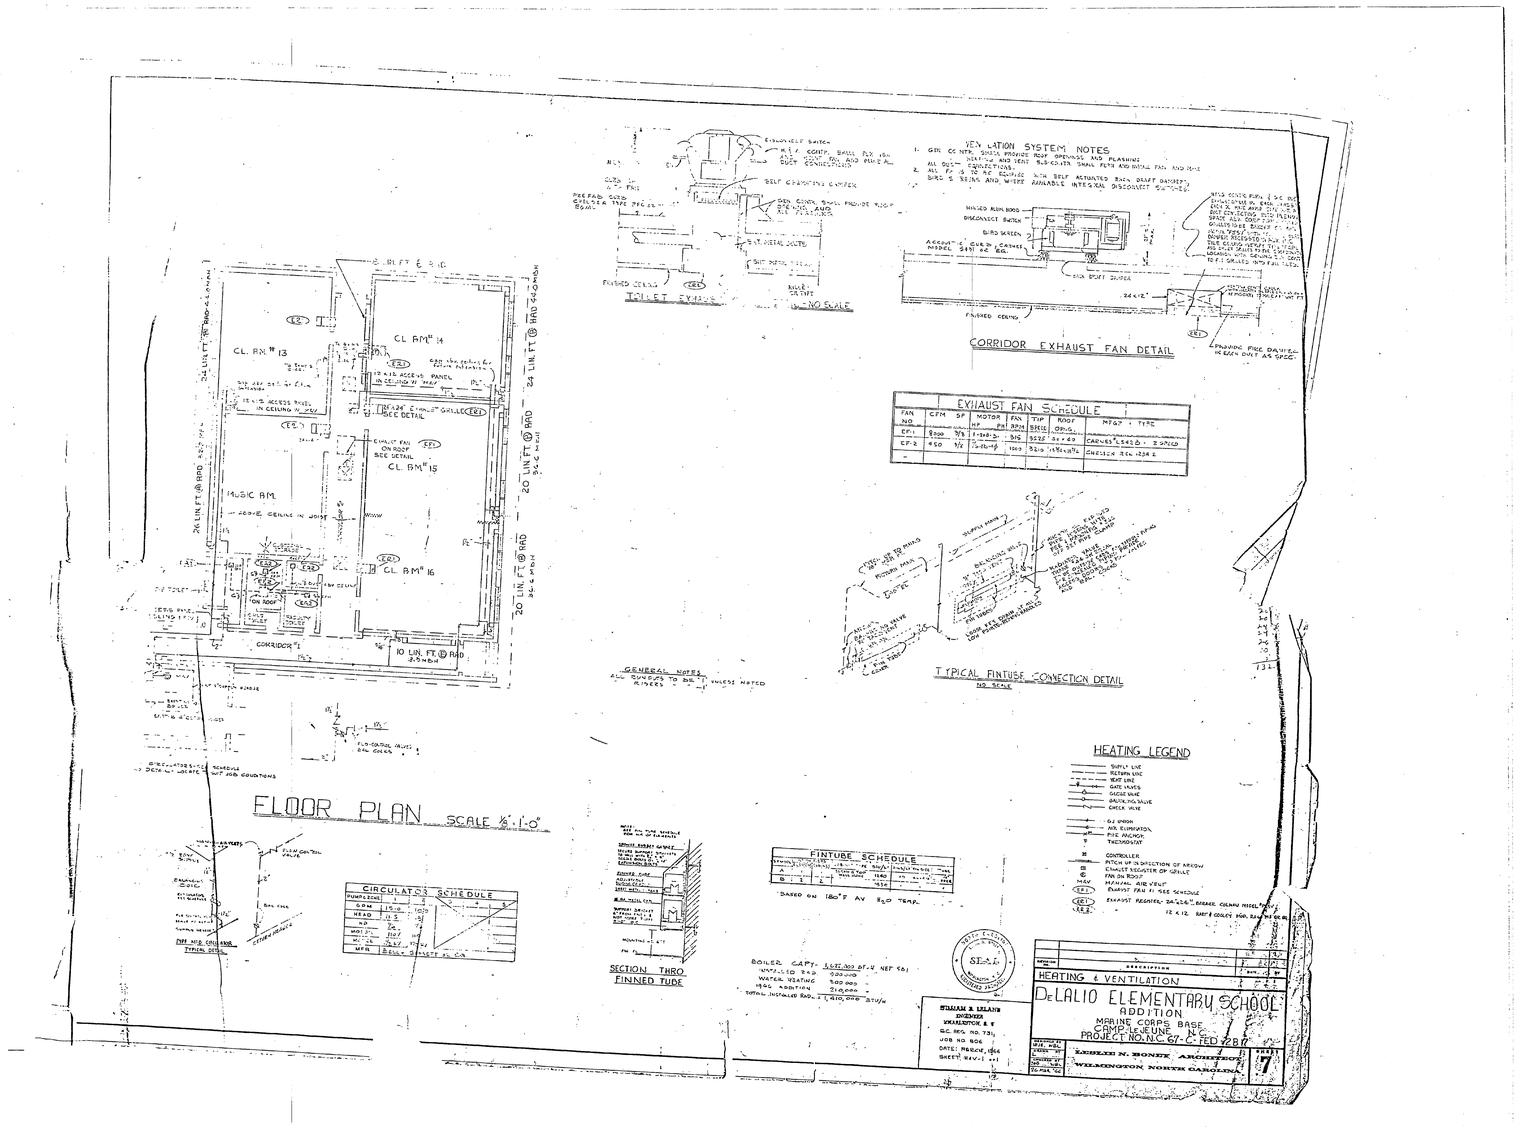
VENTILATION SYSTEM NOTES
1. GEN CONTR. SHALL PROVIDE ROOF OPENINGS AND FLASHING
2. ALL EF-1 TO BE EQUIPPED WITH BELT ACTUATED BACK DRAFT DAMPERS
TOILET EXHAUST
CORRIDOR EXHAUST FAN DETAIL
EXHAUST FAN SCHEDULE
TYPICAL FINTUBE CONNECTION DETAIL
GENERAL NOTES
HEATING LEGEND
FLOOR PLAN SCALE 1/8"-1'-0"
CIRCULATOR SCHEDULE
FINTUBE SCHEDULE
SECTION THRO FINNED TUBE
HEATING & VENTILATION
DeLALIO ELEMENTARY SCHOOL
ADDITION
MARINE CORPS BASE
CAMP LEJEUNE, N.C.
PROJECT NO. N.C. 67-C-FED-2817
WILMINGTON NORTH CAROLINA

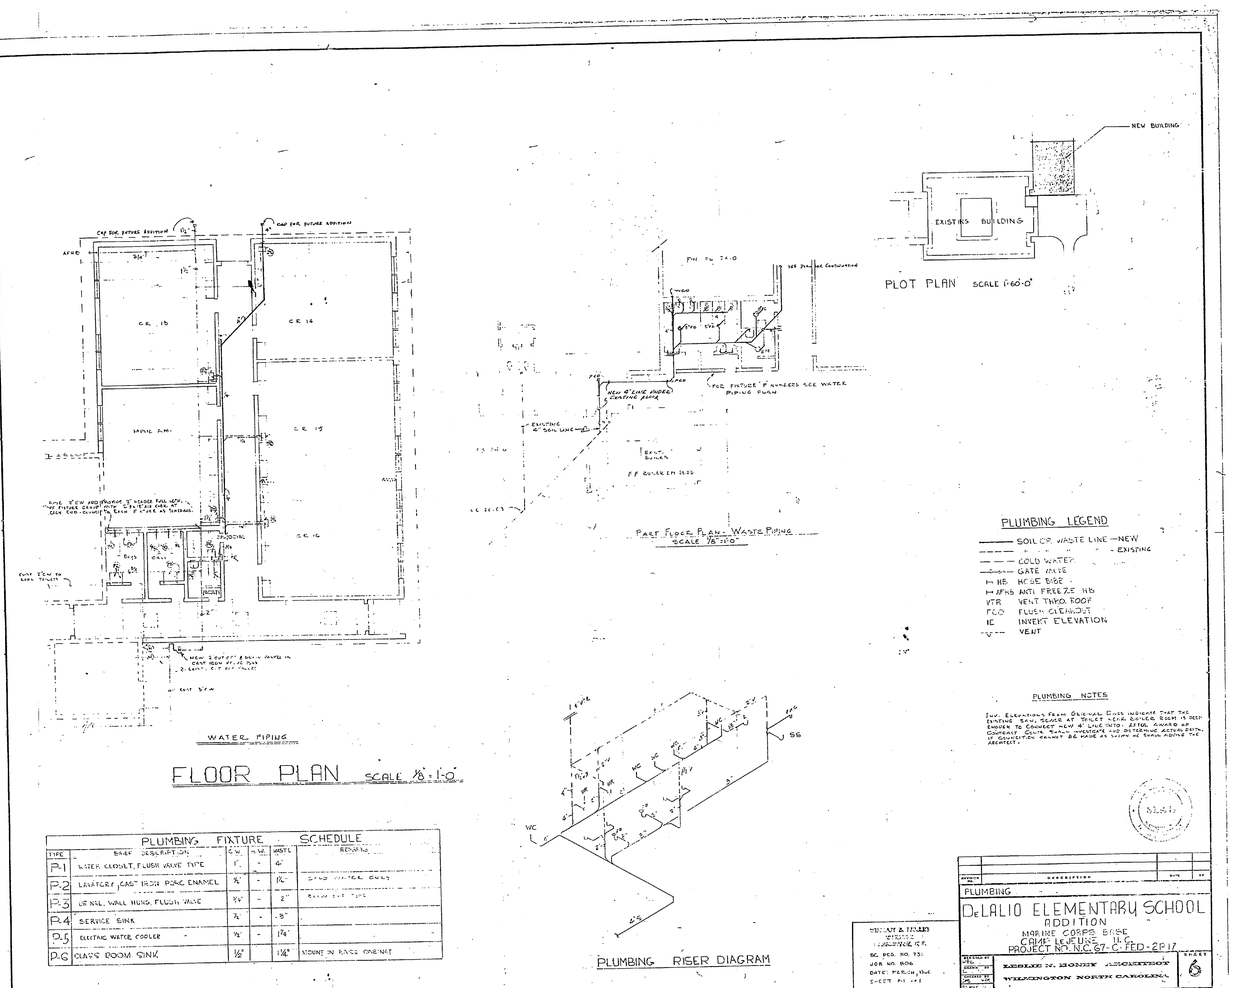
WATER PIPING
FLOOR PLAN SCALE 1/8"-1'-0"
PLUMBING FIXTURE SCHEDULE
PLOT PLAN SCALE 1"=60'-0"
PART FLOOR PLAN - WASTE PIPING SCALE 1/8"=1'0"
PLUMBING RISER DIAGRAM
PLUMBING LEGEND
PLUMBING NOTES
PLUMBING
DeLALIO ELEMENTARY SCHOOL
ADDITION
MARINE CORPS BASE
CAMP LEJEUNE, N.C.
PROJECT NO. N.C. 67-C-FED-2817
WILMINGTON NORTH CAROLINA

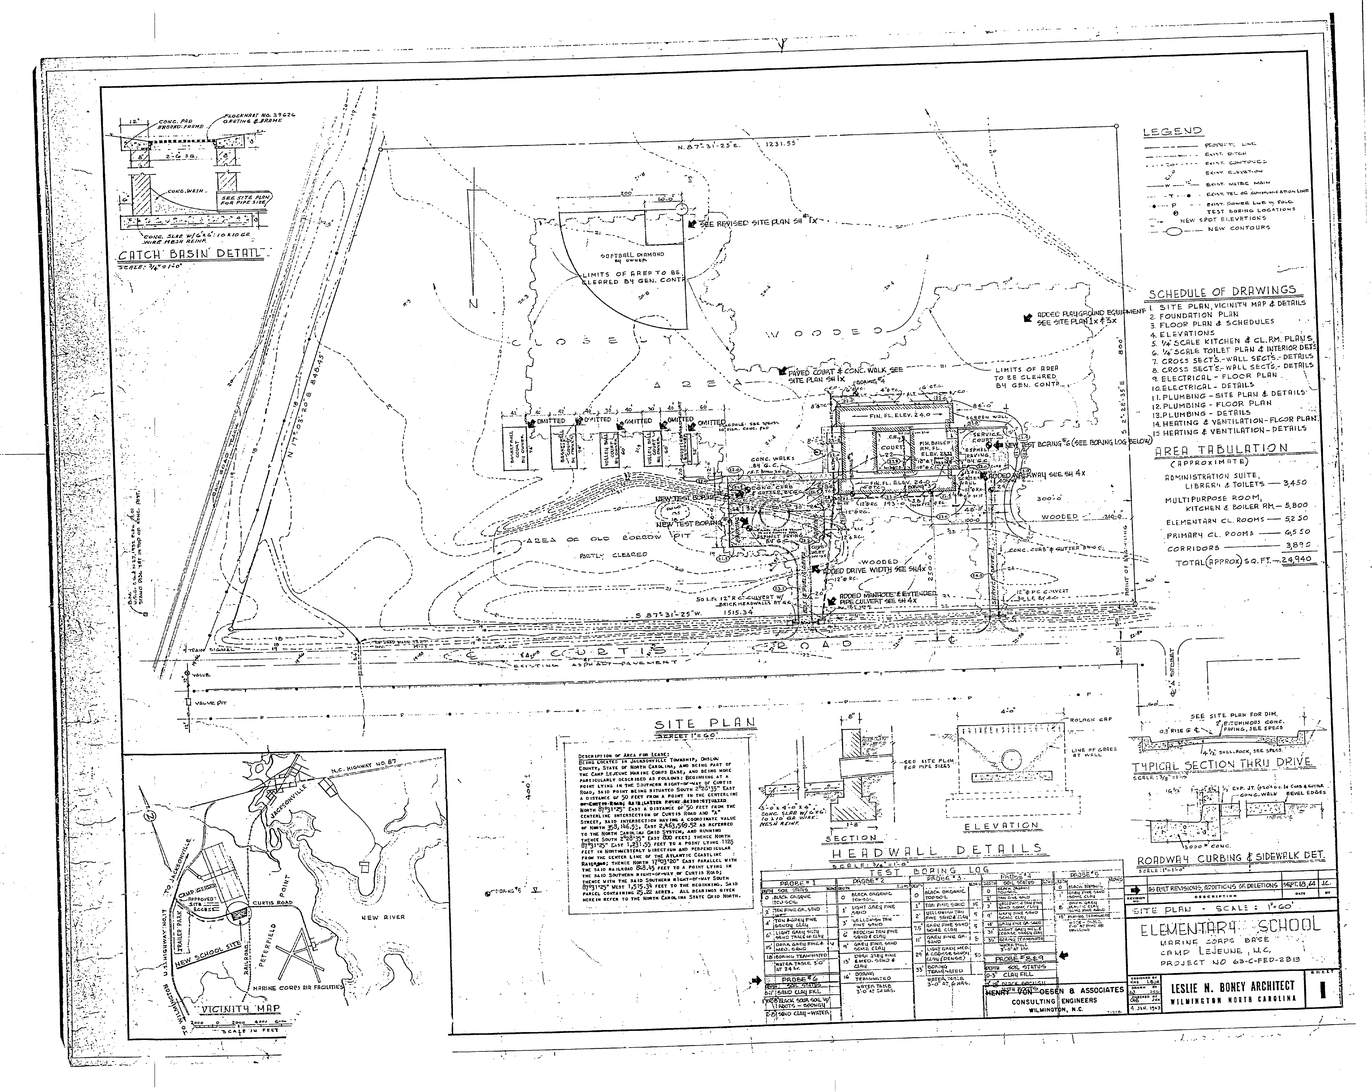
CATCH BASIN DETAIL
SCALE: 3/4"=1'-0"
LEGEND
SCHEDULE OF DRAWINGS
1 SITE PLAN, VICINITY MAP & DETAILS
2 FOUNDATION PLAN
3 FLOOR PLAN & SCHEDULES
4 ELEVATIONS
5 1/4" SCALE KITCHEN & CL. RM. PLANS
6 1/4" SCALE TOILET PLAN & INTERIOR DETS
7 CROSS SECTS.-WALL SECTS.-DETAILS
8 CROSS SECTS.-WALL SECTS.-DETAILS
9 ELECTRICAL - FLOOR PLAN
10 ELECTRICAL - DETAILS
11 PLUMBING - SITE PLAN & DETAILS
12 PLUMBING - FLOOR PLAN
13 PLUMBING - DETAILS
14 HEATING & VENTILATION - FLOOR PLAN
15 HEATING & VENTILATION - DETAILS
AREA TABULATION
(APPROXIMATE)
ADMINISTRATION SUITE, LIBRARY & TOILETS — 3,450
MULTIPURPOSE ROOM, KITCHEN & BOILER RM — 5,800
ELEMENTARY CL. ROOMS — 5250
PRIMARY CL. ROOMS — 6550
CORRIDORS — 3,890
TOTAL (APPROX) SQ. FT. — 24,940
SITE PLAN
SCALE 1"=60'
VICINITY MAP
SCALE IN FEET
TYPICAL SECTION THRU DRIVE
ROADWAY CURBING & SIDEWALK DET.
SECTION
ELEVATION
HEADWALL DETAILS
TEST BORING LOG
CURTIS ROAD
NEW SCHOOL SITE
NEW RIVER
MARINE CORPS AIR FACILITIES
SOFTBALL DIAMOND BY OWNER
LIMITS OF AREA TO BE CLEARED BY GEN. CONTR.
AREA OF OLD BORROW PIT PARTLY CLEARED
WOODED
SEE REVISED SITE PLAN 5B "X
SEE SITE PLAN 1x & 5x
PAVED COURT & CONC. WALK SEE SITE PLAN 5H "X
SEE TEST BORING "B" (SEE BORING LOG BELOW)
WOODED RUNWAY SEE SH 4x
WOODED DRIVE WIDTH SEE SH 4x
ROADWAY CURBING & SIDEWALK DET. SEE SH 4x
SEE SITE PLAN FOR DIM. & DOWNSPOUT CONC. FITTING, SEE SPECS
SEE SITE PLAN FOR PIPE SIZES
ROADWAY GRP
LINE OF CURBS BY WIDTH
SEE SHEET 4x FOR ADDITIONAL DETAILS
HENRY VON OESEN & ASSOCIATES
CONSULTING ENGINEERS
WILMINGTON, N.C.
SITE PLAN · SCALE : 1"=60'
ELEMENTARY SCHOOL
MARINE CORPS BASE
CAMP LEJEUNE, N.C.
PROJECT NO 63-C-FED-2813
LESLIE N. BONEY ARCHITECT
WILMINGTON NORTH CAROLINA
1

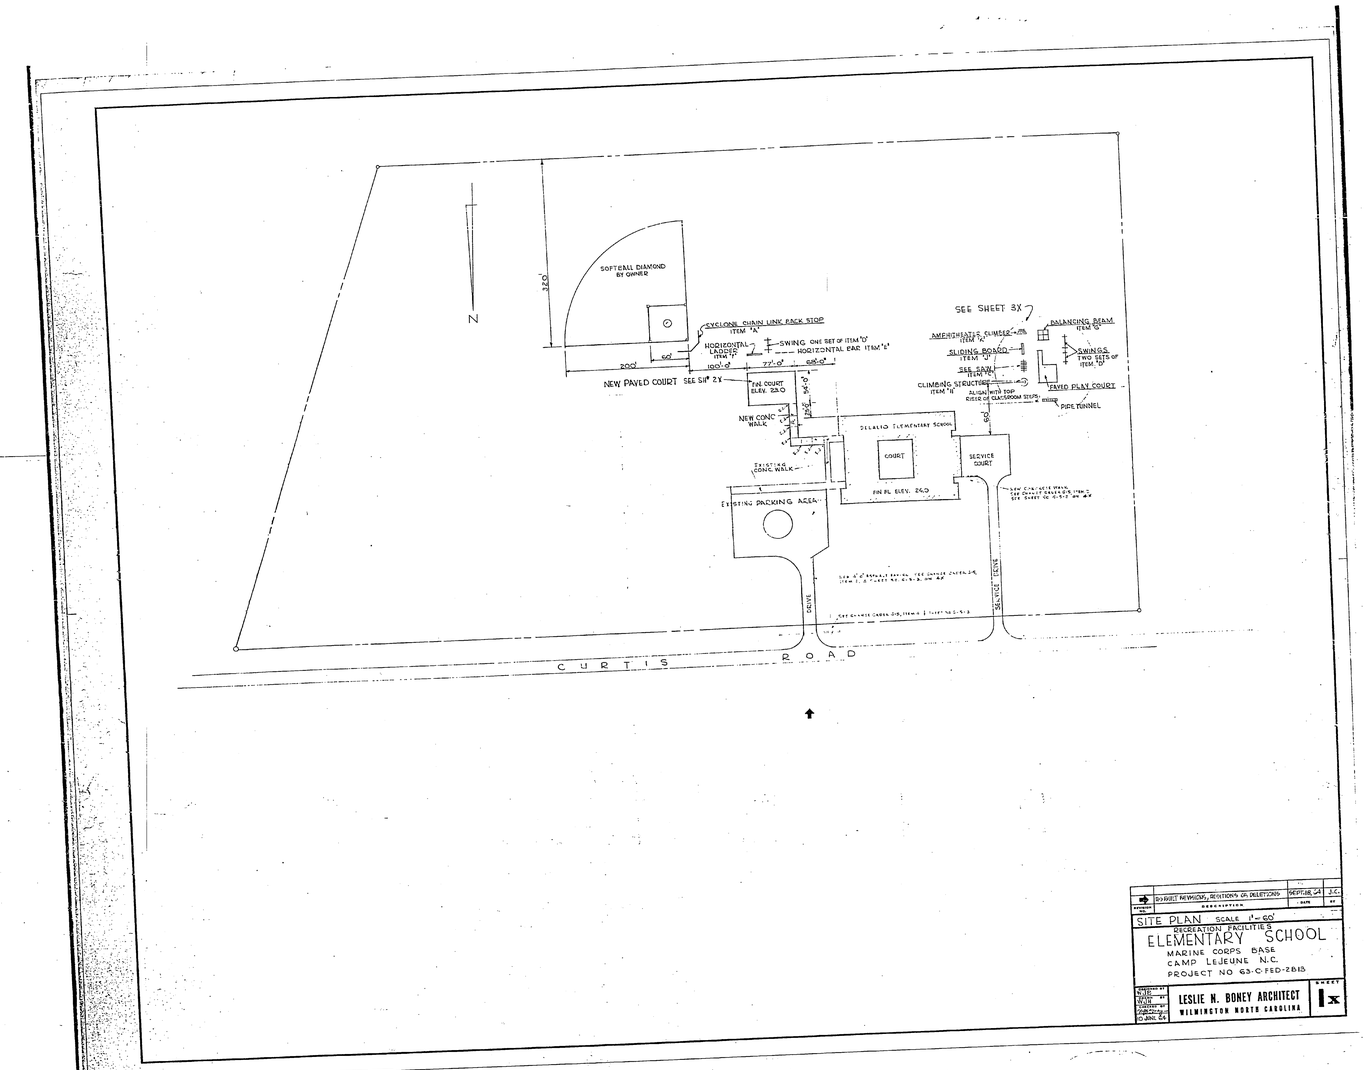
SOFTBALL DIAMOND BY OWNER
CYCLONE CHAIN LINK BACK STOP ITEM "A"
HORIZONTAL LADDER ITEM "F"
SWING ONE SET OF ITEM "D" HORIZONTAL BAR ITEM "E"
NEW PAVED COURT SEE SH 2X
TAN COURT ELEV. 23.0
NEW CONC WALK
EXISTING CONC WALK
COURT
SERVICE COURT
FIN FL ELEV. 24.0
EXISTING PARKING AREA
AMERICHAIR 5 CLIMBER ITEM "C"
SLIDING BOARD ITEM "J"
SEE SAW ITEM "K"
CLIMBING STRUCTURE ITEM "H"
BALANCING BEAM ITEM "G"
SWINGS TWO SETS OF ITEM "D"
PAVED PLAY COURT
PIPE TUNNEL
ALSO WITH TOP RUNG OF CLASSROOM STEPS
CURTIS ROAD
SITE PLAN · SCALE 1"=60'
RECREATION FACILITIES
ELEMENTARY SCHOOL
MARINE CORPS BASE
CAMP LEJEUNE N.C.
PROJECT NO 63-C-FED-2813
LESLIE N. BONEY ARCHITECT
WILMINGTON NORTH CAROLINA
1x

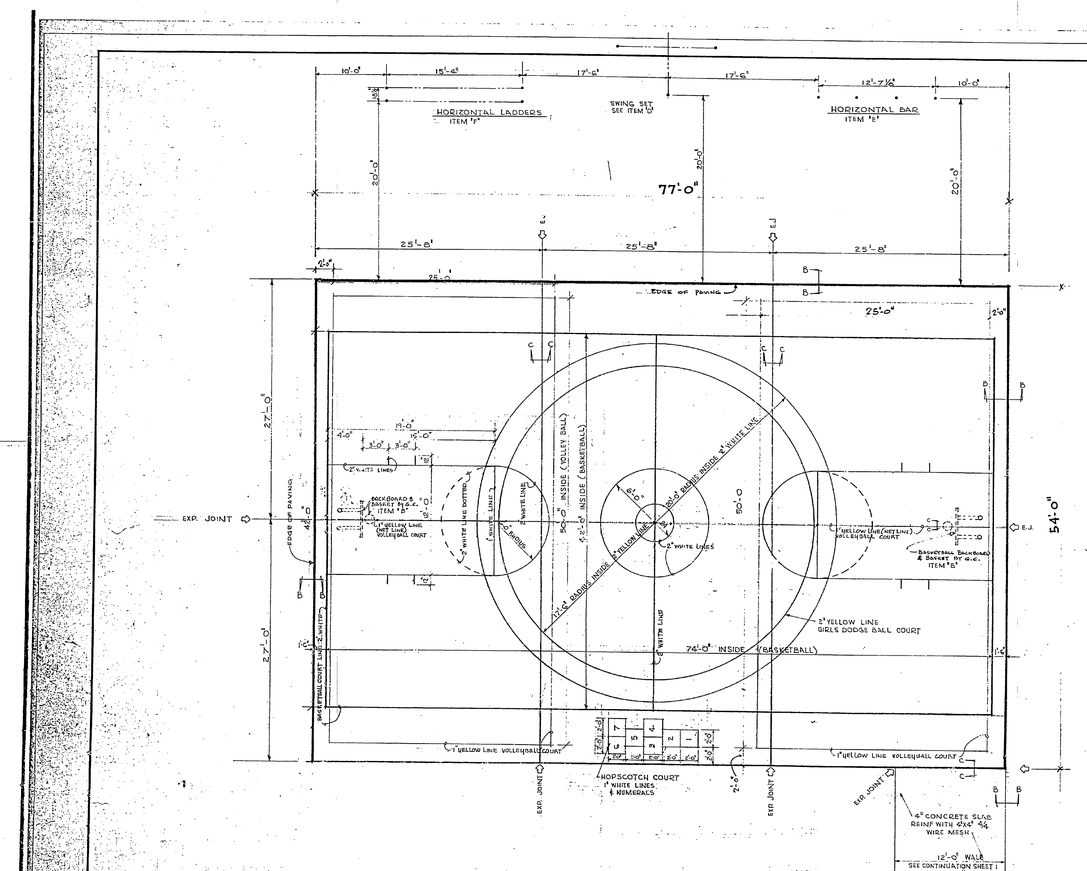

NOTE:
EXP JOINT SHALL BE ½" FLEXCELL TYPE

PLAN OUTDOOR PLAY COURT SCALE 1/16"=1'-0"
SEE SITE PLAN FOR LOCATION

R-2	REARRANGE PAINTED LINES, SHOES	10 JUNE 64	WJB
R-1	REVISED ADD DODGE BALL ETC	6 MAY 64	WJB
REVISION NO.	DESCRIPTION	DATE	BY

COURT LAYOUT & DETAILS

RECREATION - FACILITIES
ELEMENTARY SCHOOL
MARINE CORPS BASE
CAMP LEJEUNE, N.C.
PROJECT NO. 63-C-FED-2813

LESLIE N. BONEY ARCHITECT
WILMINGTON NORTH CAROLINA

SHEET 2x

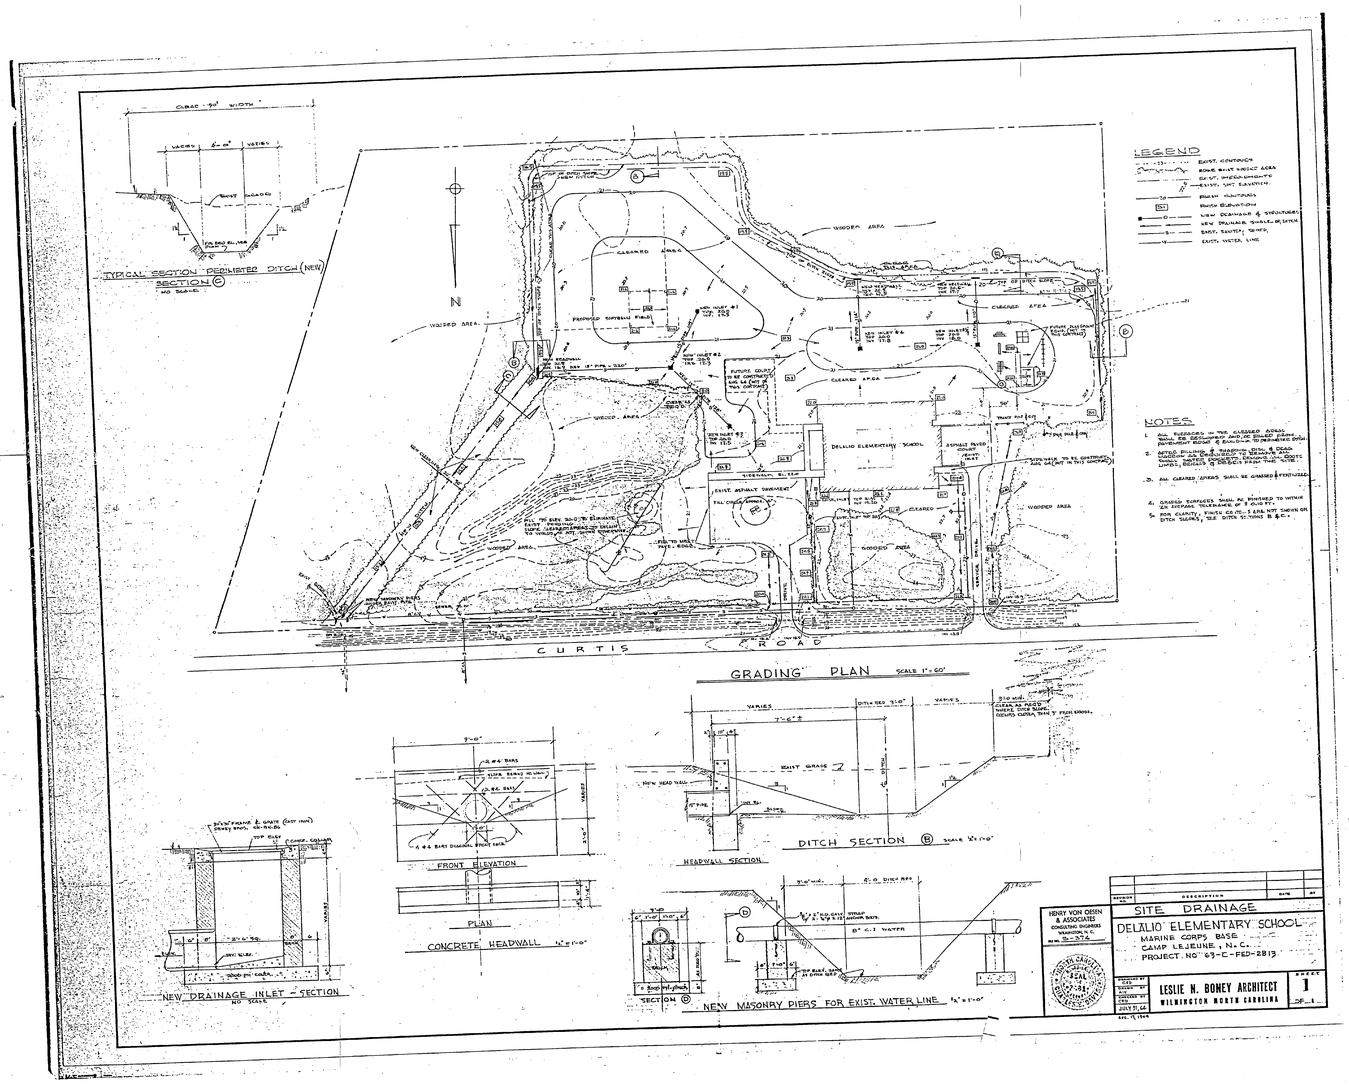

SITE DRAINAGE
DELALIO ELEMENTARY SCHOOL
MARINE CORPS BASE
CAMP LEJEUNE, N.C.
PROJECT NO. 63-C-FED-2813

HENRY VON OESEN & ASSOCIATES
CONSULTING ENGINEERS
WILMINGTON, N.C.

LESLIE N. BONEY ARCHITECT
WILMINGTON NORTH CAROLINA

SHEET 1 OF 4

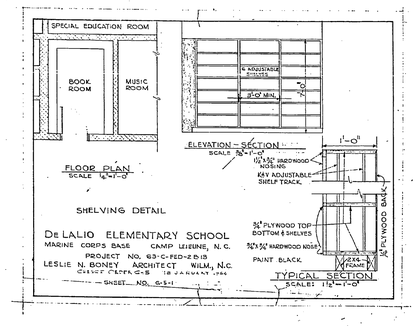

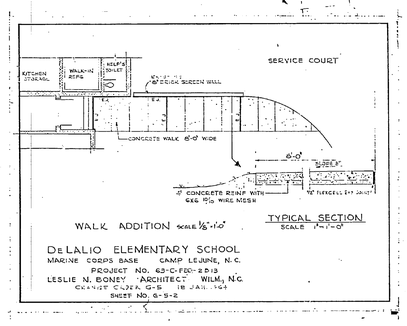

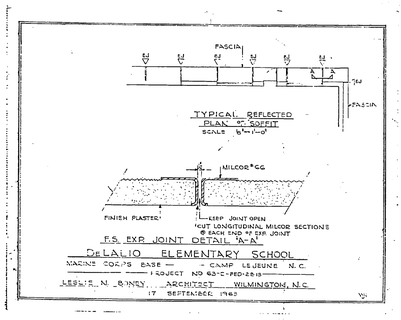

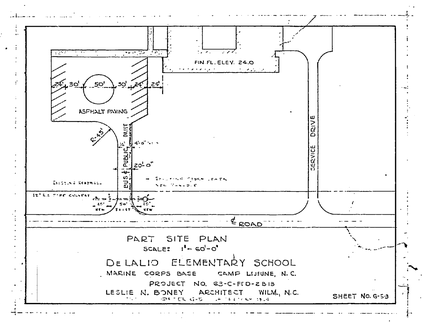

1	61 REVISIONS, ADDITIONS OF DELETIONS	SEPT 17, 65
NO.	DESCRIPTION	DATE BY

SITE PLAN & SHELVING ADDITION
RECREATION FACILITY
ELEMENTARY SCHOOL
MARINE CORP BASE
CAMP LEJEUNE, N.C.
PROJECT NO. 63-C-FED-2B13

DESIGNED BY: LNB
DRAWN BY: WEB
CHECKED BY: LNB
APPROVED BY:
DATE: 15 JAN. 65

LESLIE N. BONEY ARCHITECT
WILMINGTON NORTH CAROLINA

SHEET NO. 4x

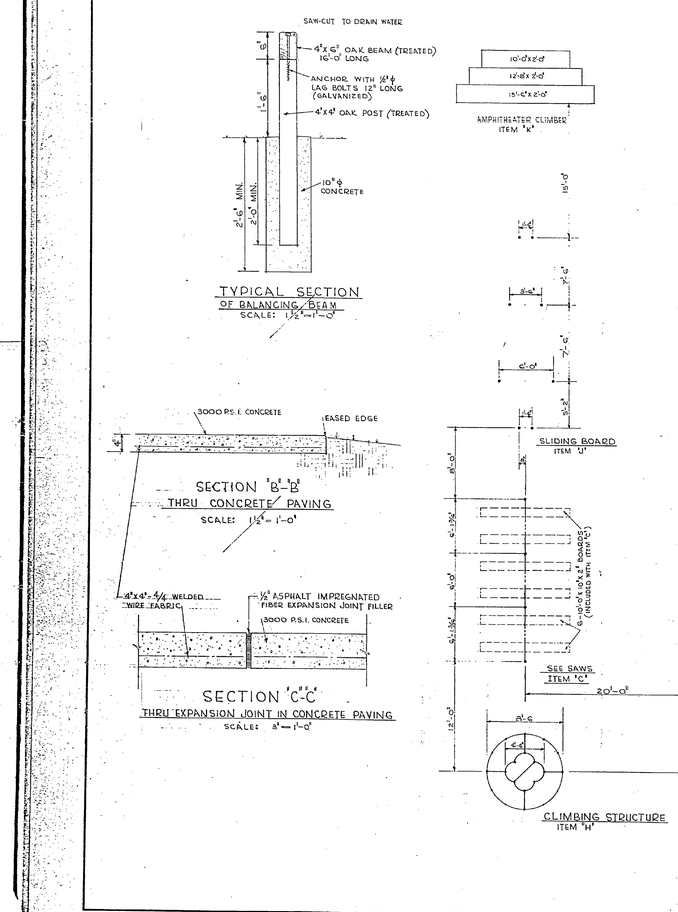

1	REARRANGE PLAY EQUIPMENT	10 JULY 66
NO.	DESCRIPTION	DATE BY

RECREATION EQUIPMENT LAYOUT
RECREATION FACILITIES
ELEMENTARY SCHOOL
MARINE CORPS BASE
CAMP LEJEUNE, N.C.
PROJECT NO. 63-C-FED-2 B13

DESIGNED BY: WEB
DRAWN BY: WEB
CHECKED BY: LNB
APPROVED BY:
DATE: 6 MAY 66

LESLIE N. BONEY ARCHITECT
WILMINGTON NORTH CAROLINA

SHEET NO. 3x

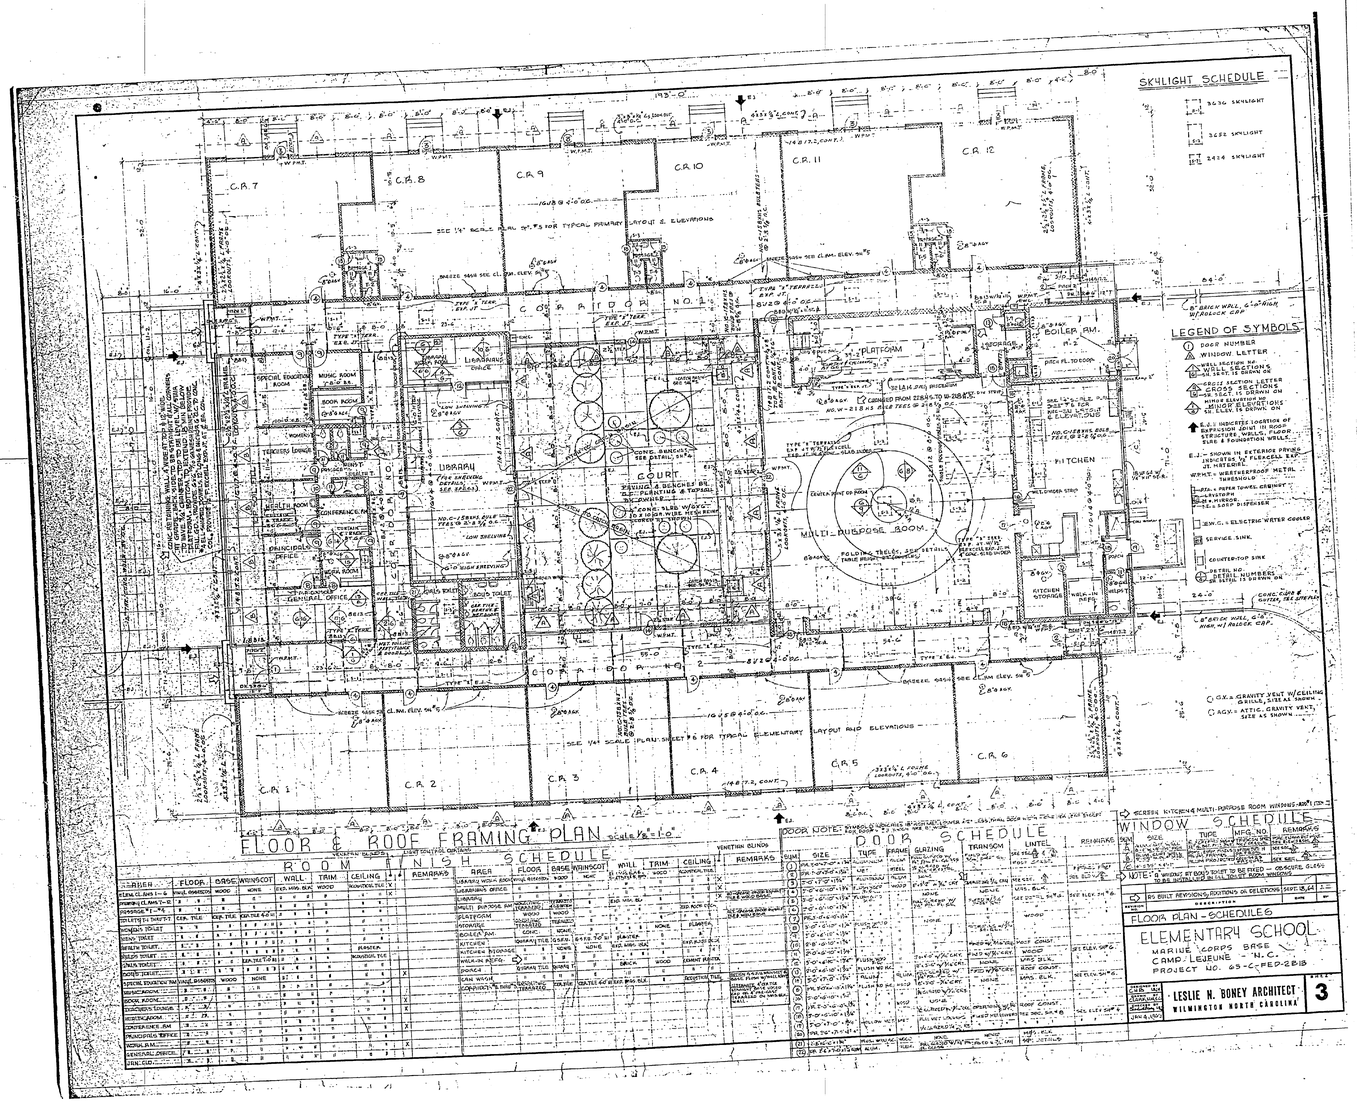
SKYLIGHT SCHEDULE
3636 SKYLIGHT
3628 SKYLIGHT
2424 SKYLIGHT
LEGEND OF SYMBOLS
DOOR NUMBER
WINDOW LETTER
WALL SECTION NO. SEE SECTIONS & DETAILS SHEET
GROSS SECTIONS
INTERIOR ELEVATIONS
E.J.- INDICATES LOCATION OF EXPANSION JOINT IN SLAB, WALLS, FLOOR, FIXTURE, ETC.
E.J.- SHOWN IN PLAN TO INDICATE EXPANSION JOINT IN FLEXIBLE BASE
W.H.T. - WATERPROOF METAL THRESHOLD
P.T.D. - PAPER TOWEL DISPENSER
M.M. - MIRROR
S.S.D. - SOAP DISPENSER
E.W.C. - ELECTRIC WATER COOLER
SERVICE SINK
COUNTER-TOP SINK
EXTRA NO. OR LETTER NUMBERS OR LETTERS IS SHOWN ON
C.G.V. - GRAVITY VENT W/CEILING GRILLE, SIZE AS SHOWN
C.A.G.V. - ATTIC GRAVITY VENT, SIZE AS SHOWN
C.R. 1
C.R. 2
C.R. 3
C.R. 4
C.R. 5
C.R. 6
C.R. 7
C.R. 8
C.R. 9
C.R. 10
C.R. 11
C.R. 12
CORRIDOR NO. 1
CORRIDOR NO. 2
COURT
LIBRARY
MULTI-PURPOSE ROOM
PLATFORM
KITCHEN
BOILER RM. NO. 2
SPECIAL EDUCATION ROOM
MUSIC ROOM
BOOK ROOM
TEACHERS LOUNGE
CONFERENCE RM.
PRINCIPALS OFFICE
GENERAL OFFICE
GIRLS TOILET
BOYS TOILET
KITCHEN STORAGE
FLOOR & ROOF FRAMING PLAN scale 1/8"=1'-0"
ROOM FINISH SCHEDULE
DOOR SCHEDULE
DOOR NOTE:
WINDOW SCHEDULE
FLOOR PLAN - SCHEDULES
ELEMENTARY SCHOOL
MARINE CORPS BASE
CAMP LEJEUNE - N.C.
PROJECT NO. 63-C-FED-2818
LESLIE N. BONEY ARCHITECT
WILMINGTON NORTH CAROLINA
3

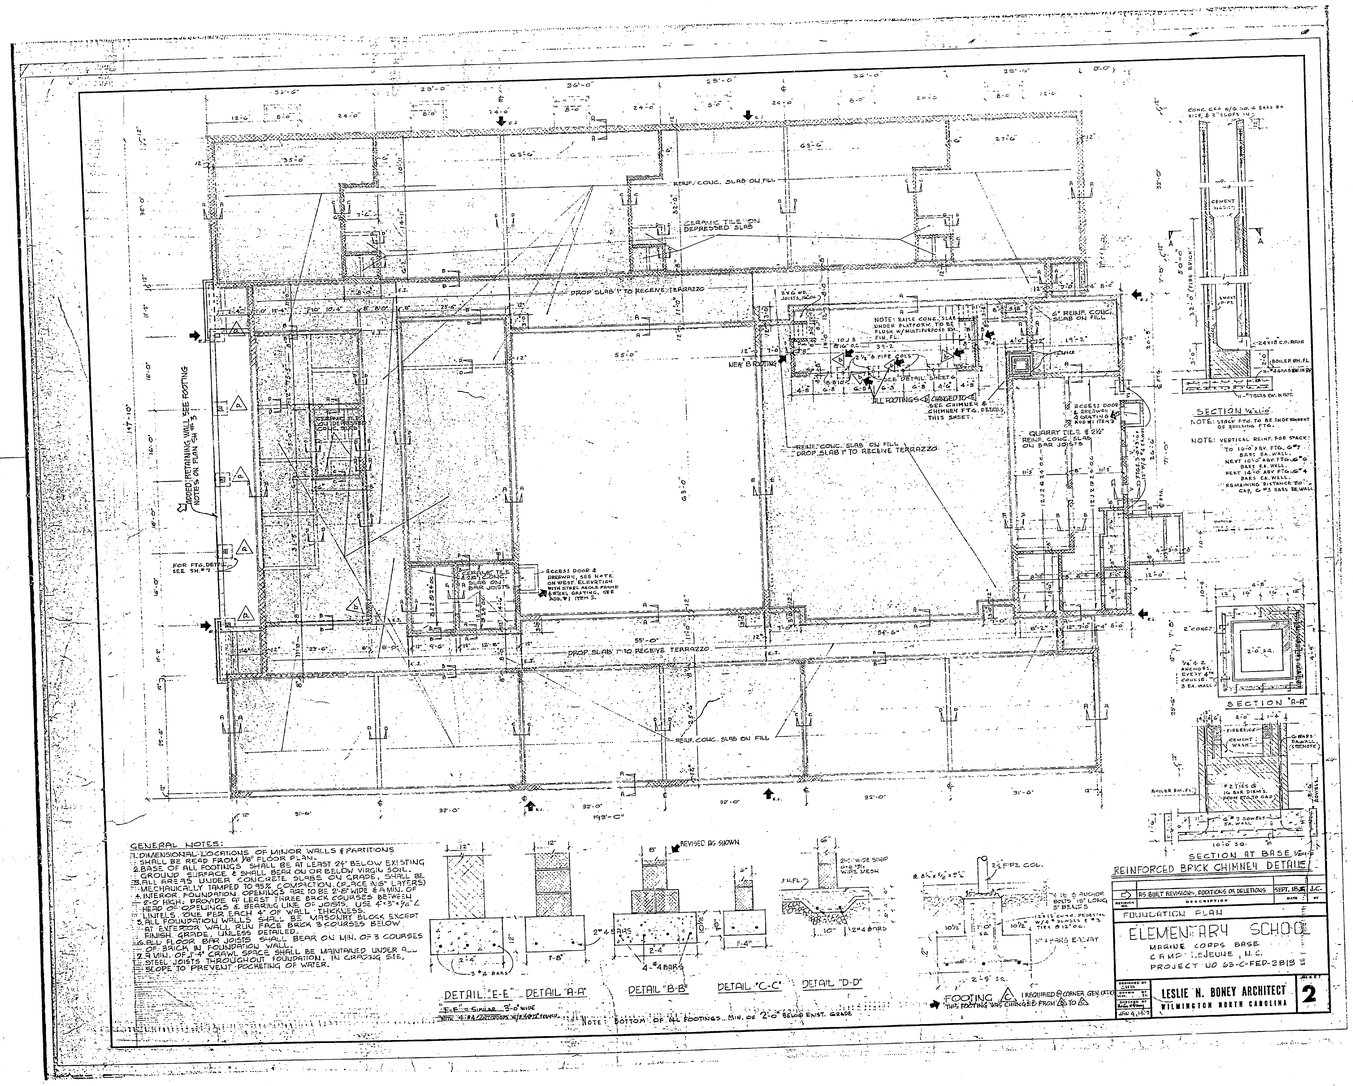
REINF. CONC. SLAB ON FILL
CERAMIC TILE ON DEPRESSED SLAB
DROP SLAB 1" TO RECEIVE TERRAZZO
NEW BRACING
ALL FOOTINGS
SEE CHIMNEY & CHIMNEY FTG. DETAILS THIS SHEET.
ACCESS DOOR & GROUND, SEE NOTE 3, SHEET 1 OF 2 SHEETS
QUARRY TILE & COVE REINF. CONC. SLAB ON BAR JOISTS
CONC. CAP W/O NO. 4 BARS EA. SIDE, 2" SLOPE TO
CEMENT WASH
CRAWL SPACE
BOILER RM. FL.
SECTION "X-X"
NOTE: STEAM PIPE TO BE SUSPENDED 12" BELOW FTG.
NOTE: VERTICAL REINF. FOR STACK: TO 10'-0" EX. FTG. 6-#5 BARS EA. WALL. NEXT 10'-0" AND FTG. 6-#5 BARS EA. WALL. NEXT 10'-0" ABV. FTG. 6-#5 BARS EA. WALL. REMAINING HEIGHT TO TOP CAP, 6-#5 BARS EA. WALL
SECTION "A-A"
SECTION AT BASE
REINFORCED BRICK CHIMNEY DETAILS
GENERAL NOTES:
1. DIMENSIONAL LOCATIONS OF MINOR WALLS & PARTITIONS SHALL BE READ FROM 1st FLOOR PLAN.
2. BASE OF ALL FOOTINGS SHALL BE AT LEAST 2'6" BELOW EXISTING GROUND SURFACE & SHALL BEAR ON OR BELOW VIRGIN SOIL.
3. ALL AREAS UNDER CONCRETE SLABS ON GRADE, (EXCEPT FILLED AREAS) MECHANICALLY TAMPED TO 95% COMPACTION, OR ADEQUATELY COMPACTED BY NATURAL MEANS.
4. INTERIOR FOUNDATION OPENINGS TO BE 2'-8" WIDE & 6" MIN. OF 6'-0" HIGH. PROVIDE AT LEAST THREE BRICK COURSES DETAILED AT TOP OF OPENINGS & BEARING LINE OF WOOD SILL.
5. ALL FOUNDATION WALLS FACED WITH 4" VENEER OF 3 COURSES BELOW FINISH GRADE, UNLESS DETAILED.
6. ALL FLOOR BAR JOISTS SHALL BEAR ON MIN. OF 3 COURSES OF BRICK IN FOUNDATION WALL.
7. 9 MIN. OF 7'-6" CRAWL SPACE SHALL BE MAINTAINED UNDER ALL STEEL JOISTS THROUGHOUT FOUNDATION, IN GRADING SITE, SLOPE TO PREVENT POCKETING OF WATER.
DETAIL "E-E"
DETAIL "A-A"
DETAIL "B-B"
DETAIL "C-C"
DETAIL "D-D"
FOOTING
FOUNDATION PLAN
ELEMENTARY SCHOOL
MARINE CORPS BASE
CAMP LEJEUNE, N.C.
PROJECT NO. 63-C-FED-2818
LESLIE N. BONEY ARCHITECT
WILMINGTON NORTH CAROLINA
2

ELEV. scale ¼"-1'-0"

ELEV. scale ¼"-1'-0"

ELEV. scale ¼"-1'-0"

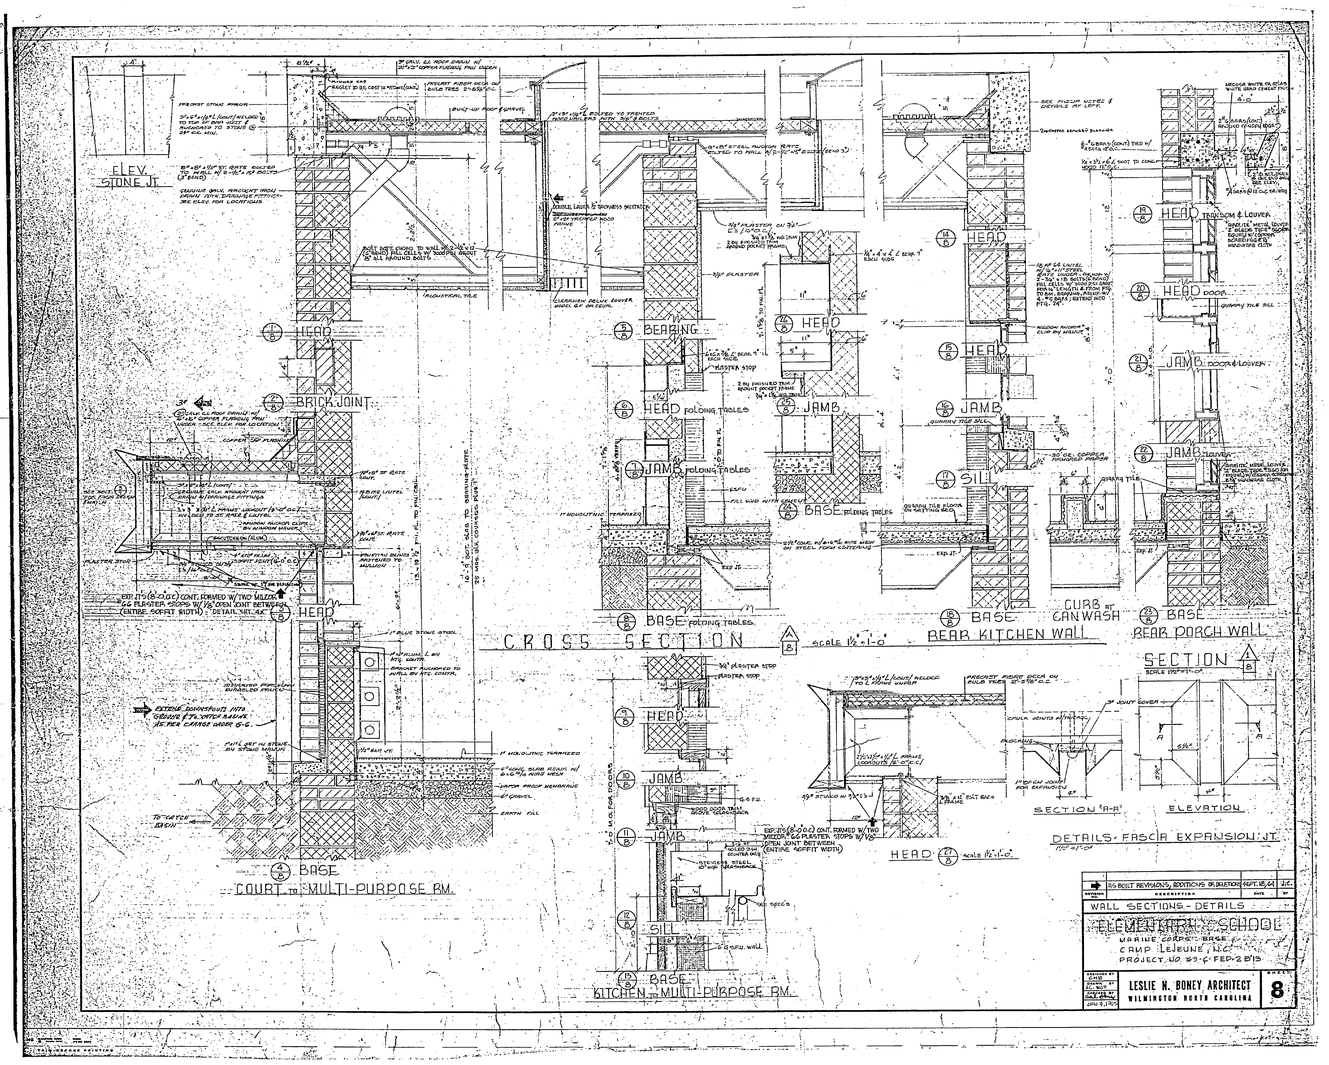
ELEV. STONE JT.
HEAD
BRICK JOINT
HEAD
BASE
COURT to MULTI-PURPOSE RM.
CROSS SECTION
scale 1½"-1'-0"
BEARING
HEAD folding tables
JAMB folding tables
BASE folding tables
HEAD
JAMB
BASE
KITCHEN to MULTI-PURPOSE RM.
HEAD
JAMB
SILL
BASE
REAR KITCHEN WALL
CURB at CANWASH
HEAD
JAMB
SILL
BASE
REAR PORCH WALL
HEAD
TRANSOM & LOUVER
HEAD DOOR
JAMB DOOR & LOUVER
JAMB louver
BASE
SECTION
SECTION "A-A"
ELEVATION
HEAD
DETAILS: FASCIA EXPANSION JT.
DESCRIPTION
WALL SECTIONS - DETAILS
ELEMENTARY SCHOOL
MARINE CORPS BASE
CAMP LEJEUNE, N.C.
PROJECT NO. 53-C-FED-2813
LESLIE N. BONEY ARCHITECT
WILMINGTON NORTH CAROLINA
8

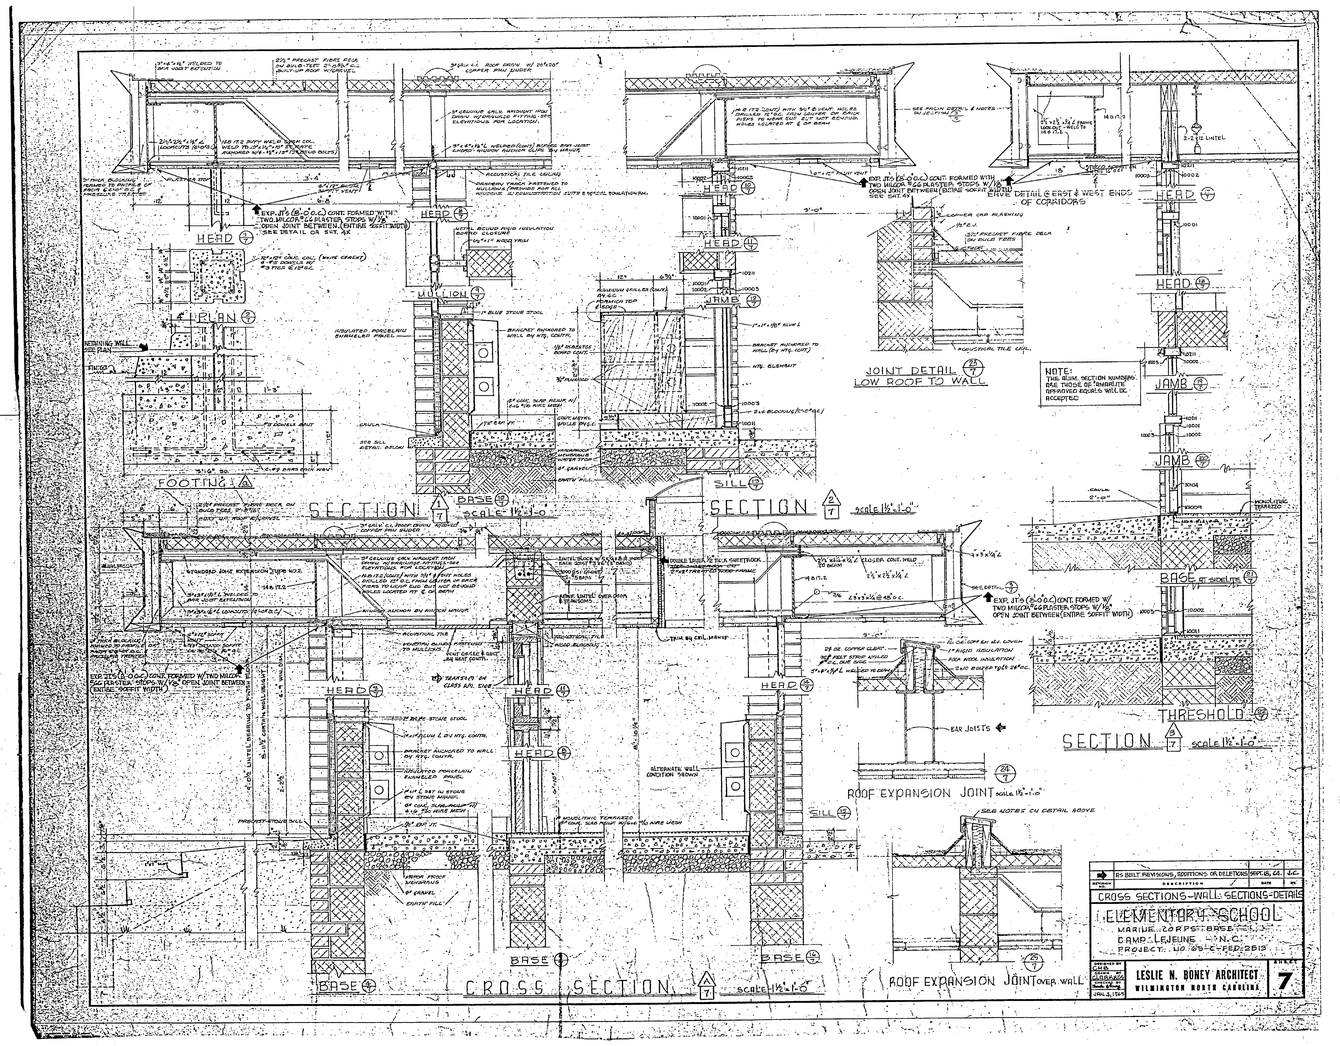
HEAD
JAMB
MULLION
SILL
BASE
PLAN
FOOTING
SECTION
scale 1½"-1'-0"
SECTION
scale 1½"-1'-0"
CROSS SECTION
scale 1½"-1'-0"
JOINT DETAIL LOW ROOF TO WALL
NOTE:
THIS BLOCK SECTION NUMBERS ARE THOSE OF TRIMBLETE REINFORCED EQUALS WILL BE ACCEPTED
EAR JOISTS
ROOF EXPANSION JOINT scale 1½"-1'-0"
ROOF EXPANSION JOINT over WALL
THRESHOLD
SECTION
scale 1½"-1'-0"
WALL SECTIONS-DETAILS
ELEMENTARY SCHOOL
MARINE CORPS BASE
CAMP LEJEUNE, N.C.
PROJECT NO. 53-C-FED-2813
LESLIE N. BONEY ARCHITECT
WILMINGTON NORTH CAROLINA
7

FIXTURE SCHEDULE

TYPE	LAMP & WATTS	DESCRIPTION	MANUF.	CAT. NO.	OPTIONS
A	300 W. GE 'NOV' INCAND. SOND.	GYMNASTIC RING UNIT ALUMINUM CONSTRUCTION - SWIVEL PENDANT	KUEST VEEREN	36555	WITH CLEVIS
B	UP TO 1-500 W. 1P 7-100 3-75	PRISM TYPE RAILROAD TYPE - GATED CLEVIS OR SPRING INSULATED HANGER HEAD STYLE	LIGHTOLIER CRYLING	670 1 670 3	PENDANT WITH CLEVIS
C	100 W. R. 30	CEILING UNIT WITH GLOBE - CAST ALUM. CONST.	PRESCOLITE	CP-2	-
D	100-150-200 W.	GLASS REFLECTOR PENDANT MOUNTED ON RAIL ALUMIN. CONST. - SATIN FINISH 8'-0" OR AS NOTED	BENJAMIN SIGNLITE	V 5081 80 S 150	ROLLER GUARD
E	100 - W.	KELLER PORCELAIN LAMP HOLDER	KELLEY	9220	~
F	100 W.	VALVE TIGHT UNIT WITH GLOBE AND GUARD - UNIT MOUNTED IN RAISED WOOD	CROUSE HINDS	VTR4 LW4	INSPECTION
G	300 W. See Sht. 2	RECESSED SQUARE ZUC. UNIT - FILE WIRED WITH OPALESCENT OPAL GLASS DIFFUSER.	KRAUN	1515 B	PAYSPHONE LIGHTING
H	150 W. or 300 W.	GASKET LIGHT WITH EXCEPTIONS GLASS SHIELD	P & H	AL 33279	~
J	150 W. R 30	"HIGH" EXCESS. INC. SOCKET WITH OPAL GLASS DIFFUSER. 1 PREWIRED	LIGHTOLIER C&M	7765 7710	~
K	75 W. R 30 FLOOD LAMP	RECESSED ADJ. FLOOD WITH 9" DIA. LOUVER AND 11" DIA. TRIM RING. LENS 'S' EACH IN 250 MARBLE BLUE	SMITHLITE	1514	~
L	2-150 W. PAR 38 FLOOD LAMPS	OPEN TYPE FLOOD LIGHT - GROUND MOUNTED ON 24" x 24" CONCRETE PAD - CONSISTING OF PLATE GLUTEN, FITTING AND 2 LAMP HOLDERS	STONCO SMITH "LUMEN"	39-S-333 HOLDERS 95-306	~
M	8-60 W. R16 PAR FLOOD LAMPS 1-60 W. INCAND. A 19 CLEAR	LOUVERED RAIN TIGHT FLUORESCENT UNIT - PENDANT MTD. ON 12 GAGE STEMS, METAL SHADES, LAMPS, BALLASTS, ETC. AS SHOWN ON DRAWINGS AND SPECS.	CRESCENT LUMEN	MILLTEC 48 LP 8	~
N	1-60 W. INCAND. A 19 CLEAR 1-15 W. PAR 38 FLOOD	LOUVERED RECESSED FLUORESCENT UNIT - ACRYLIC PLASTIC DIFFUSER.	LPI	1164 A	KELLER CORPORATION
P	2-150 PAR 38 FLOOD LAMPS	CYLINDER WALL BRACKET - UP AND DOWN - FOR LARGE AREAS WITH WEATHER PROOF SOCKETS - FOR OUTDOOR USE	PRESCOLITE	WB-1013 WHITED	~

(A) PRESCOLITE 'CEILING MOUNTED' RED GLASS INCAND. REFLECTOR. P.S.- 231 (NOW OUT ITEM)

(B) CLEAR GLASS 'WALL MOUNTED' 1-60 INCAND UNITS ... PRESCOLITE P.S.- 241

(C) 'RUSTICRAFT' WALL BRACKET - 2-26 W. IF ... P.S.- 161

CHANGED TO 20" BY CHANGE ORDER #3, ITEM 6

6'-0" - 6'-6"

CONSUMERS ELEV. DETAIL
NO SCALE

CONSUMERS TO OBTAIN (APPROX. RATE)
PANEL ON ADJOIN. SIVA. CONCRETE
SET NO. 4 C.O. PLUG, SCREW PANEL AND BOX
(2) 4" RIGID CONDUIT, WITH BUSHINGS
(1) 3/4" GALVANIZED IRON PIPE
CONNECTION FOR SEC. AS DIRECTED
(2) BOOSTER MTR. MAG. SW. 3/4 PLUG. ROUTE.

PANEL 'K' SCHEDULE — 400A 3Ø4W 120/208 MAIN LUGS

#P	#B	#C	CIRCUIT	AMPS	POLES	VOLTS	WIRE	CONDUIT	FEEDS
Con	150	~	1-3	30	1	120	#12-3/4	3/4"	LIGHTS IN KITCHEN ETC.
Con	~	~	5	30	1		~	~	SPARE
~	150	~	7-9	30	1		~	~	LIGHT & FAN IN WALL IN CHILD
~	~	400	5	20	1		~	~	LIGHTS IN SERVICE YARD
~	~	150	11	20	1		~	~	RECEPTACLE FOR MISC. USAGE
~	500	150	13-15	30	2		#10-3/4	3/4"	RECEPTACLES - CK AND SERVE
Con	~	~	17	20	1		~	~	" " " "
~	~	400	19-21	30	2		#10-3/4	3/4"	RECEPTACLES - MULTIPURPOSE
Con	~	~	23	20	1		~	~	" " " "
500	~	~	25-27	30	2		#10-3/4	3/4"	2 - 3Ø 60 AMP TIME CLOCK HEATERS
Con	~	~	29	20	1		~	~	& RECEPT. - H+D + CONSERVE
~	~	400	31-33	30	2		#12-3/4	3/4"	SPARE
~	~	~	35	20	1		~	~	"
~	~	150	37-39	30	2		~	~	"
~	~	~	41	20	1		~	~	"
~	~	~	43	20	1		~	~	"
500	~	~	45-47	30	2		#10-3/4	3/4"	SPARE
~	~	~	49	20	1		~	~	"
~	~	~	51	20	1		~	~	"
~	~	~	53	20	1		~	~	"
5.4	5.3	3.6	1						

PANEL 'K' TO HAVE 6" GUTTERS
4-1661, TOP + BOTTOM

ANTENNA ON ROOF SEE NOTE 1 SHEET 10

1" C. WITH LEAD IN WIRE

2'-6" x 2'-6" FLUSH JUNC. BOX WITH 3 EA. KNOCK-OUTS, GRADE 'E' RUBBED RING IN TOP SECTION.

2'-6"x2'-6" WITH HOOD BACK&SIDE

PENROSE CINCH JONES BARRIER TYPE RECESSED RECEPTS IN ALL SOUND CHAMBERS

SOUND SYSTEM DIAGRAM
NO SCALE

PANEL 'A' SCHEDULE — 100A 3Ø4W 120/208 M.L.O. TO 100A

#	#B	#C	CIRCUIT	AMPS	POLES	VOLTS	WIRE	CONDUIT	FEEDS
Con	150	~	1-3	20	1	120	#12-3/4	3/4"	LIGHTS IN MULTIPURPOSE
Con	150	~	2-4	20	1	120	~	~	" "
150	~	~	6-7	20	1		~	~	SPARE
~	400	150	6-7	20	1		~	~	LIGHTS - CLASS ROOM 1
~	~	400	8	20	1		~	~	CL. RM. 2 &
~	500	~	10	20	1		~	~	SPARE FEMALE
~	150	150	12-14	30	2		#10-3/4	3/4"	RECEPTACLES - CK AND SERVE
~	150	150	16-18	30	2		#10-3/4	3/4"	RECEPTACLES - MULTIPURPOSE
~	~	500	20-22	30	2		#10-3/4	3/4"	2 - 3Ø 60 AMP TIME CLOCK HEATERS
Con	~	~	24	20	1		~	~	& RECEPT. - H+D + CONSERVE
~	~	400	26-28	30	2		~	~	SPARE
~	~	~	30	20	1		~	~	"
~	~	~	32	20	1		~	~	"
500	~	~	34-36	30	2		~	~	"
~	~	~	38	20	1		~	~	"
~	~	~	40	20	1		~	~	"
~	~	400	42-44	30	2		~	~	SPARE
~	~	~	46	20	1		~	~	"
~	~	~	48	20	1		~	~	"
5.4	5.4	3.6	1						

PANEL 'B' SCHEDULE — 100A 3Ø4W 120/208 MAIN LUGS ONLY

#	#B	#C	CIRCUIT	AMPS	POLES	VOLTS	WIRE	CONDUIT	FEEDS
Con	Con	~	1-3	20	1	120	#12-3/4	3/4"	LIGHTS - CLASS ROOM 3
Con	Con	~	2-4	20	1		~	~	" " " "
Con	Con	~	5-7	20	1		~	~	" " " "
500	~	~	6	20	1		~	~	" " " "
~	1500	~	8-10	60	2		#8-3/4	1"	SPARE
Con	~	~	12	20	1		~	~	"
~	~	800	14-16	70	2		#6-3/4	1"	SPARE
~	~	~	18	60	2		~	~	"
~	~	~	20	60	2		~	~	"
~	~	~	22	60	2		~	~	"
5.4	5.3	3.6	1						

PANEL 'C' SCHEDULE — 100A 3Ø4W 120/208 MAIN LUGS ONLY

#	#B	#C	CIRCUIT	AMPS	POLES	VOLTS	WIRE	CONDUIT	FEEDS
Con	Con	Con	1-3-5	20	1	120	#12-3/4	3/4"	LIGHTS - CLASS ROOM 2
Con	Con	Con	2-4-6	20	1		~	~	" " " "
Con	Con	Con	7-9-11	20	1		~	~	" " " "
500	~	~	8	20	1		~	~	" " " "
~	1500	~	10	60	2		~	~	" " " "
~	~	800	12-14	70	2		#6-3/4	1"	SPARE
~	~	~	16	60	2		~	~	"
~	~	~	18	60	2		~	~	"
~	~	~	20	60	2		~	~	"
5.4	5.3	3.6	1						

PANEL 'D' SCHEDULE — 100A 3Ø4W 120/208 MAIN LUGS ONLY

#	#B	#C	CIRCUIT	AMPS	POLES	VOLTS	WIRE	CONDUIT	FEEDS
Con	Con	Con	1-3-5	20	1	120	#12-3/4	3/4"	LIGHTS - CLASS ROOM 4
Con	Con	Con	2-4-6	20	1		~	~	" " " "
Con	Con	Con	7-9-11	20	1		~	~	" " " "
500	~	~	8	20	1		~	~	" " " "
~	1500	~	10	20	1		~	~	LIBR. MAIN ROOM
Con	~	Con	12-14	20	1		#12-3/4	3/4"	LIBRARY
~	~	800	16	70	2		#6-3/4	1"	& LIBRARY, MAIN, RM. RMS.
Con	~	~	18	20	1		~	~	RECEPTACLES - CK. 1-2-3
~	150	~	19	20	1		~	~	" " " "
~	Con	~	21	20	1		~	~	4 - IN LIBR. ETC.
~	500	Con	23	30	3	2x2	~	~	5 - WALL SOUND MATER. CHILDREN
Con	Con	Con	24	20	1		~	~	SPARE
Con	Con	Con	26	20	1		~	~	"
~	300	~	27	20	1		2#12-3/4	3/4"	HEATING UNIT
50	Con	Con	28	30	3	2x2	~	~	SPARE
5.4	6.9	3.6	1						

PANEL 'BR' SCHEDULE — 100A 3Ø4W 120/208 MAIN LUGS ONLY

#	#B	#C	CIRCUIT	AMPS	POLES	VOLTS	WIRE	CONDUIT	FEEDS
Con	~	~	1	10	1	120	#14-3/4	~	RECEPT. RM. 3,4
Con	~	~	3	20	1	120	~	~	RECEPT. RM. 4 & 5R.
Con	~	~	5	20	1	120	~	~	ATTIC CONTROLS
150	~	~	6	20	1		~	~	TIME SW. FOR ZONE CONTROLS
~	500	~	8	20	1		~	~	CIRCULATING CONTROL AT WATER
~	150	~	9	20	1		~	~	RECEPT. LINE
1 HP	~	~	10	20	1		~	~	CIRCULATOR - ZONE 1 - IN AT
~	1 HP	~	12	20	1		1/14 TO WIRE	~	" " 2 "
~	~	500	14	20	1		GUTTER	~	" " 3 "
Con	~	~	16	20	1		~	~	" " 4 "
~	500	~	18	30	2		#8 U.G.	~	SPARES IN PIL BUREAU
~	~	800	20	50	2		~	~	" " " "
Con	Con	Con	22	20	1		~	~	MIL SILENCER, AM SPARE
Con	Con	Con	24	20	1		~	~	SPARE
~	~	~	~	~	~	~	~	~	~
~	~	~	~	~	~	~	~	~	~
5.4	7.6	3.6	1						

PANEL 'O' SCHEDULE — 100A 3Ø4W 120/208 MAIN LUGS ONLY

#	#B	#C	CIRCUIT	AMPS	POLES	VOLTS	WIRE	CONDUIT	FEEDS
Con	~	~	1	20	1	120	~	~	SPARE
~	750	~	3	30	2		#10-3/4	3/4"	LIGHTS - SERV. AREA
~	~	300	5	30	2		~	~	+ TENANTS @ 2HP FAN
~	500	~	7	20	1		~	~	OVER DOOR
~	~	1200	9	20	1		#10-3/4	3/4"	" " "
~	~	~	11	20	1		#10-3/4	3/4"	" " "
800	~	~	13	50	2		~	~	PO OFFICE
~	~	500	15	50	2		#8-3/4	1"	GARAGE DOOR OPENER, 2 HP MO.
~	500	~	17	20	1		#12-3/4	3/4"	" " " "
~	~	500	19	20	1		~	~	" " " "
1200	~	~	21	50	2		#8-3/4	1"	SOUND CONSOLE
~	500	~	23-25	30	2		#10-3/4	3/4"	5 RECEPT. IN MAIN. OFF.
1200	~	~	27	50	2		#8-3/4	1"	RECEPT. OFFICES
~	500	~	29-31-33	30	2		~	~	SPARES - INTERIOR USE
~	~	1200	35	50	2		#6-3/4	1"	SPARES - EXTERIOR USE
~	~	~	37	50	2		#6-3/4	1"	15 HP CABINET HEATER,
~	~	~	39	50	2		~	~	15 HP
~	~	~	41	50	2		~	~	SPARE
6.5	4.3	6.8	~	~	~	~	~	~	~

PANEL 'K' END TO HAVE 6" GUTTERS
4-1661, TOP + BOTTOM

PANEL 'MD'

To be located in Electrical Equipment Room No. 1 on Ground Floor
Bolted Type, 600V, Main Circuit Breaker

CIRCUIT	AMPS	POLES	VOLTS	WIRE & CONDUIT	FEEDS	REMARKS
1	90	3	208	4#3 - 1½"	PANEL G	15 C
3	90	3		4#3 - 1½"		15 C
5	90	3		4#3 - 1½"	B	17 C
7	90	3		4#3 - 1½"	A	17 C
9	90	3		4#3 - 1½"	D	19 C
11	90	3		4#3 - 1½"	BR	19 C
13	200	3		4-3pc MCM-3"	K	10 C
15	150	3		2"EC	SPACE ONLY	20
17	150	3		2"EC	SPACE ONLY	20
				GRAND TOTAL	245 C	

MAIN SERVICE - 1600 AMP 120/208 VOLTS, 3Ø, 4 WIRE CONSISTING OF 3-#750 CONDUITS EACH CIRCUIT TO HAVE 3-#500 MCM CUPR AND 1-#350 CUPR GROUND IN 4" CONDUIT TO INSIDE & CONCRETE ENCASED THROUGHOUT

MAINS FROM ST. REGIS ALUMINUM SALES SERVICE

MAIN SERVICE GROUND

NOTE: THIS PANEL TO HAVE 6" WIRE GUTTERS ALL SIDES - TOP & BOT.

PANEL 'EM' - INDUSTRIAL TYPE MAIN LUGS ONLY
ENTRANCE LIGHTS & 2, SPARES - TO HAVE PHASE COVER & LABEL ETC.

4'-5" W. x 18" H. - TERMINAL CAB. - THE STATE CONTROLS ELECTRONIC TUNER, A.C. INSTALLATION ALSO - 1 PARAGON 2 SEAT TIME SWITCH FOR FRONT FLOOD LIGHTS.

TO EXISTING FAN

TO EXISTING SWITCH

TO LAND FLOOD LIGHT

#10 - 3/4"

#6 - 1"

#4 - 1"

#2 - 1"

#1/0 - 1½"

#2/0 - 1½"

#3/0 - 1½"

#4/0 - 2"

250 MCM - 2"

350 MCM - 2½"

500 MCM - 3"

750 MCM - 3½"

1000 MCM - 4"

SERVICE RISER DIAGRAM
NO SCALE

ITEM — DESCRIPTION

1 HOT LINE CLAMP
2 DEAD END SHOE
3 SUSPENSION INSULATOR (10"- 2 PER STRING
4 CROSS ARM, 10'6"x 4"x 4" OAK
5 CEILING PINS, TIMBER 8"x6"x 18-0"
6 DOUBLE ARMING BOLT 16" x RDHD LENGTH
7 BOLT EYE TYPE, GUY ATTACHMENT
8 GROUND CLAMP - COPPER RODS TO STEEL STRAND
9 STEEL ANGLE BRACE 11'2" x 1½" x 1½" x 160" SPREAD
10 SHEPHERD HOOK 5/8" WITH NUT & WASHERS
11 36" C TO MESSENGER EQUIPMENT
12 LIGHTNING ARRESTOR AS SPECIFIED
13 FUSE CUTOUT AS SPECIFIED
14 15'-6" X 27" PLAT MARKER
15 HEAVY DUTY SECONDARY RACK
16 TRANSFORMERS GROUND 750 BASE 3Ø, 4W
17 TELEPHONE EQUIPMENT; SEE NOTE 7 SHT 9.

TRANSFORMER BANK DETAILS
NO SCALE

PANEL 'MD' ONE LINE DIAGRAM

1	AS BUILT REVISIONS	SEPT. 18, G4
REVISION	DESCRIPTION	DATE

ELECTRICAL - DETAILS

ELEMENTARY SCHOOL
MARINE CORPS BASE
CAMP LEJEUNE, N.C.
PROJECT NO 63-C-FED-2813

DESIGNED BY: LESLIE N. BONEY ARCHITECT
WILMINGTON NORTH CAROLINA

SHEET 10 OF 17 SHEETS

WILLIAM S. LASAR
REGISTERED
ENGINEER
N.C. REG. NO. 1051
JOB NO. 653
DATE: JAN 65
SHT. NO. E-1 OF 2

GENERAL NOTES

- COLOR CODE ALL WIRING BLACK - RED - BLUE (WHITE FOR NEUTRAL).
- NAME ALL PANELS - FILL OUT SCHEDULES CORRECTLY AND COMPLETELY.
- BOND ALL GROUND RECEPTACLES USING A STEEL CITY GROUND CLIP + GREEN WIRE.
- RUN 3 - 3/4" EMPTY CONDUITS FROM EACH FLUSH PANEL TO SPACE ABOVE CEILING.
- COORDINATE WORK WITH MECHANICAL AND ARCHITECTURAL PLANS - DO NOT INSTALL OUTLETS BEHIND RADIATORS.
- CONDUIT GROUNDS - TAPES SHALL NOT BE USED ON ANY WIRE SMALLER THAN #6.
- PROVIDE WIRING FOR HEATING EQUIPMENT AS SPECIFIED.
- TELEPHONE CONDUITS - RUN 1"EC FROM OUTLETS INDICATED ON PLANS TO ACCESSIBLE LOCATION IN BASEMENT OR CRAWL SPACE. RUN 3/4" FROM KITCHEN OUTLET TO CAB. "K".
- PUBLIC ADDRESS SYSTEM - CONDUITS FOR SPEAKERS: 1 EA. 3/4" EC. FROM EACH SPEAKER TO CAB. "PA", 1 EA. 3/4" EC. FROM EACH CLOCK TO CAB. "PA", 1 EA. 1" EC. FROM CAB. "PA" TO CAB. "C" FOR MICROPHONE. RUN 1" EC. FROM CAB. "PA" TO CAB. "K" FOR TELEPHONE. SEE RISER DIAGRAM ON SHT. E-2.

SPECIAL NOTES

a. Flush mount light switch and fan heater in lid of power hood. Provide 60 fan heads in each hood. See sheet 2 for details.

b. Provide power and control wiring for unit heaters, double in toil thermostat and speed switch 4' above floor.

c. 110 V. R.F. flood outlet, len mfg co. cat. no. 1415 w. flusher 4-60 cd candle needed to owner.

d. Wiring for fractional HP circulator and control.

e. Flood telephone outlet 1/2 in conduit with 50 ohm extension-leave inside pan. see this

f. Provide bunsell + stoll no. 1804 1ft floor sleeve and no. 1414 cap and blend wiring to ranges and oven using spare sized conduit, nipple and greenfield etc.

g. Flush terminal cabinet 4'-0 x 15" w. x 10" with dividers three 1-2 vent fan, switches. For heating system (not by stng. contr.) see riser diagram sht 2 & 3 notes

h. 6'-50 flush outlet 4'-0" above floor, for zone thermostat-run 3/4"-3/4" to cab. "C" to wash in shaker, see m

i. outlet for wall hung water cooler.

j. See 3 arrow & sht 2, see if instantaneous heater is needed, if so, provide 50 amp circuit

k. wiring for unit heaters - run 3/4" emt from 2 ft above floor to unit heater, 2 #12 + 1 #12 ground in 3/4" emt from unit heater to thermostat, wire and mount thermostat 4'-0" above floor, 2 #12 + 1 #12 ground in 3/4" emt from thermostat to starter

l. outlet for hot food table. provide flush box no. 4125 w. face plate, connect in table as required by mfr. spec.

m. provide 4" x 4" x 2 1/8" deep pull box with 3/4" conduit stubbed to above ceiling for future use.














C.R. 7 C.R. 8 C.R. 9 C.R. 10 C.R. 11 C.R. 12

CORRIDOR 1

SCI. ED. RM. MUSIC RM. LIBRARY CT. LIBRARY LIBRARY COURT STAGE BOILER RM. KITCHEN

TEACHERS TOILET ROOMS T. LOUNGE HEALTH RM. PRIN. OFF. WORK GENERAL OFFICE CORRIDOR 3 GIRLS BOYS MULTI PURPOSE ROOM KIT. STOR. JANITOR

CORRIDOR 2

C.R. 1 C.R. 2 C.R. 3 C.R. 4 C.R. 5 C.R. 6

FIN. FLOOR ELEV. 24.0

FLOOR PLAN
SCALE 1/8"=1'0

PLUMBING LEGEND

SOIL OR WASTE LINE
VENT LINE
COLD WATER
HOT WATER
RECIRCULATING LINE
GAS LINE
GATE VALVE
ANGLE VALVE
DIAPHRAGM VALVE
FLR. STOCK
CHECK VALVE
STRAINER
B.F. METER
FLOOR DRAIN
SHOWER DRAIN
ROOF DRAIN
AUTOMATIC FD.
VENT THRU ROOF
FLUSH VALVE
WRIST ELEVATION

PLUMBING - FLOOR PLAN

ELEMENTARY SCHOOL
MARINE CORPS BASE
CAMP LEJEUNE, N.C.
PROJECT NO 69-C-FED-2813

LESLIE N. BONEY ARCHITECT
WILMINGTON NORTH CAROLINA

12

PLOT PLAN
1"=100'-0"

LEGEND
SANITARY SEWER - NEW
VENT - COLD WATER - LINE
EXISTING MANHOLE
NEW - SANITARY MANHOLE
FIRE HYDRANT - NEW
GATE VALVE - IN CAST IRON BOX
INVERT ELEVATION

FIRE HYDRANT DETAIL
NO SCALE

POST INDICATOR VALVE - DETAIL
NO SCALE

PIPE CLAMP TEE ANCHOR

ANCHOR FOR WATER MAINS
NO SCALE

ROOF PLAN scale 1/8"=1'0"

PLUMBING - SITE PLAN & DETAILS

ELEMENTARY SCHOOL
MARINE CORPS BASE
CAMP LEJEUNE, N.C.
PROJECT NO 69-C-FED-2813

LESLIE N. BONEY ARCHITECT
WILMINGTON NORTH CAROLINA

11

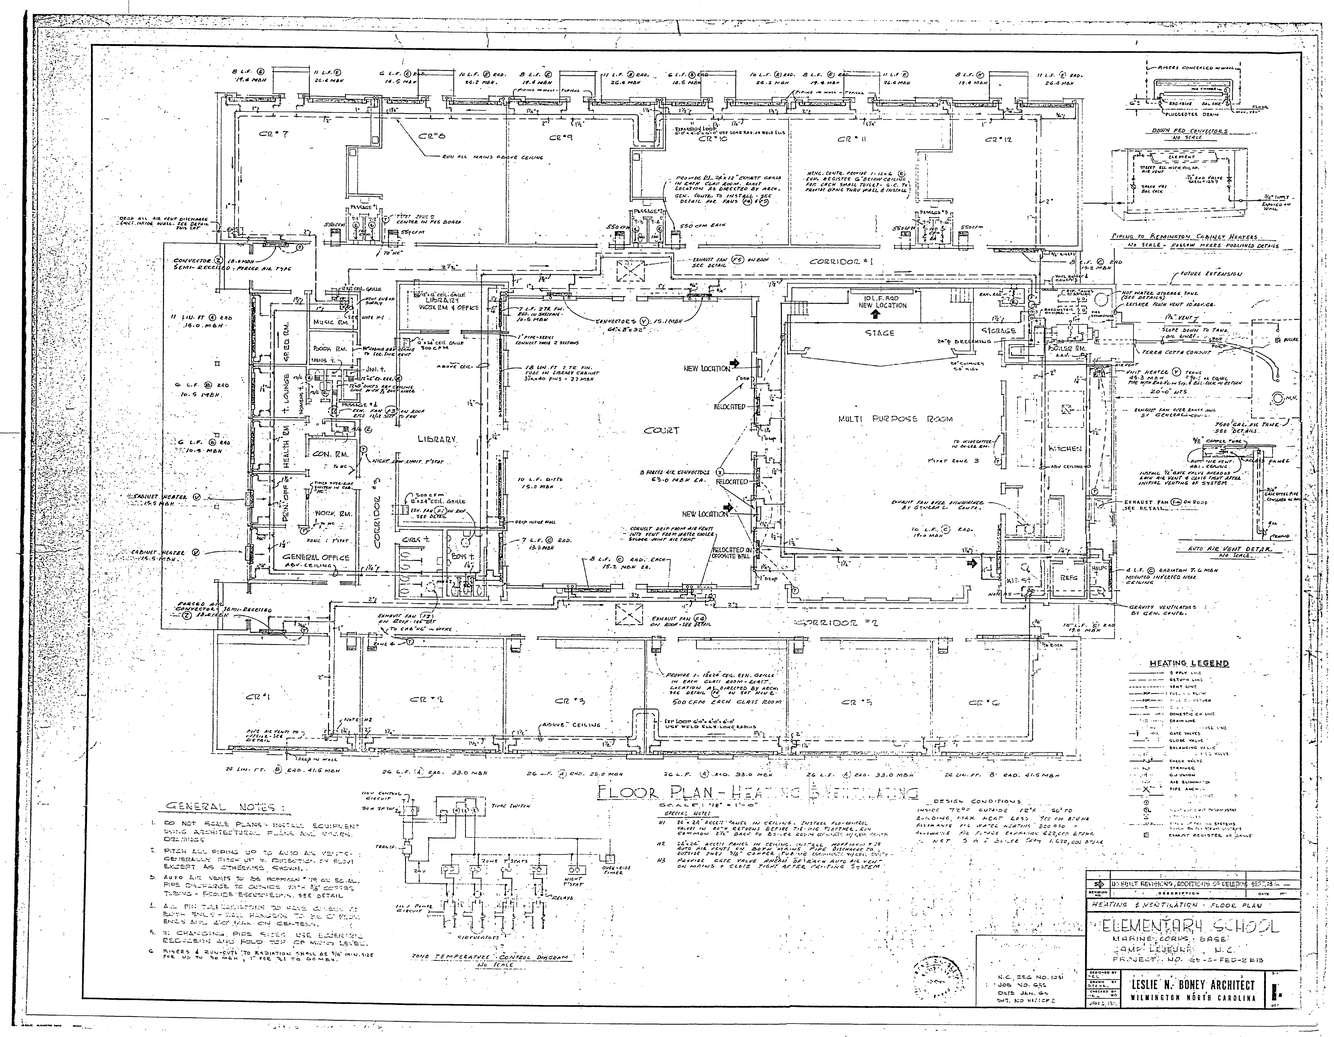
CR. 7
CR. 8
CR. 9
CR. 10
CR. 11
CR. 12
CR. 1
CR. 2
CR. 3
CR. 5
CR. 6
CORRIDOR #1
CORRIDOR #2
COURT
LIBRARY
MULTI PURPOSE ROOM
STAGE
STORAGE
KITCHEN
GENERAL OFFICE
CON. RM.
NOOK RM.
MUSIC RM.
READING RM.
TEACHERS
H. COUNSOR
HEALTH OFF.
GIRLS T.
BOYS T.
CLOS.
FLOOR PLAN - HEATING & VENTILATING
GENERAL NOTES:
1. DO NOT SCALE PLANS - INSTALL EQUIPMENT USING ARCHITECTURAL PLANS AND WORKING DRAWINGS.
2. PITCH ALL PIPING UP TO AUTO AIR VENTS - GENERALLY PITCH UP IN DIRECTION OF FLOW EXCEPT AS OTHERWISE SHOWN.
3. AUTO AIR VENTS TO BE HOFFMAN "1B OR EQUAL PIPE CONNECTIONS TO CONFORM WITH RECOMMENDATIONS OF MANUFACTURER - FLEXIBLE CONNECTIONS, SEE DETAIL.
4. ALL PIPE INSULATION TO HAVE ASJ JACKET WITH BUTT STRIP - PIPING IN TUNNELS TO BE 2" THICK AND ALL OTHER PIPING 1" THICK UNLESS OTHERWISE NOTED.
5. NO CHANGING PIPE SIZES USE ECCENTRIC REDUCERS AND HOLD TOP OR MAINS LEVEL.
6. RISERS & RUN-OUTS TO RADIATION SHALL BE 3/4" MIN. SIZE FOR NO TO 3# MBH, 1" FOR 3.1 TO 6# MBH.

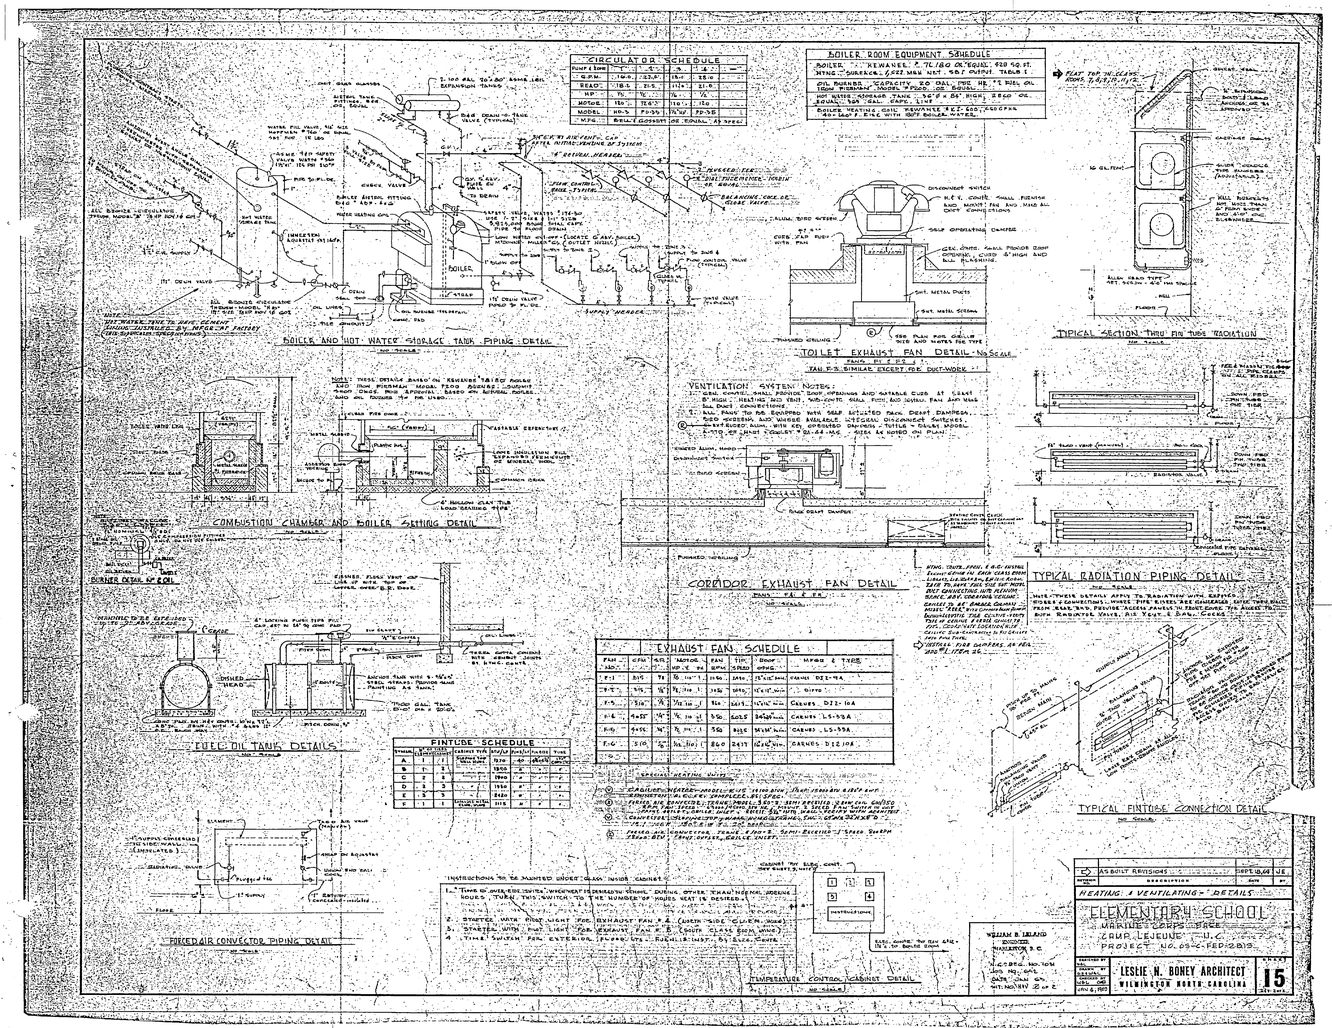
CIRCULATOR SCHEDULE
BOILER ROOM EQUIPMENT SCHEDULE
BOILER AND HOT WATER STORAGE TANK PIPING DETAIL
TOILET EXHAUST FAN DETAIL
TYPICAL SECTION THRU FIN TUBE RADIATION
COMBUSTION CHAMBER AND BOILER SETTING DETAIL
CORRIDOR EXHAUST FAN DETAIL
TYPICAL RADIATION PIPING DETAIL
FUEL OIL TANK DETAILS
EXHAUST FANS SCHEDULE
FINTUBE SCHEDULE
TYPICAL FINTUBE CONNECTION DETAIL
TEMPERATURE CONTROL CABINET DETAIL
AS BUILT REVISIONS
HEATING & VENTILATING - DETAILS
ELEMENTARY SCHOOL
MARINE CORPS BASE
CAMP LEJEUNE, N.C.
PROJECT NO. 65-C-FED-2819
LESLIE N. BONEY ARCHITECT
WILMINGTON NORTH CAROLINA
15